




- Active Sewer Manhole - Abandoned Sewer Manhole - Sewer Connection - Other Features - Wet Well - Pump Station - Other Fittings - Bend fitting - Tee Wye; Tee fitting; Wye fitting - Cap fitting - Clear-out fitting	- Chimney fitting - Reducer - Sewer Lateral - Gravty Sewage Main - Forced Sewage Main - Abandoned Gravty Sewage Main - Abandoned Forced Sewage Main - Concrete Encasement - Steel Sleeve - DI Sleeve - Catch Basin	- Undigitized Catch Basin - Other Drain Features - Capped End - Flared End Structure - Headwall; Endwall - Rip-rap - Drain Man holes - Outlet - Drain Line - Open Channel - Culvert	- Detention Basin - Drain Easement - Hydrant - Other Water Fitting - Bend Fitting - Cap Fitting - Cross Fitting - Pug Fitting - Increase; Reducer - Tap Fitting - Tee Fitting	- Coupling - Other Water Valve - Gate Valve - Butterfly Valve - Blow Off Valve - Other Service Valve - Gate Valve - Butterfly Valve - Blow Off Valve - Other Water Feature - Thrust Protection	- Water Meter Pit - Water Pumping Station - Fire Pump - Sample Station - Water tank - Water Main - Abandoned / Inactive Water Main - Proposed Water Main - Abandoned Water Lateral - Proposed Water Lateral	- Water Lateral - Water Easement - Easement Boundaries - Break Out Tanks - LNG's - Pipelines
--	--	---	---	--	--	---

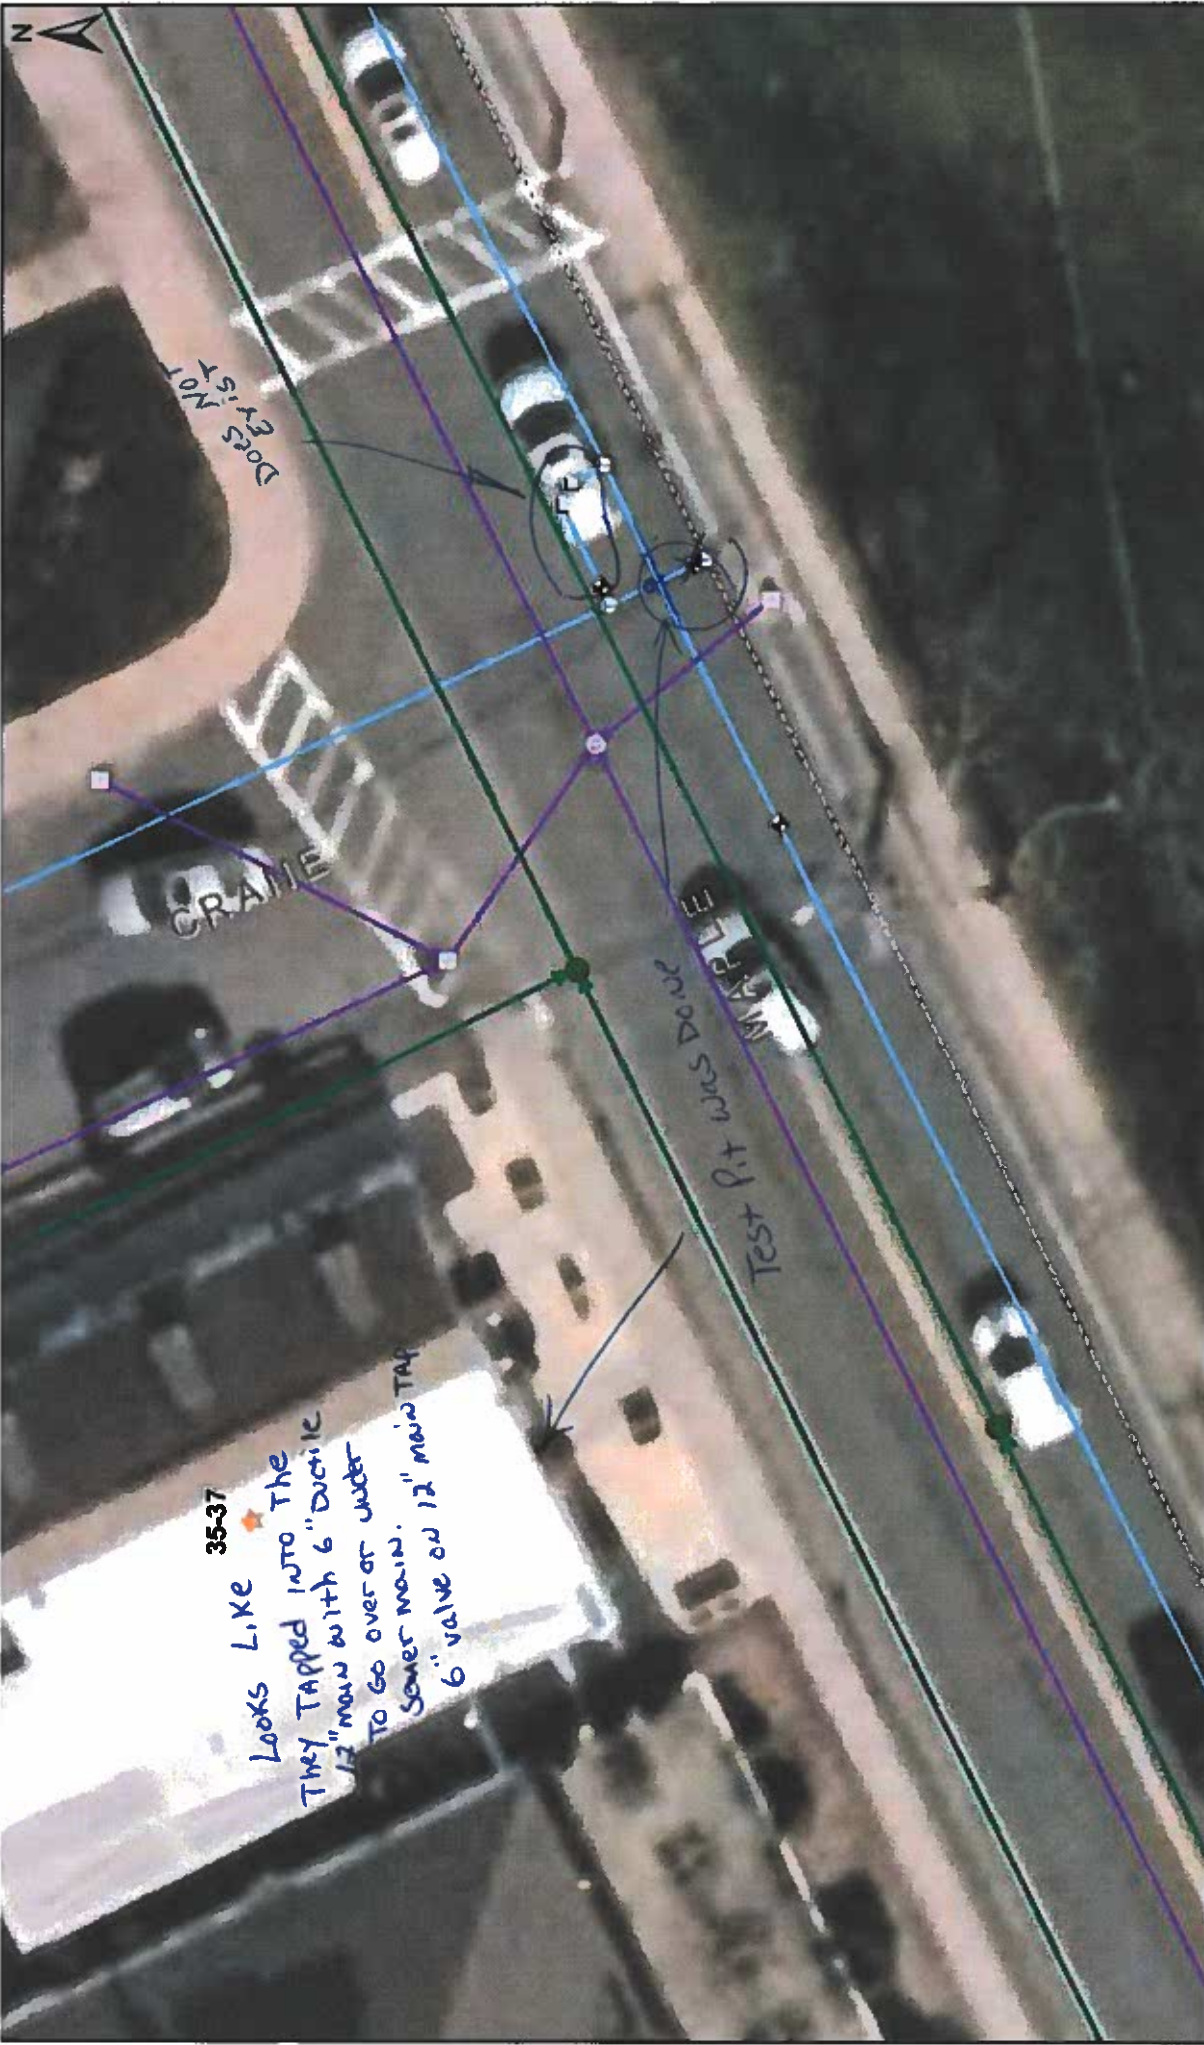

1 inch = 24 feet
9/23/2020