EAST LONGMEADOW DEPARTMENT OF PUBLIC WORKS

Job: 64 Euclid Ave (water)

Sheet No: Excavator - Excavation Plus Inc. of

Calculated By: Pope Date 11-16-2021

Scale:

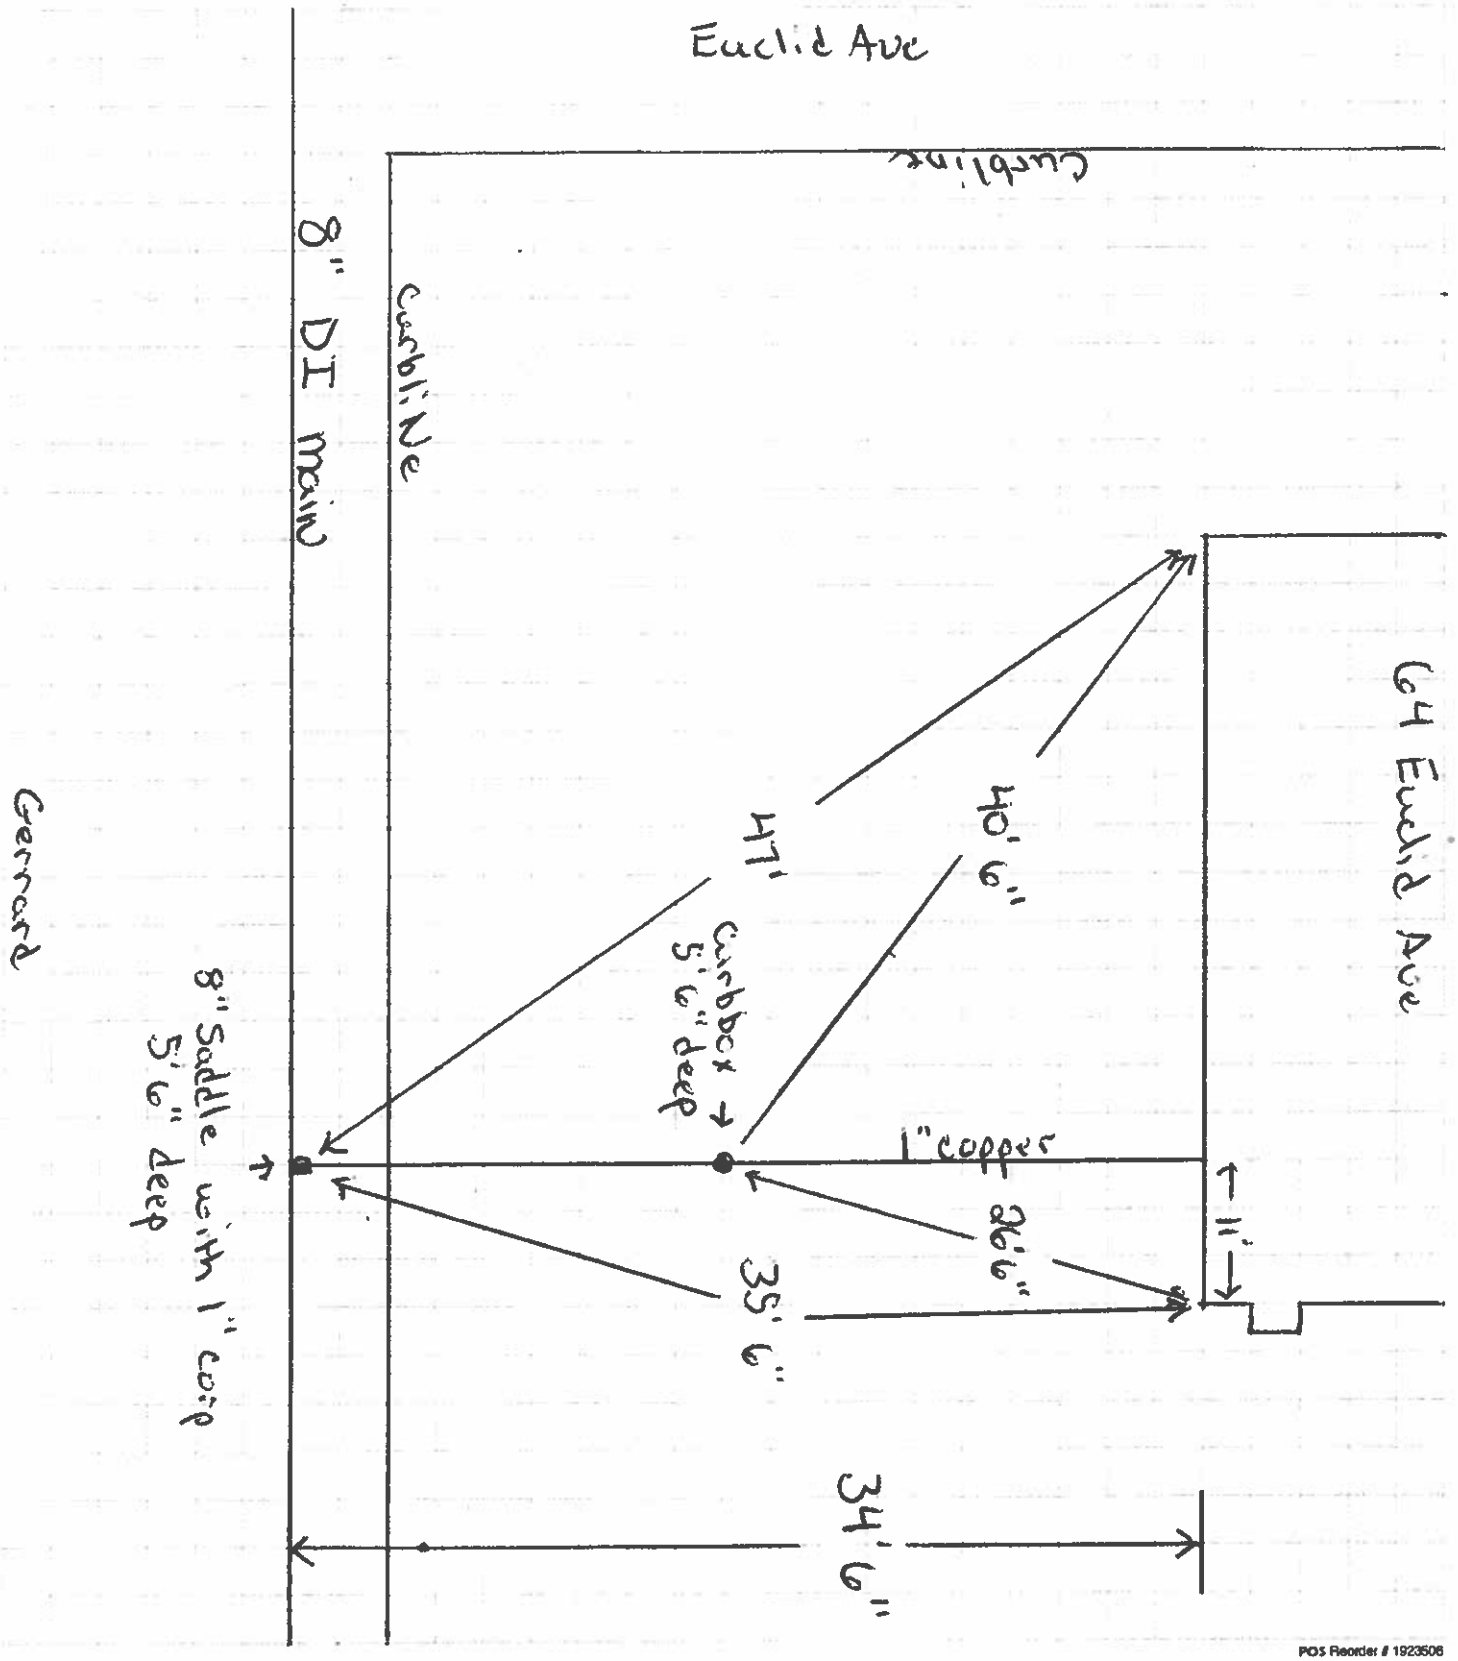

POS Reorder # 1923508