EAST LONGMEADOW DEPARTMENT OF PUBLIC WORKS

Job: ~~3~~ 2 Jeffrey lane (water)

Sheet No: Bousquet Excavation of

Calculated By: Pope Date 9-29-21

Scale:

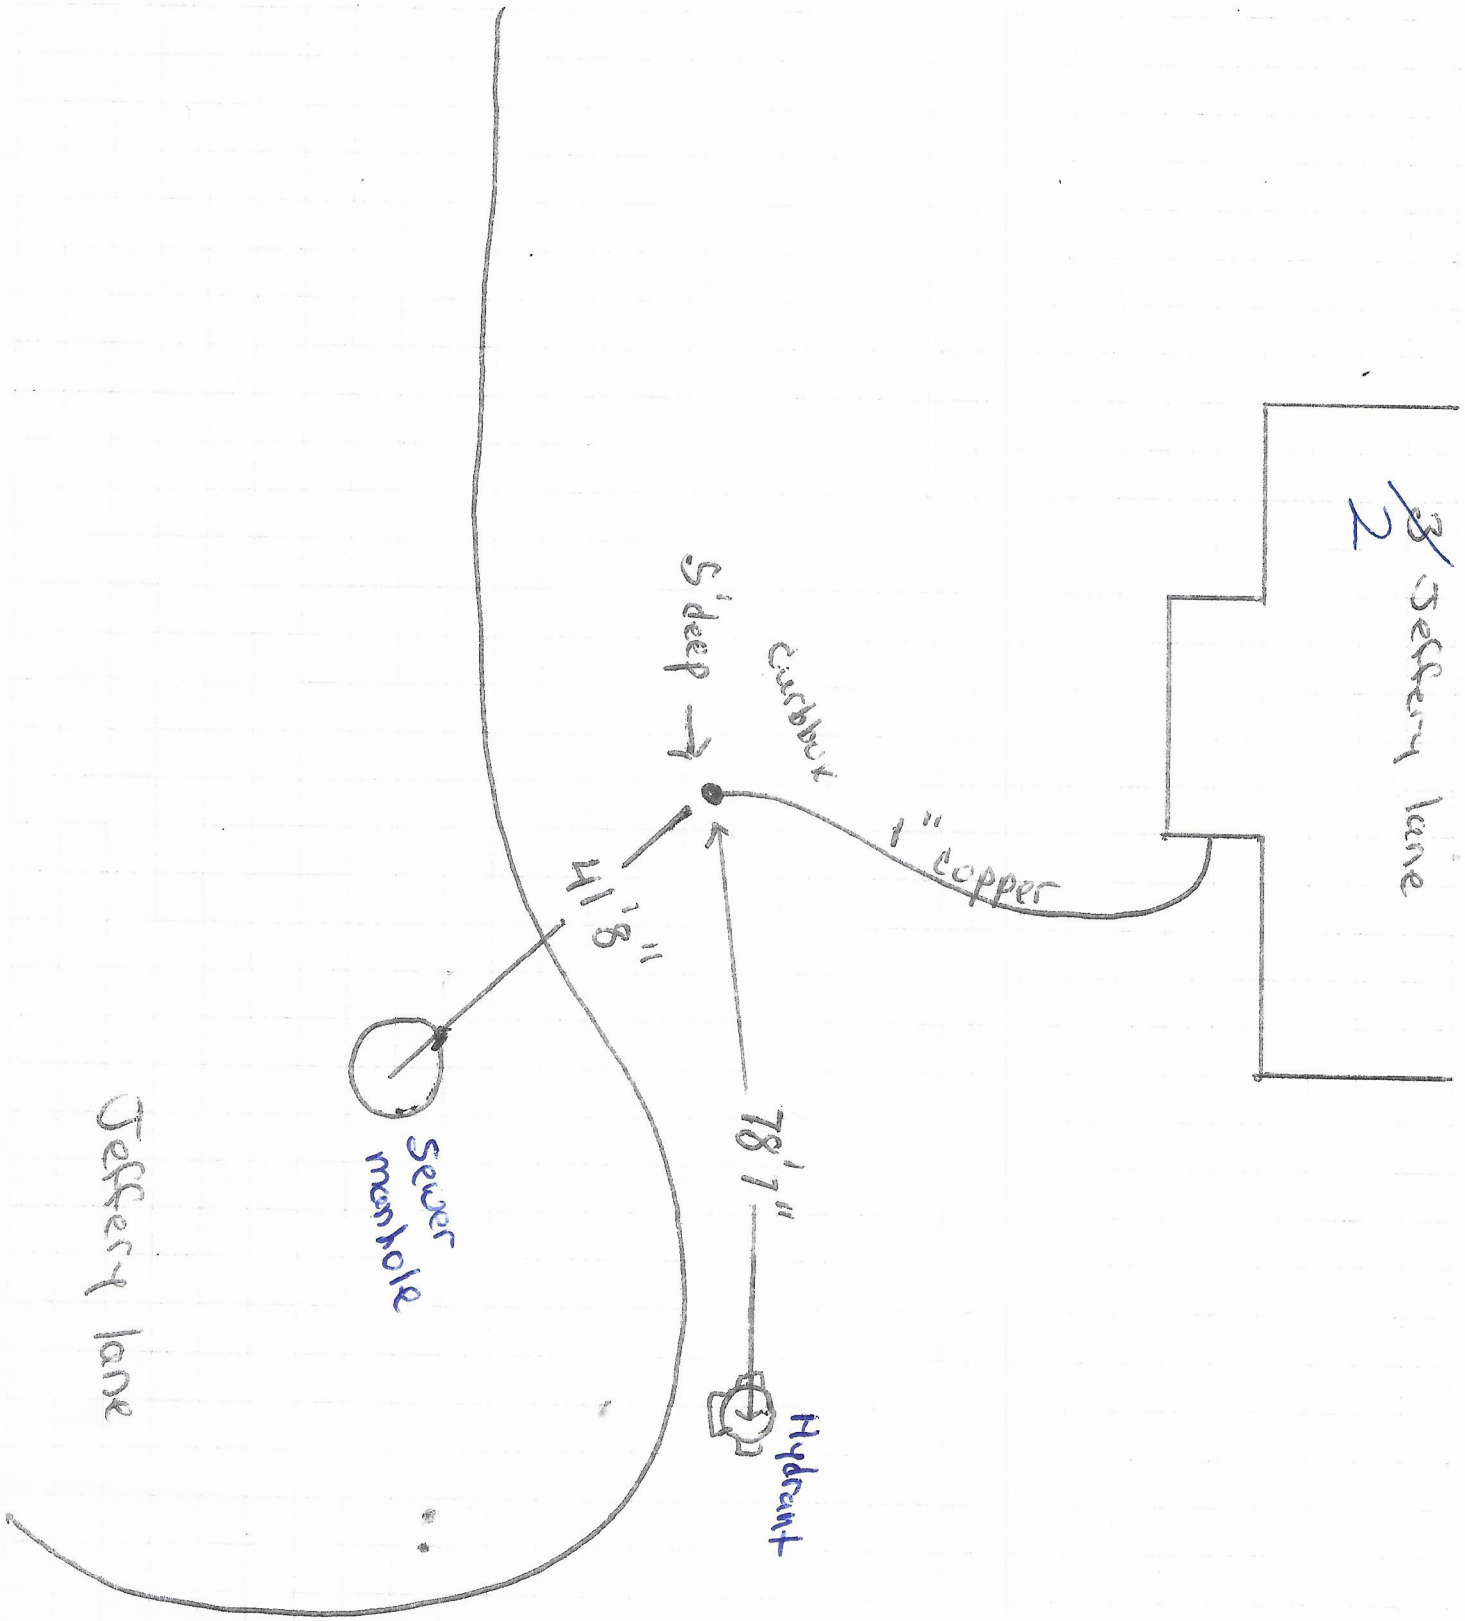

10/5/21 Scanned to GIS

POS Reorder # 1923506