


210 MAPLE STREET

2020

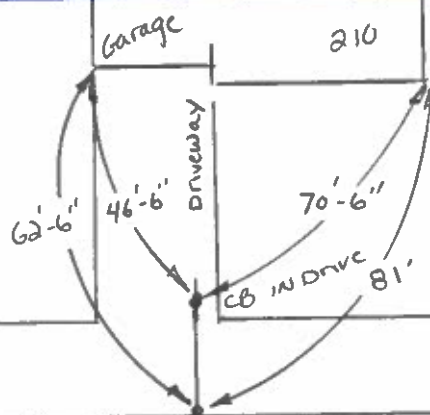

12" AC MAIN
O.D. 14.40