


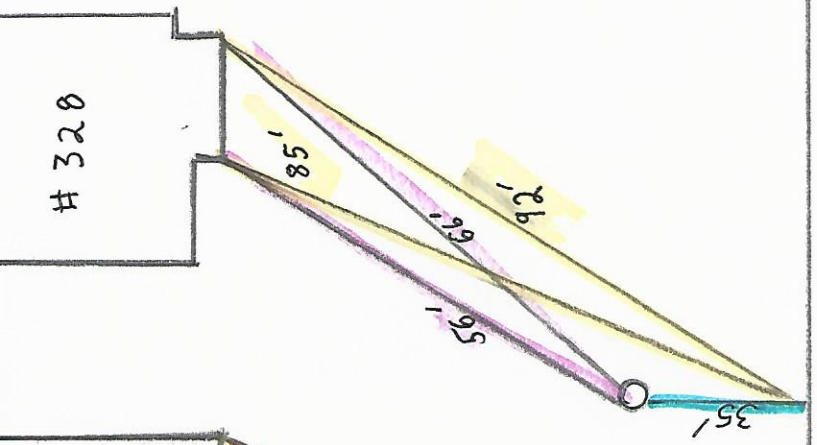
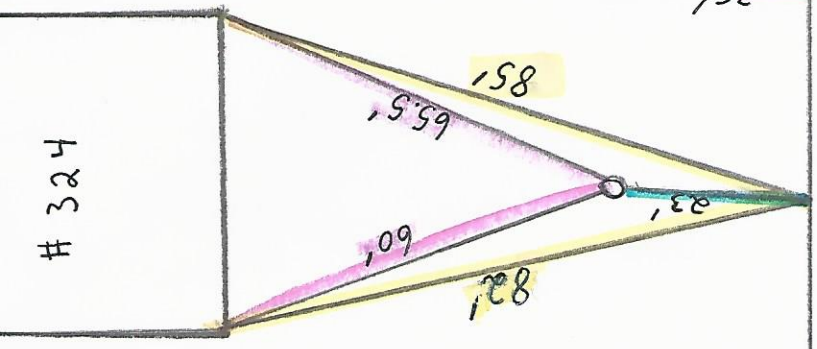
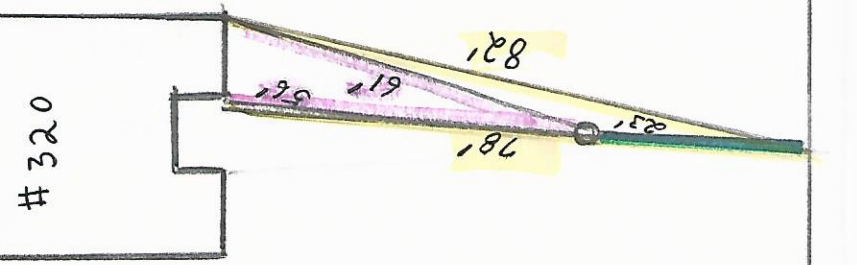


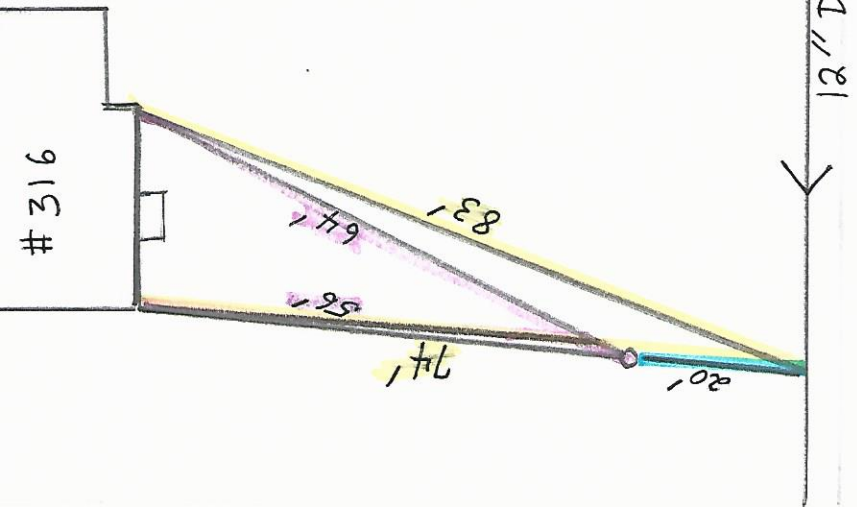

12" DI

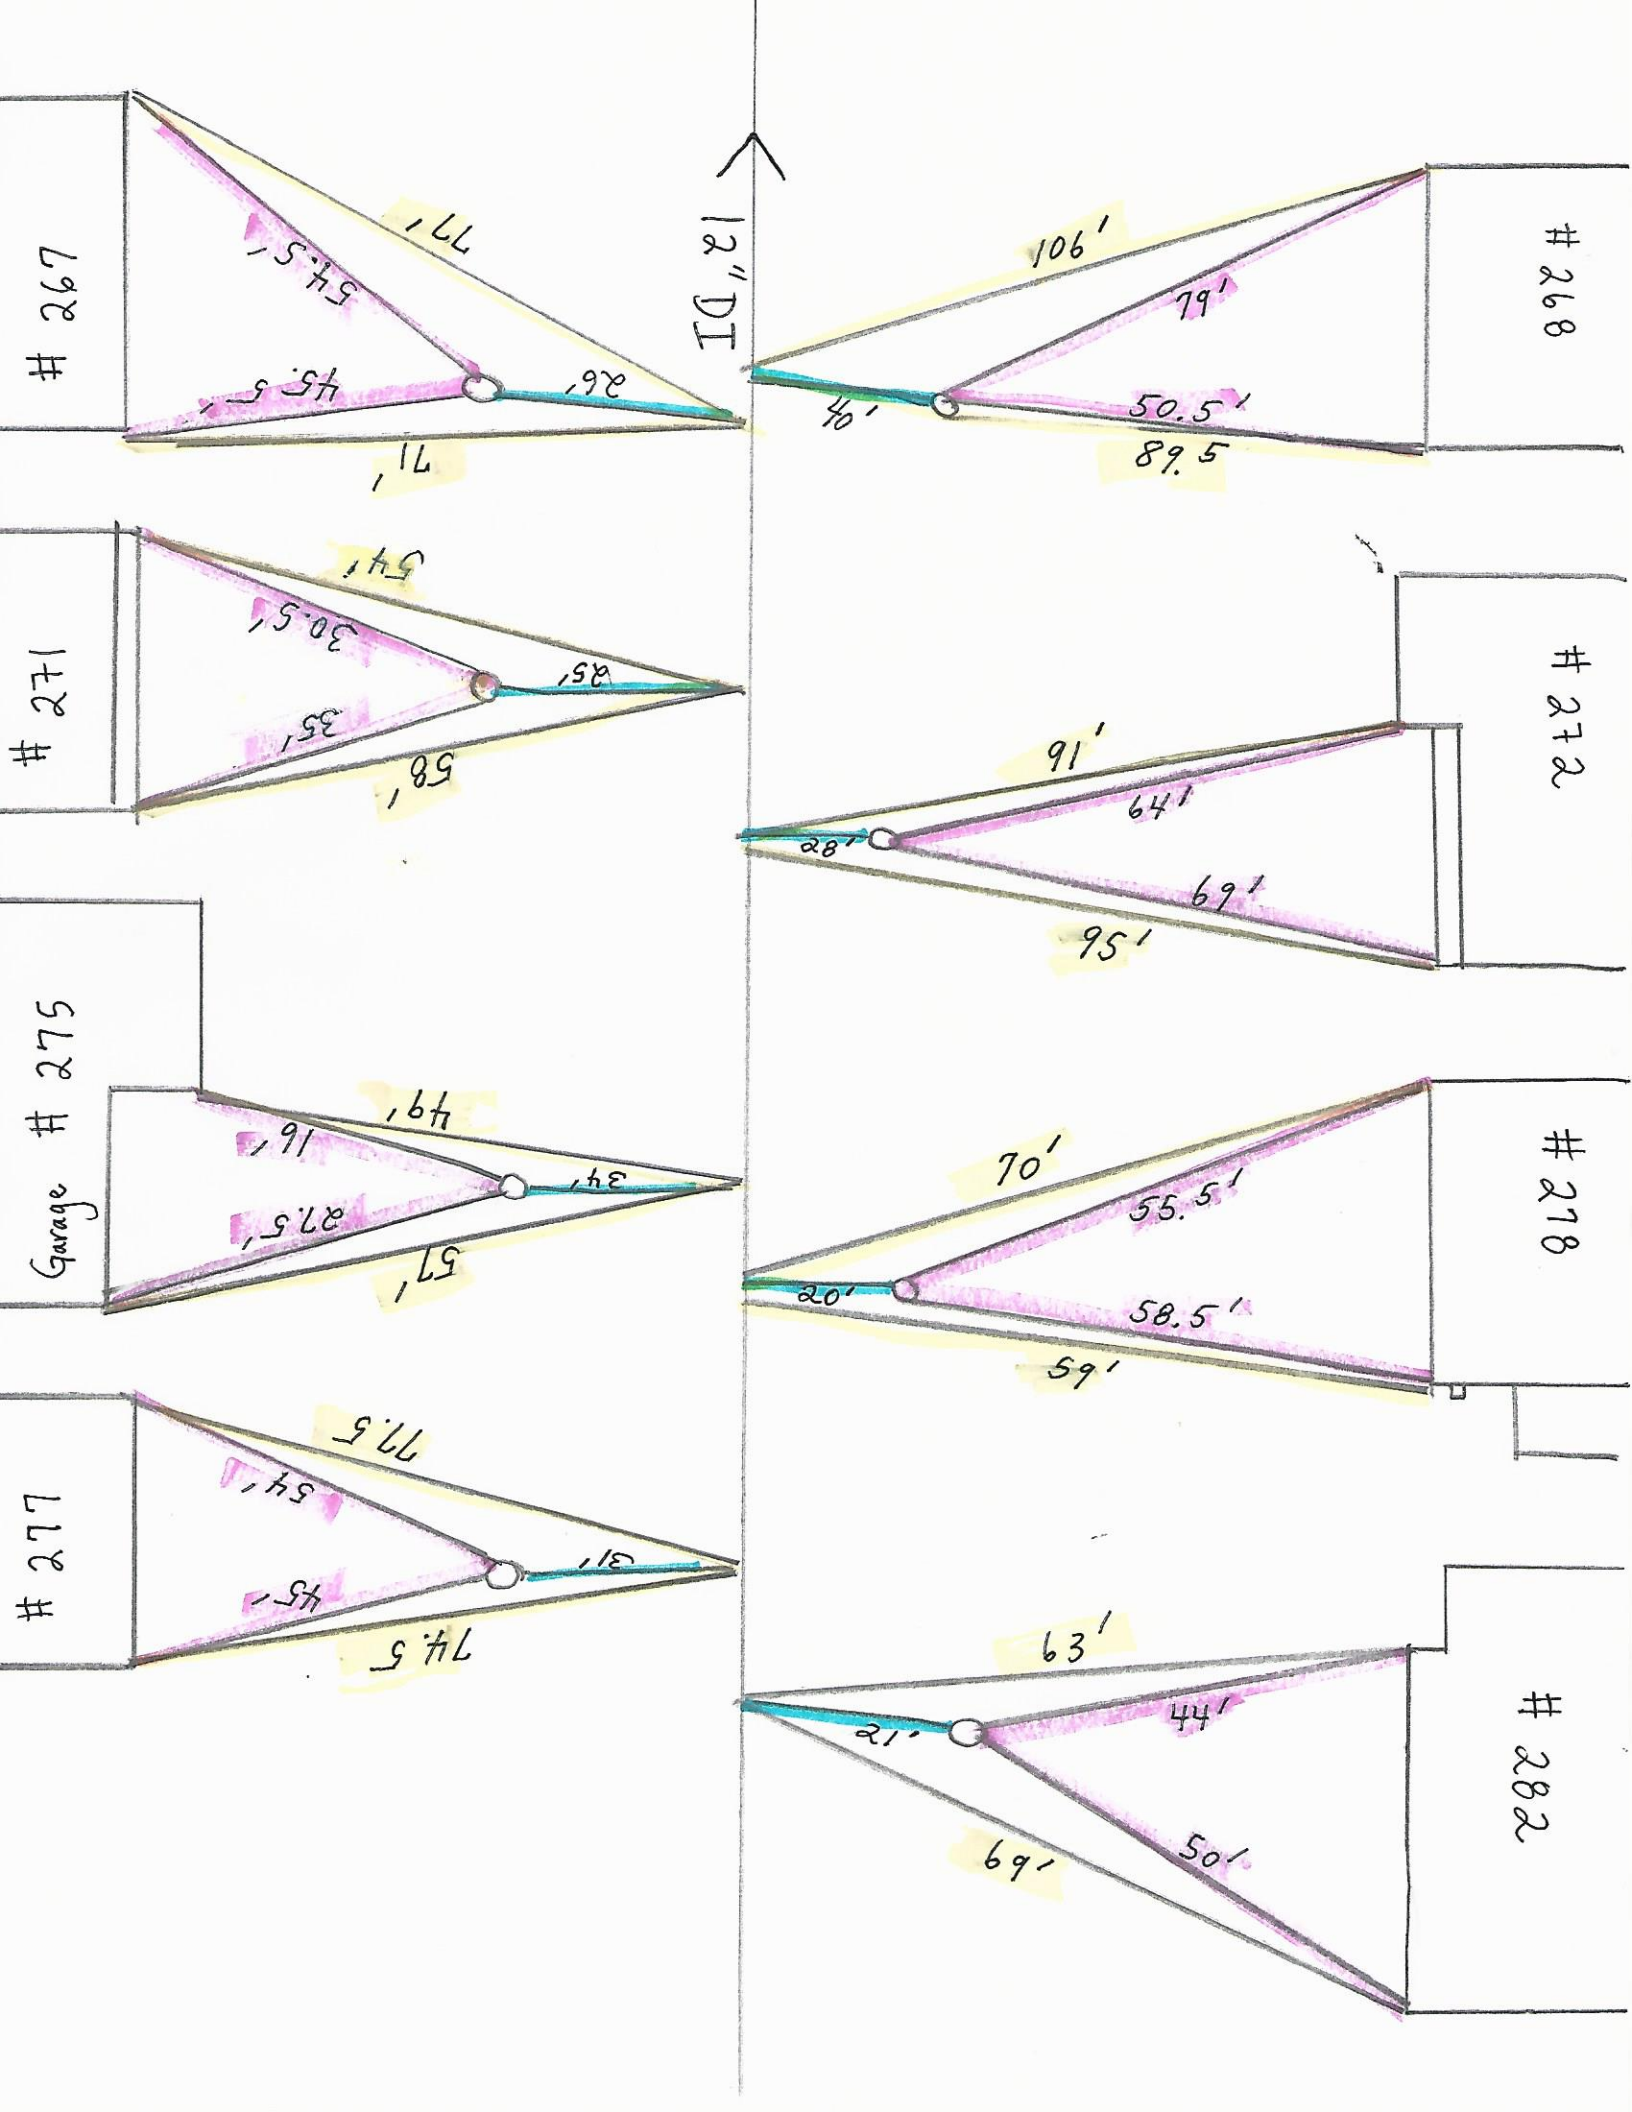

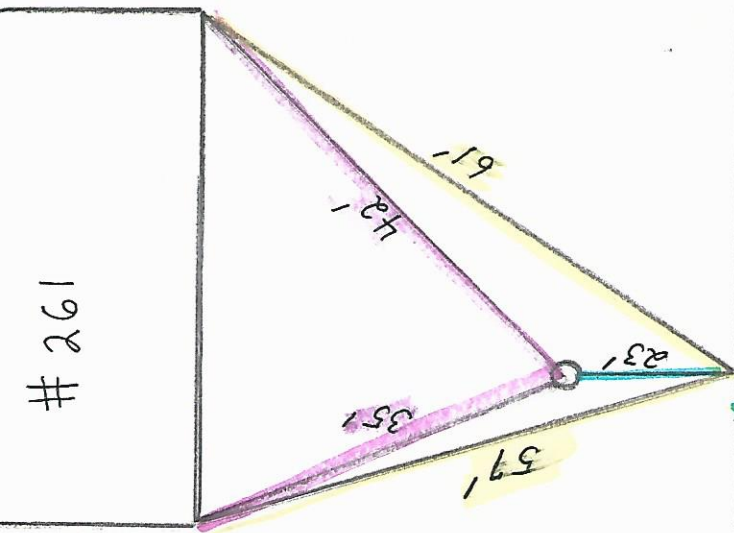

12" DI

