


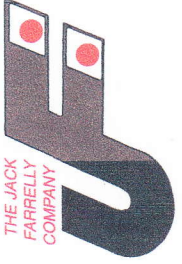


The Jack Farrelly Company
& **Hancor**




The Jack Farrelly Company
& **Hancor**

The #1 Team in Drainage Products

The #1 Team in Drainage Products

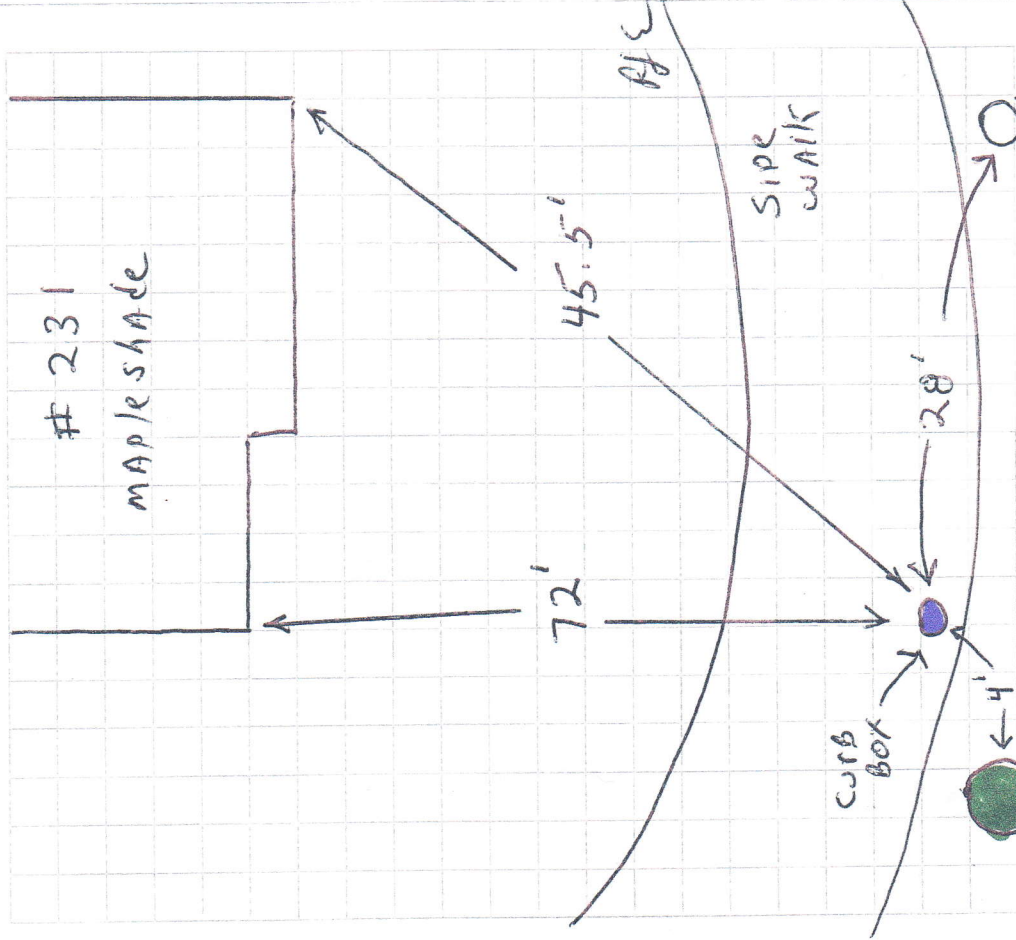

97 OLD POQUONOCK ROAD, BLOOMFIELD, CT 06002
(860) 243-9714 • (800) 423-0112 • FAX (860) 286-0867
150 UNIVERSAL DRIVE (Rear), NORTH HAVEN, CT 06473 • (203) 777-5548 • FAX (203) 777-3147
COLTON ROAD, EAST LYME, CT 06333 • (860) 739-5457 • FAX (860) 739-8513
176 CHASE RIVER ROAD, WATERBURY, CT 06704 • (203) 759-1135 • FAX (203) 759-7522
149 SOUTH WEST CUTOFF, WORCESTER, MA 01604 • (508) 752-PIPE • FAX (508) 797-4455

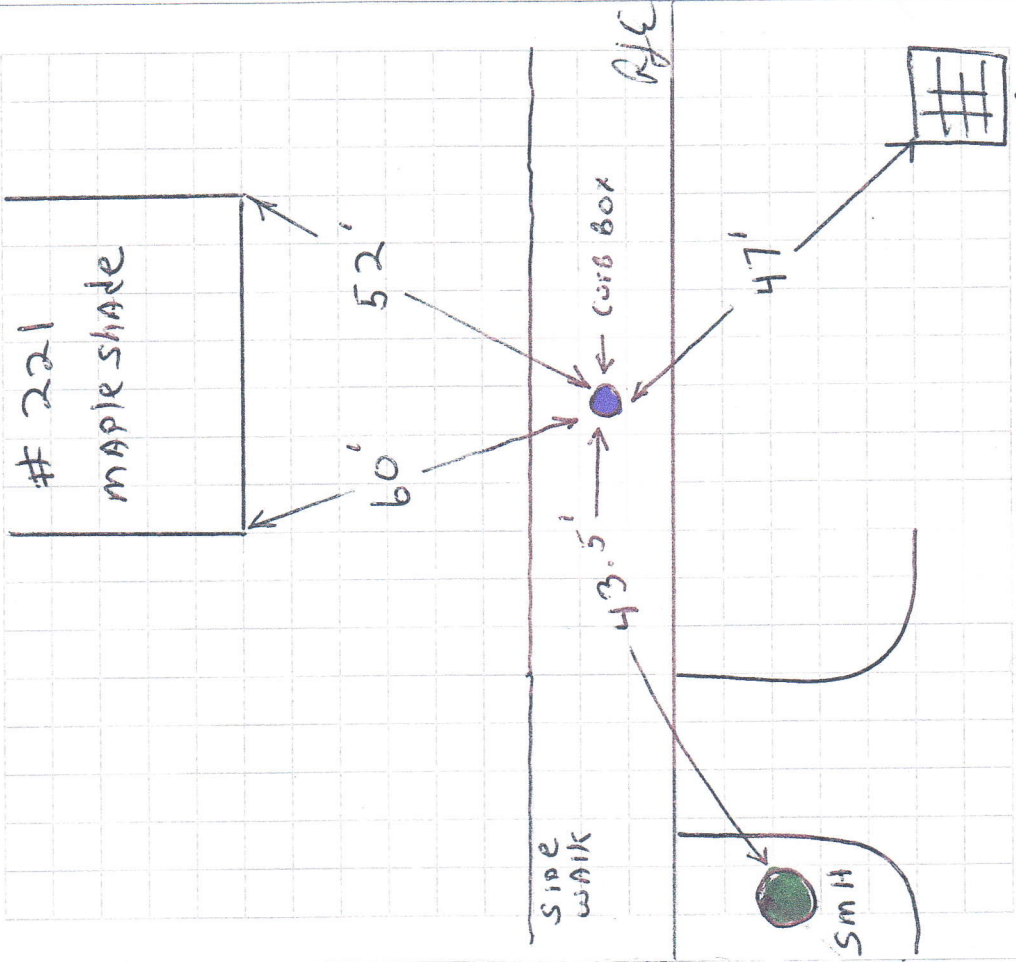

97 OLD POQUONOCK ROAD, BLOOMFIELD, CT 06002
(860) 243-9714 • (800) 423-0112 • FAX (860) 286-0867
150 UNIVERSAL DRIVE (Rear), NORTH HAVEN, CT 06473 • (203) 777-5548 • FAX (203) 777-3147
COLTON ROAD, EAST LYME, CT 06333 • (860) 739-5457 • FAX (860) 739-8513
176 CHASE RIVER ROAD, WATERBURY, CT 06704 • (203) 759-1135 • FAX (203) 759-7522
149 SOUTH WEST CUTOFF, WORCESTER, MA 01604 • (508) 752-PIPE • FAX (508) 797-4455