



East Longmeadow Utilities Application

7-2019
New 8" D.I. MAIN
BY TOWN

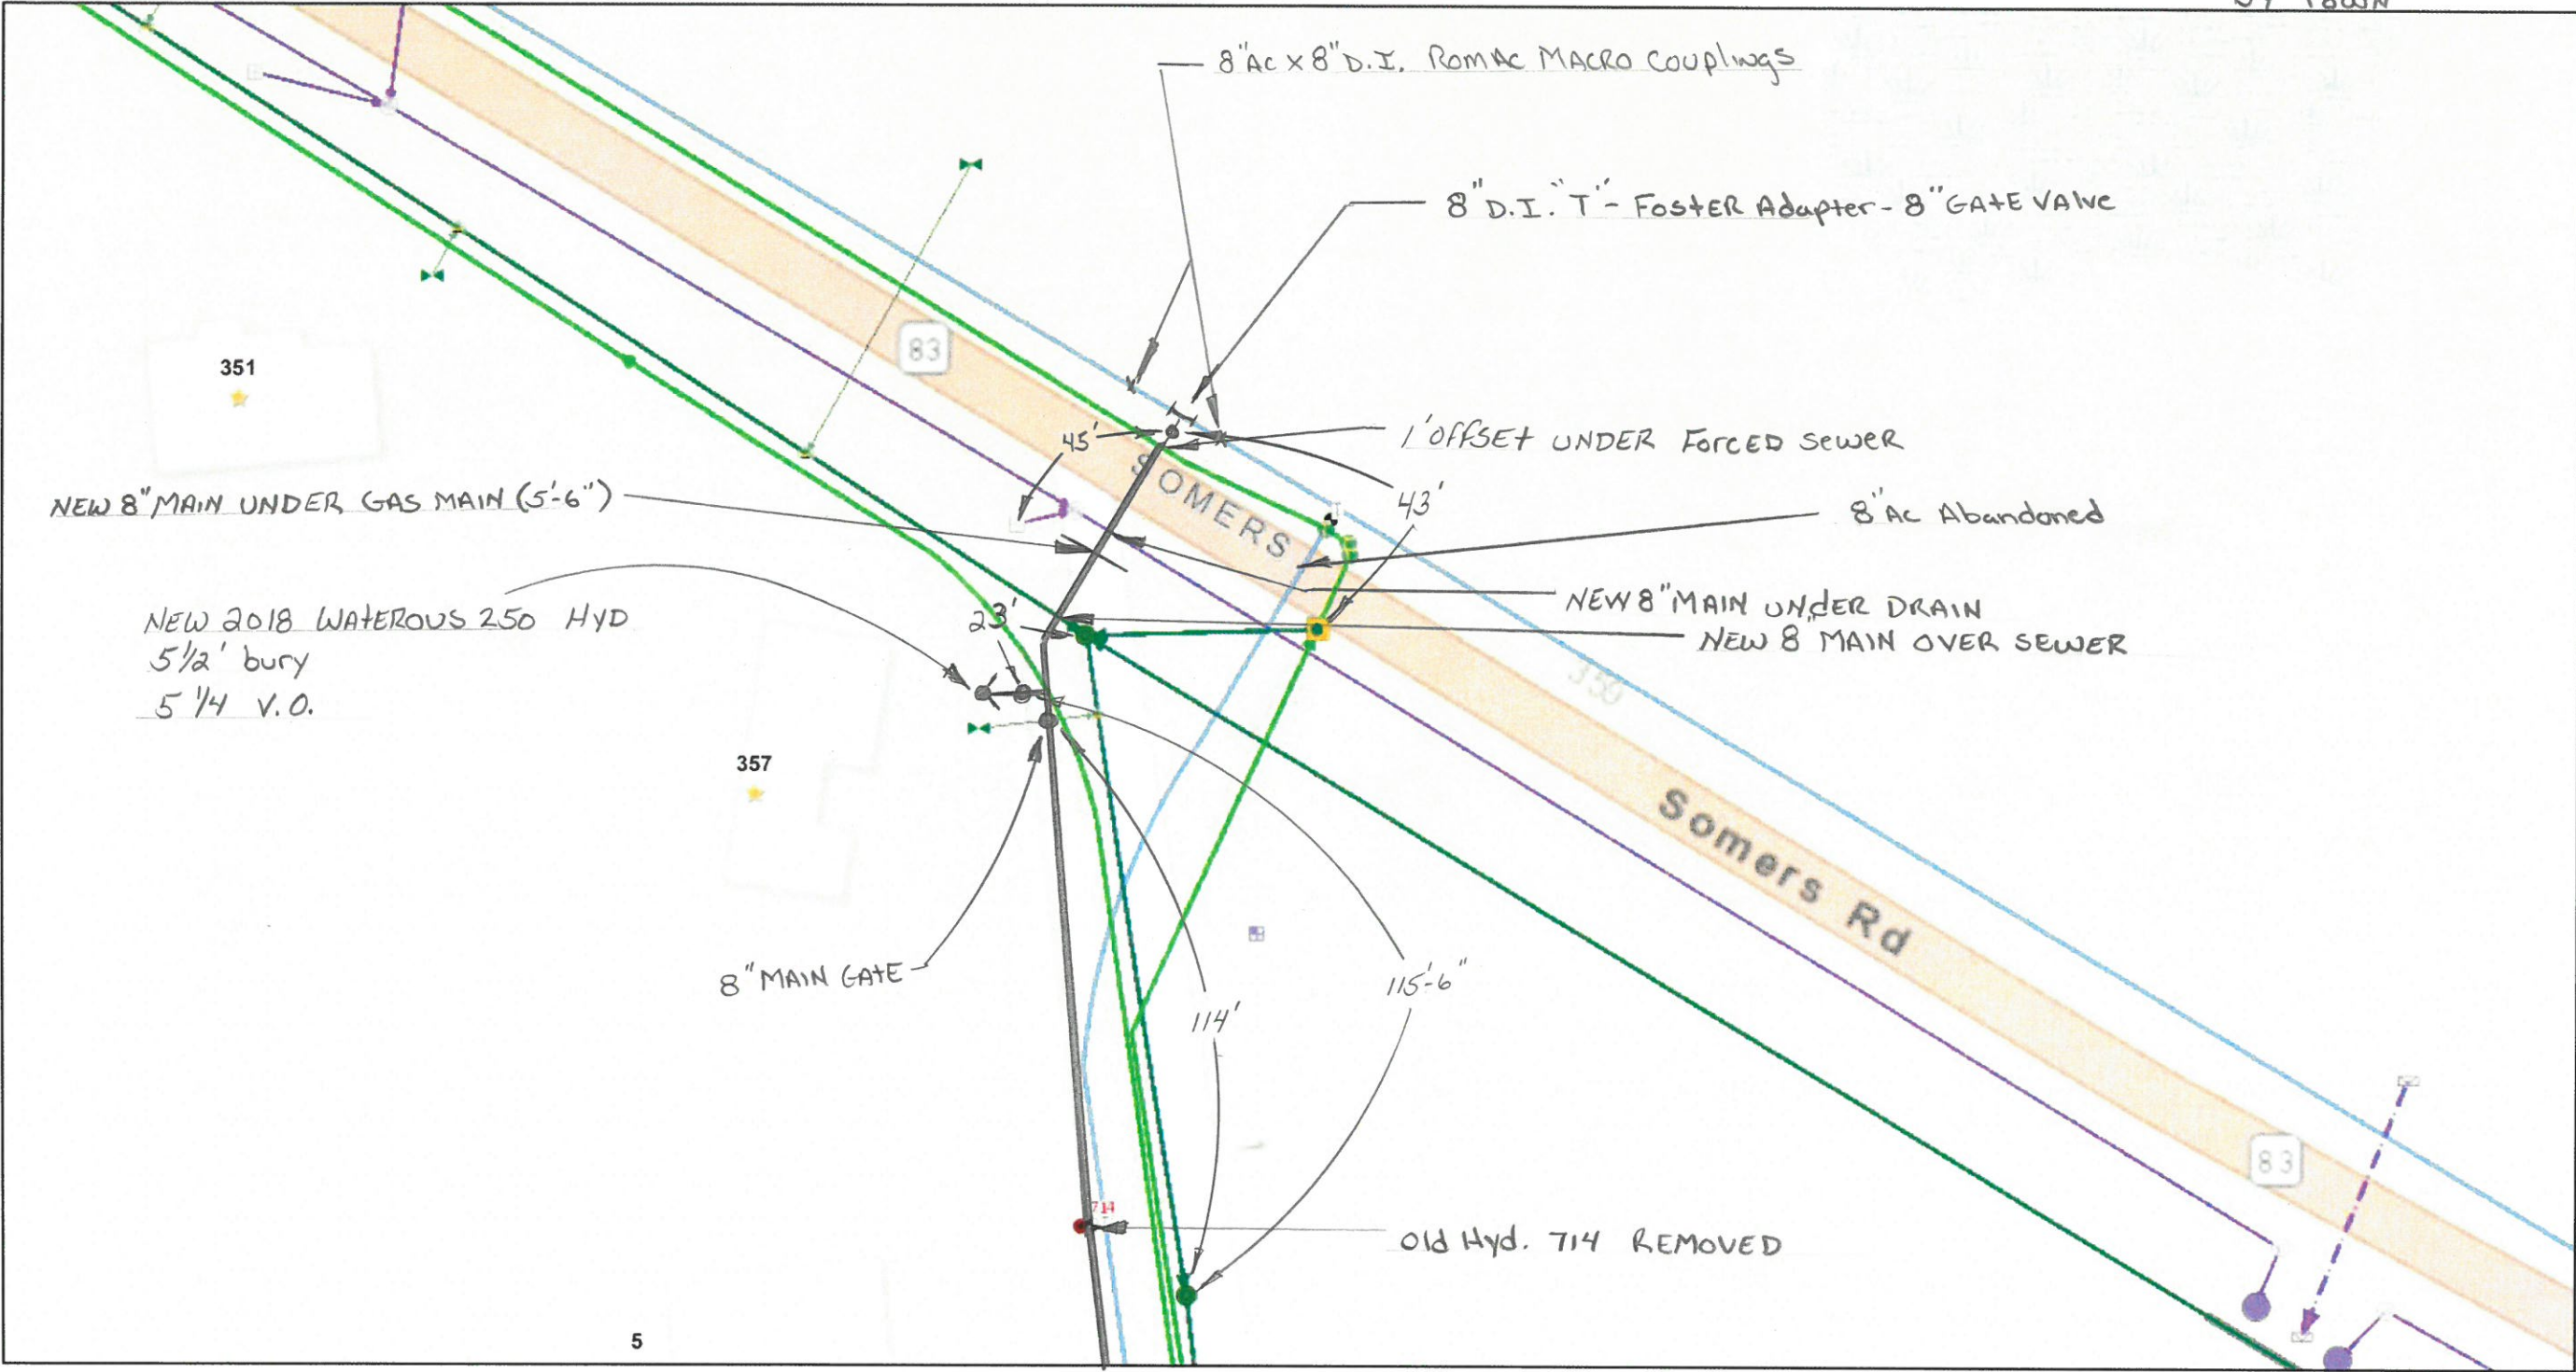


7/22/2019, 8:05:23 AM

- | | | |
|---------------------|-------------------|-----------------|
| Service Locations | Water Feature | Sample Station |
| Town Boundaries | Other | Water tank |
| Easement Boundaries | Thrust Protection | Service Valve |
| Water Easement | Meter Pit | Other |
| Active | Pumping Station | Gate Valve |
| Active | Fire Pump | Butterfly Valve |

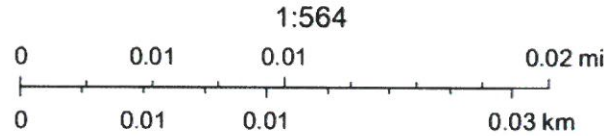

Sources: Esri, HERE, Garmin, USGS, Intermap, INCREMENT P, NRCan, Esri Japan, METI, Esri China (Hong Kong), Esri Korea, Esri (Thailand), NGCC, (c) OpenStreetMap contributors, and the GIS User Community

East Longmeadow Utilities Application

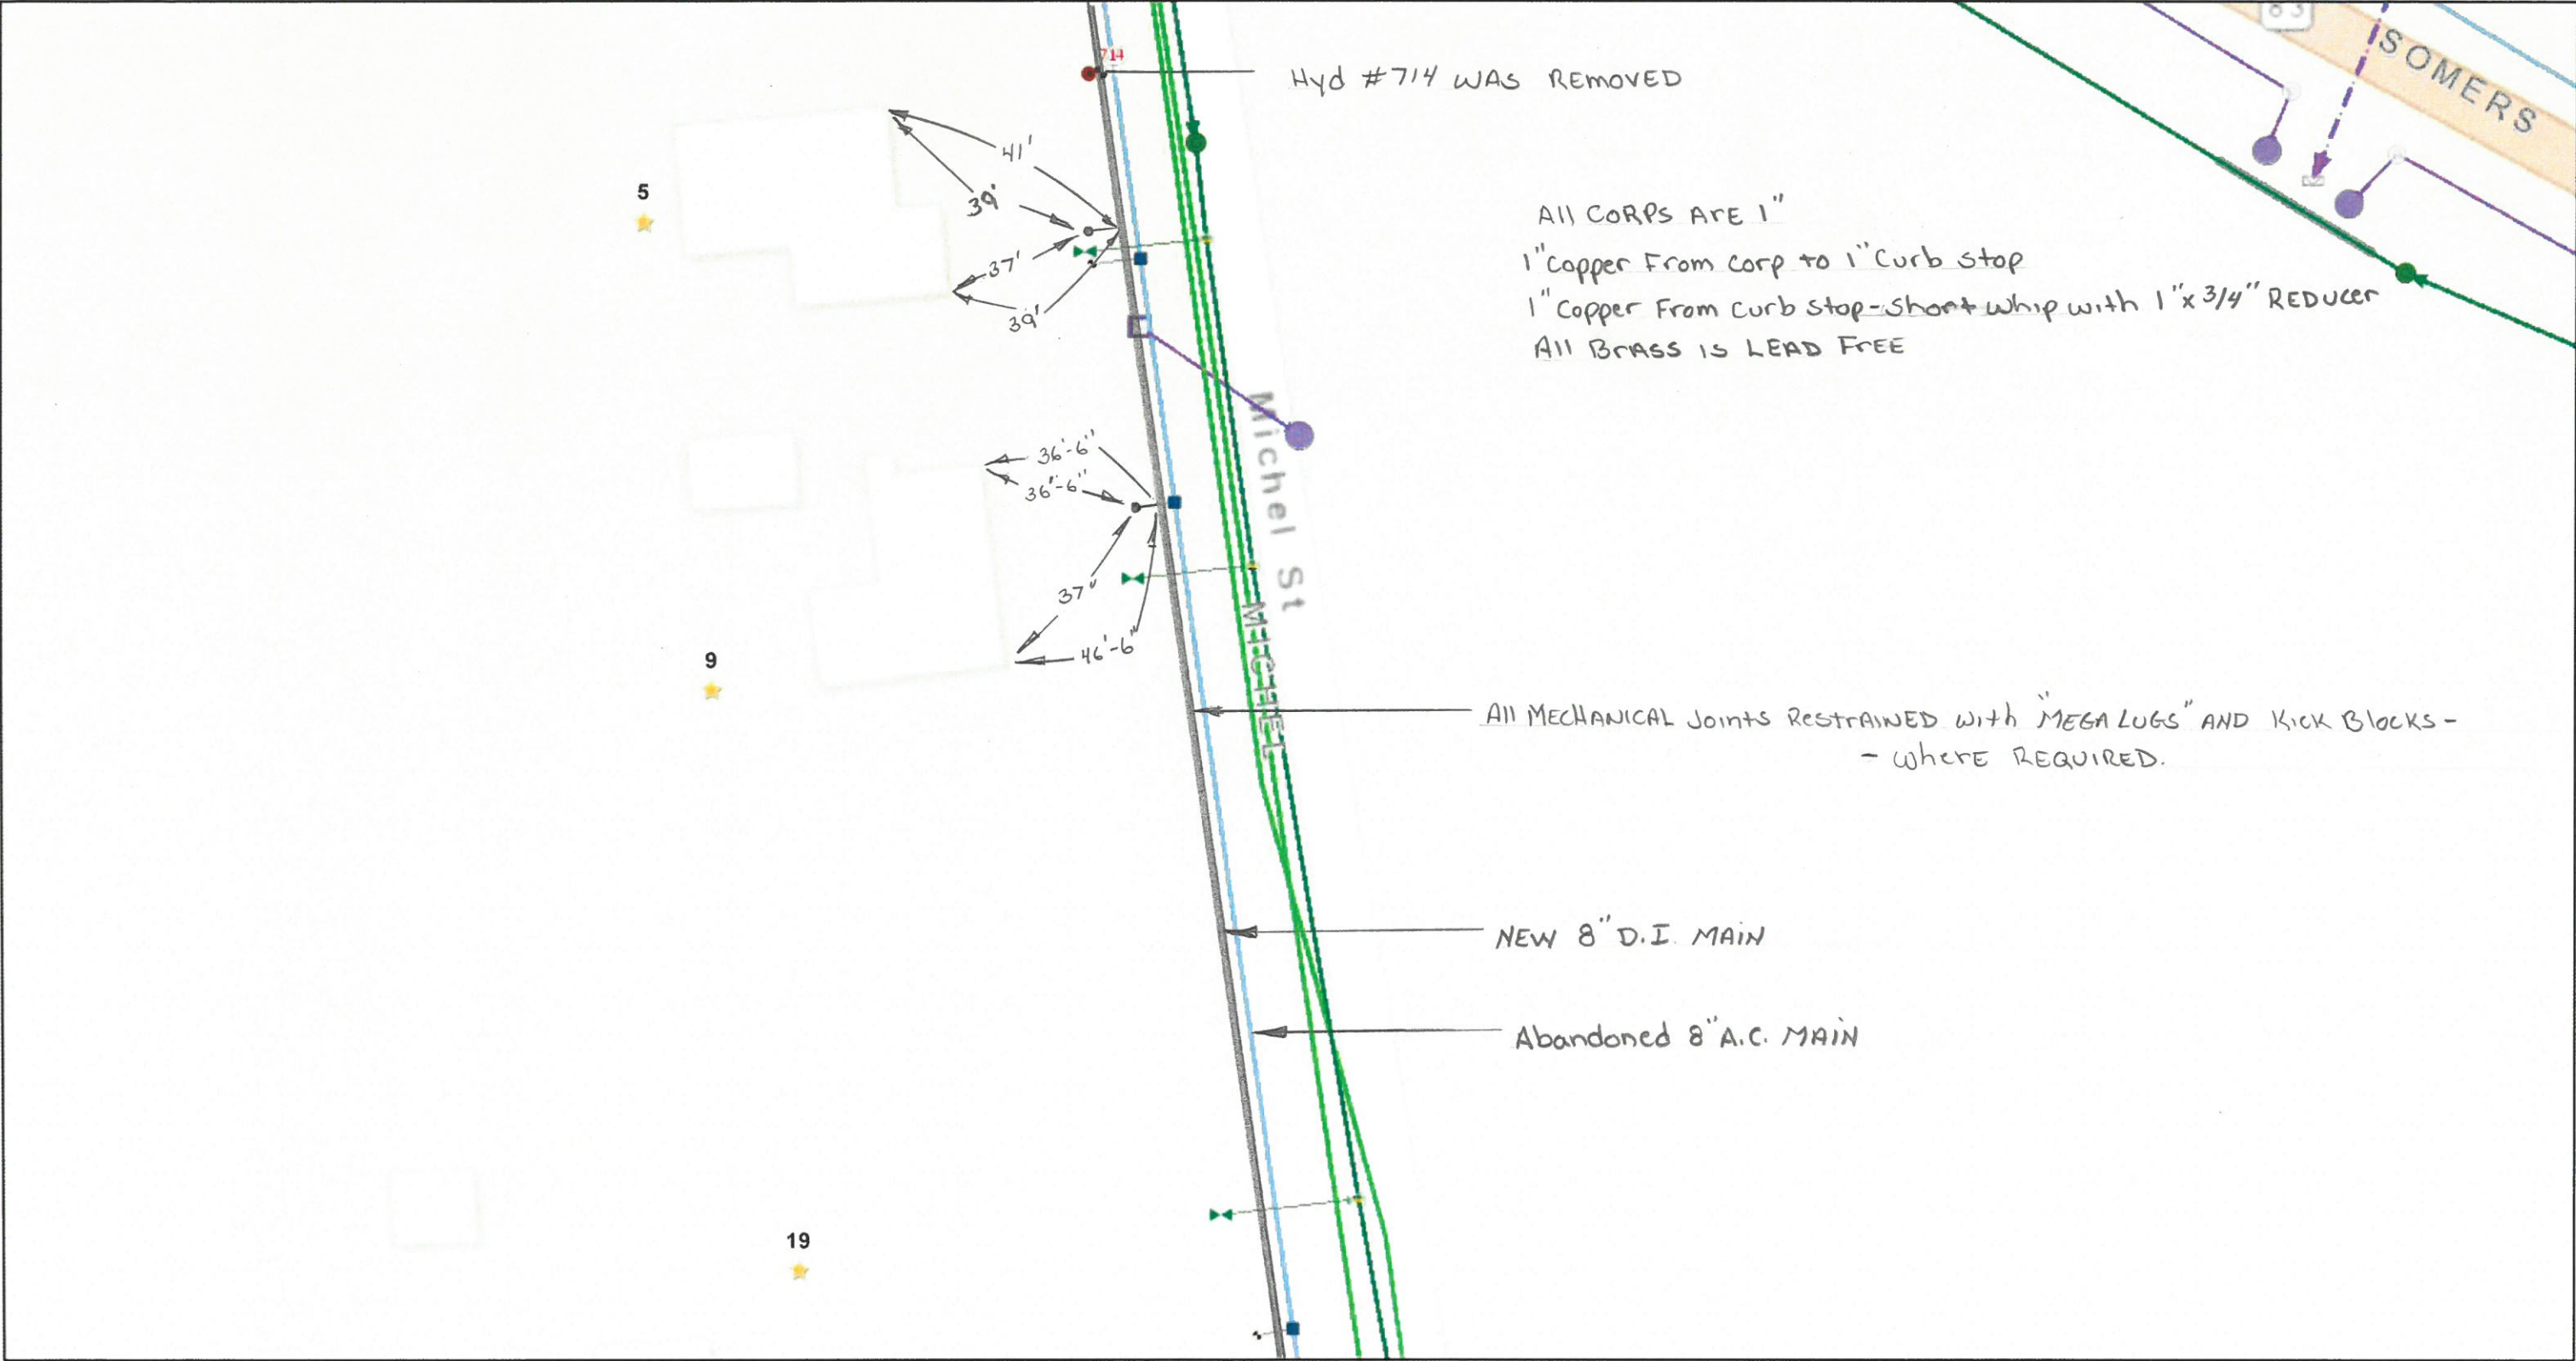

7/22/2019, 8:08:35 AM

- | | | |
|---------------------------|---------------------|-----------------|
| ★ Service Locations | Water Feature | Sample Station |
| ▭ Town Boundaries | ● Other | ● Water tank |
| - - - Easement Boundaries | ■ Thrust Protection | ● Service Valve |
| ▨ Water Easement | ⊙ Meter Pit | ● Other |
| | ⊙ Pumping Station | ● Gate Valve |


1:564

0 0.01 0.01 0.02 mi



0 0.01 0.01 0.03 km

Sources: Esri, HERE, Garmin, USGS, Intermap, INCREMENT P, NRCan, Esri Japan, METI, Esri China (Hong Kong), Esri Korea, Esri (Thailand), NGCC, (c) OpenStreetMap contributors, and the GIS User Community

East Longmeadow Utilities Application

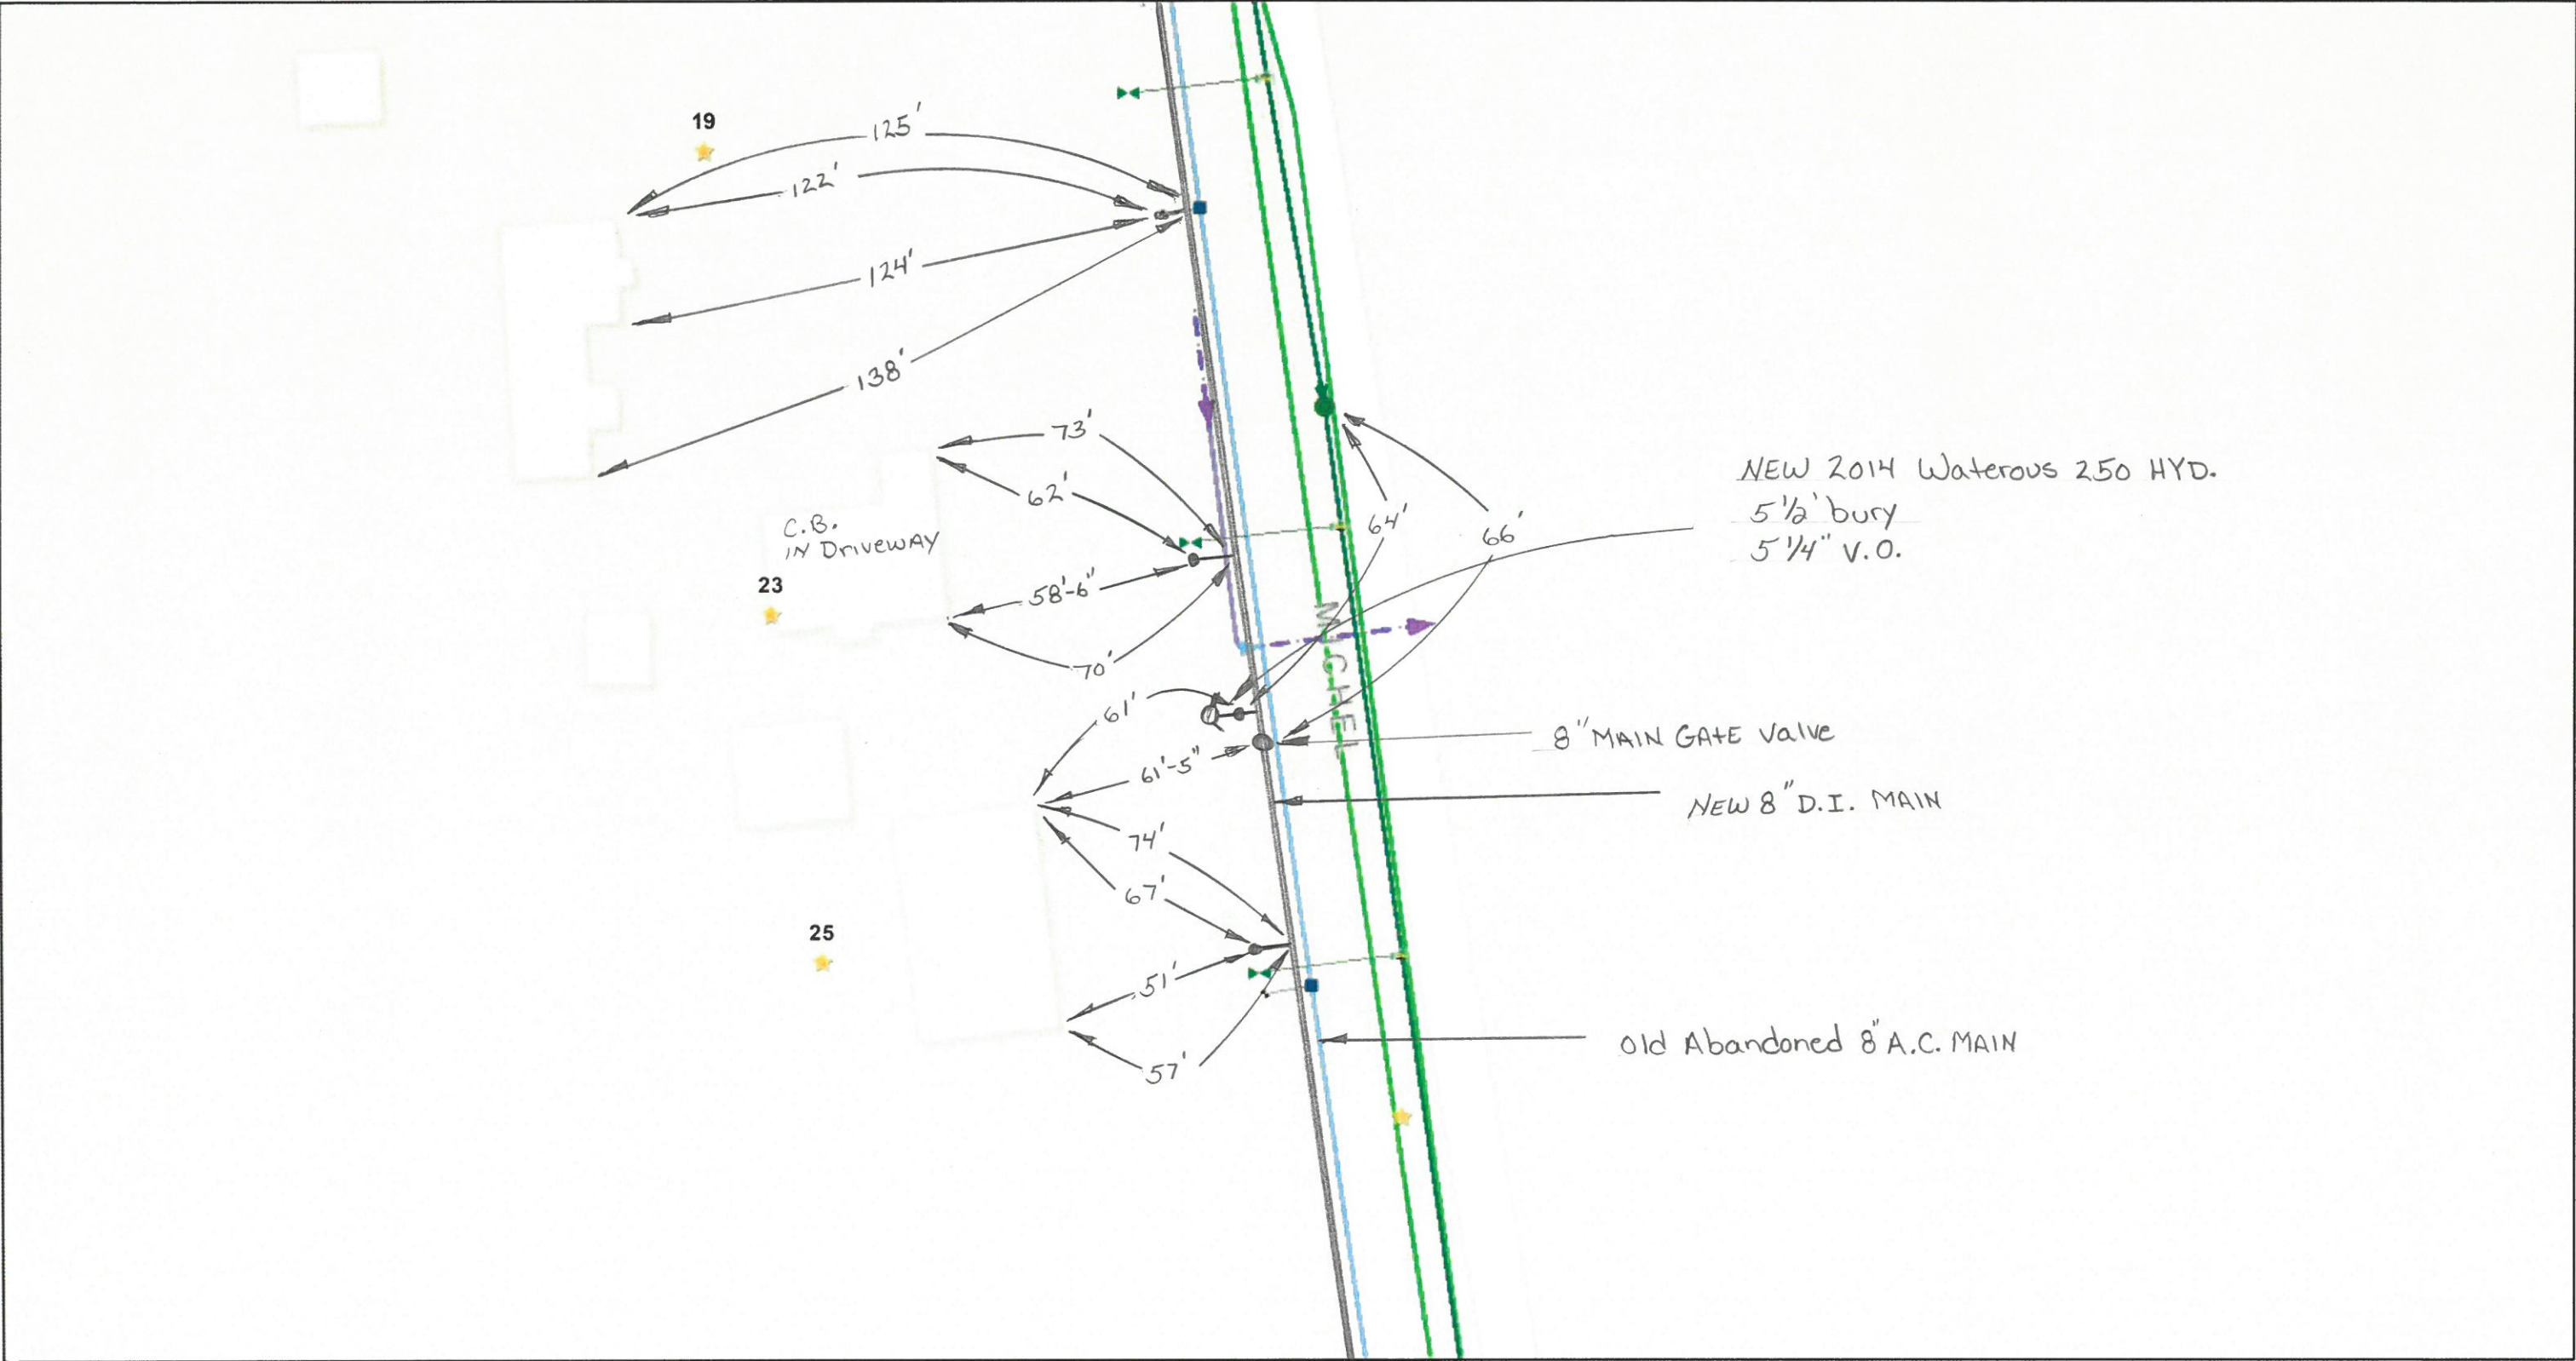


7/22/2019, 8:10:08 AM

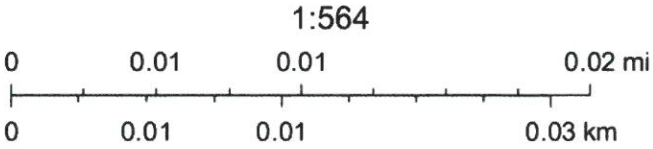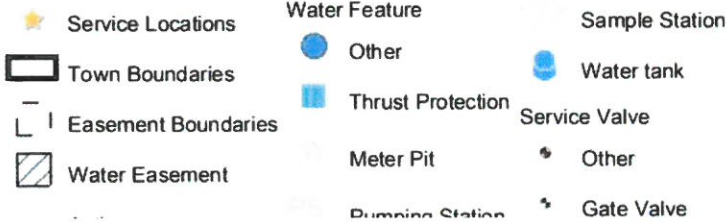


Sources: Esri, HERE, Garmin, USGS, Intermap, INCREMENT P, NRCan, Esri Japan, METI, Esri China (Hong Kong), Esri Korea, Esri (Thailand), NGCC, (c) OpenStreetMap contributors, and the GIS

East Longmeadow Utilities Application

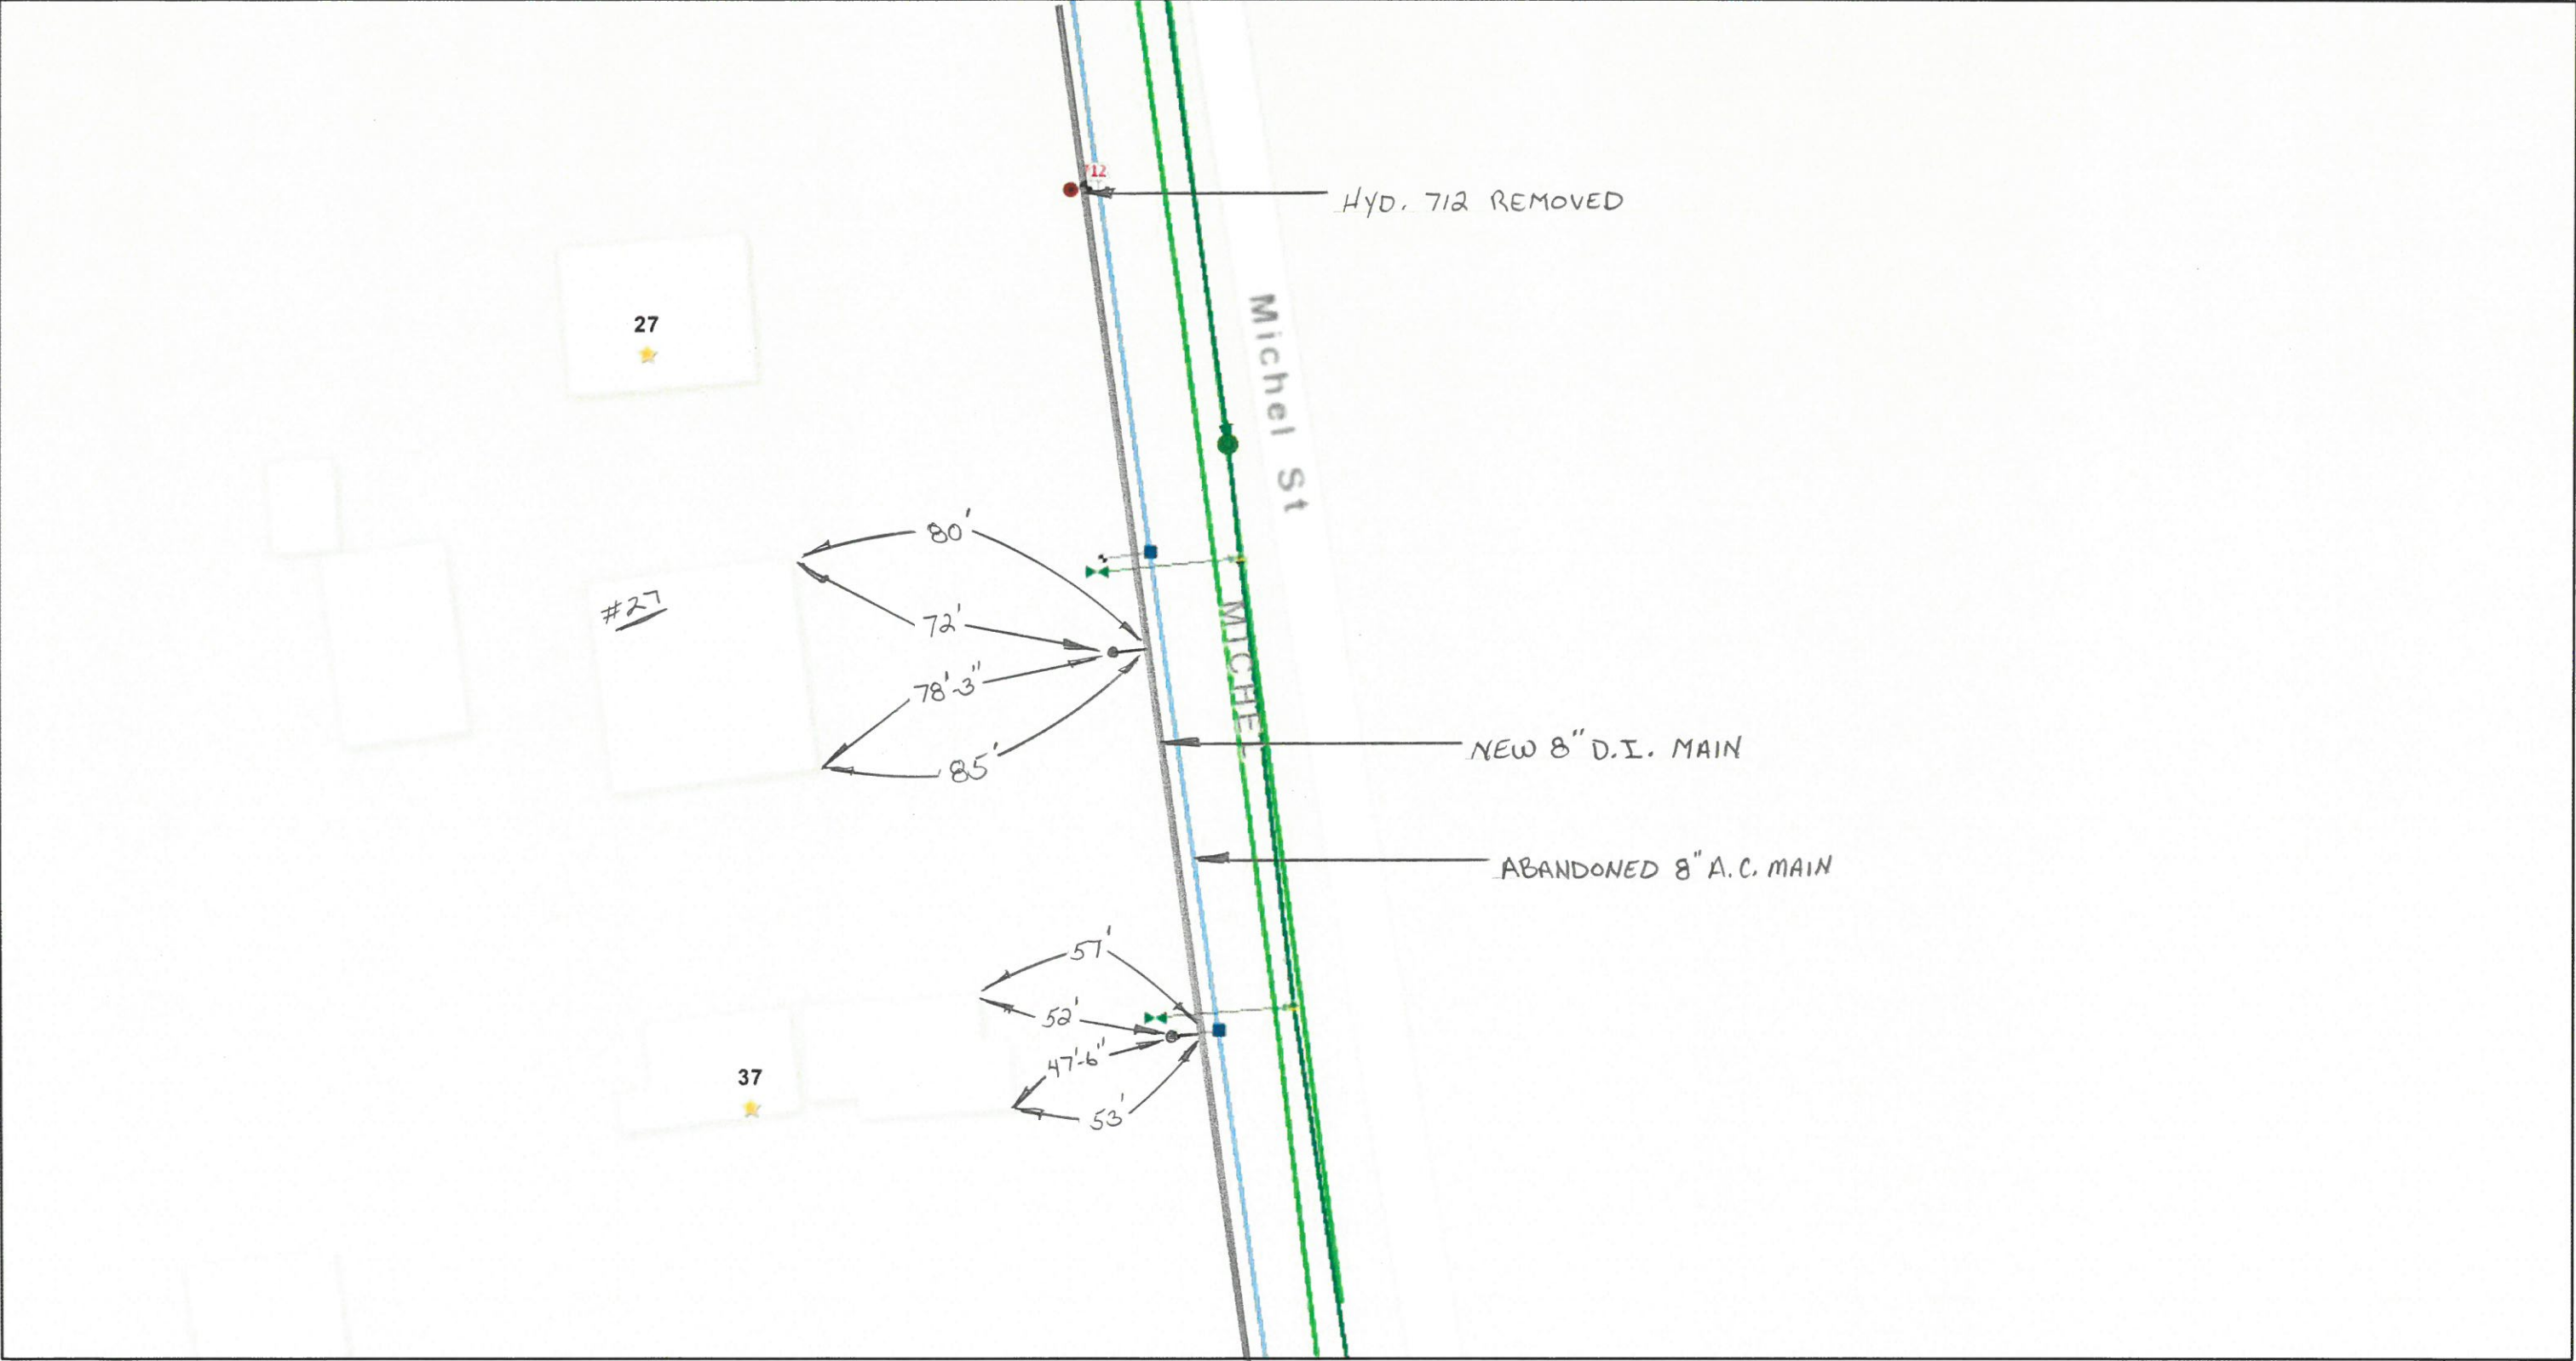


7/22/2019, 8:10:54 AM

- | | | |
|---------------------|----------------------|----------------|
| Service Locations | Water Feature | Sample Station |
| Town Boundaries | Other | Water tank |
| Easement Boundaries | Thrust Protection | Service Valve |
| Water Easement | Meter Pit | Other |
| | Pumping Station | Gate Valve |


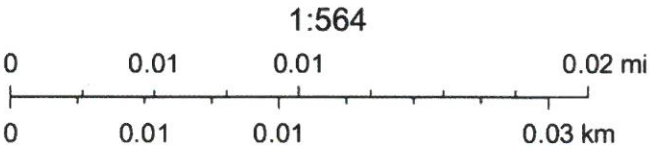


Sources: Esri, HERE, Garmin, USGS, Intermap, INCREMENT P, NRCan, Esri Japan, METI, Esri China (Hong Kong), Esri Korea, Esri (Thailand), NGCC, (c) OpenStreetMap contributors, and the GIS

East Longmeadow Utilities Application

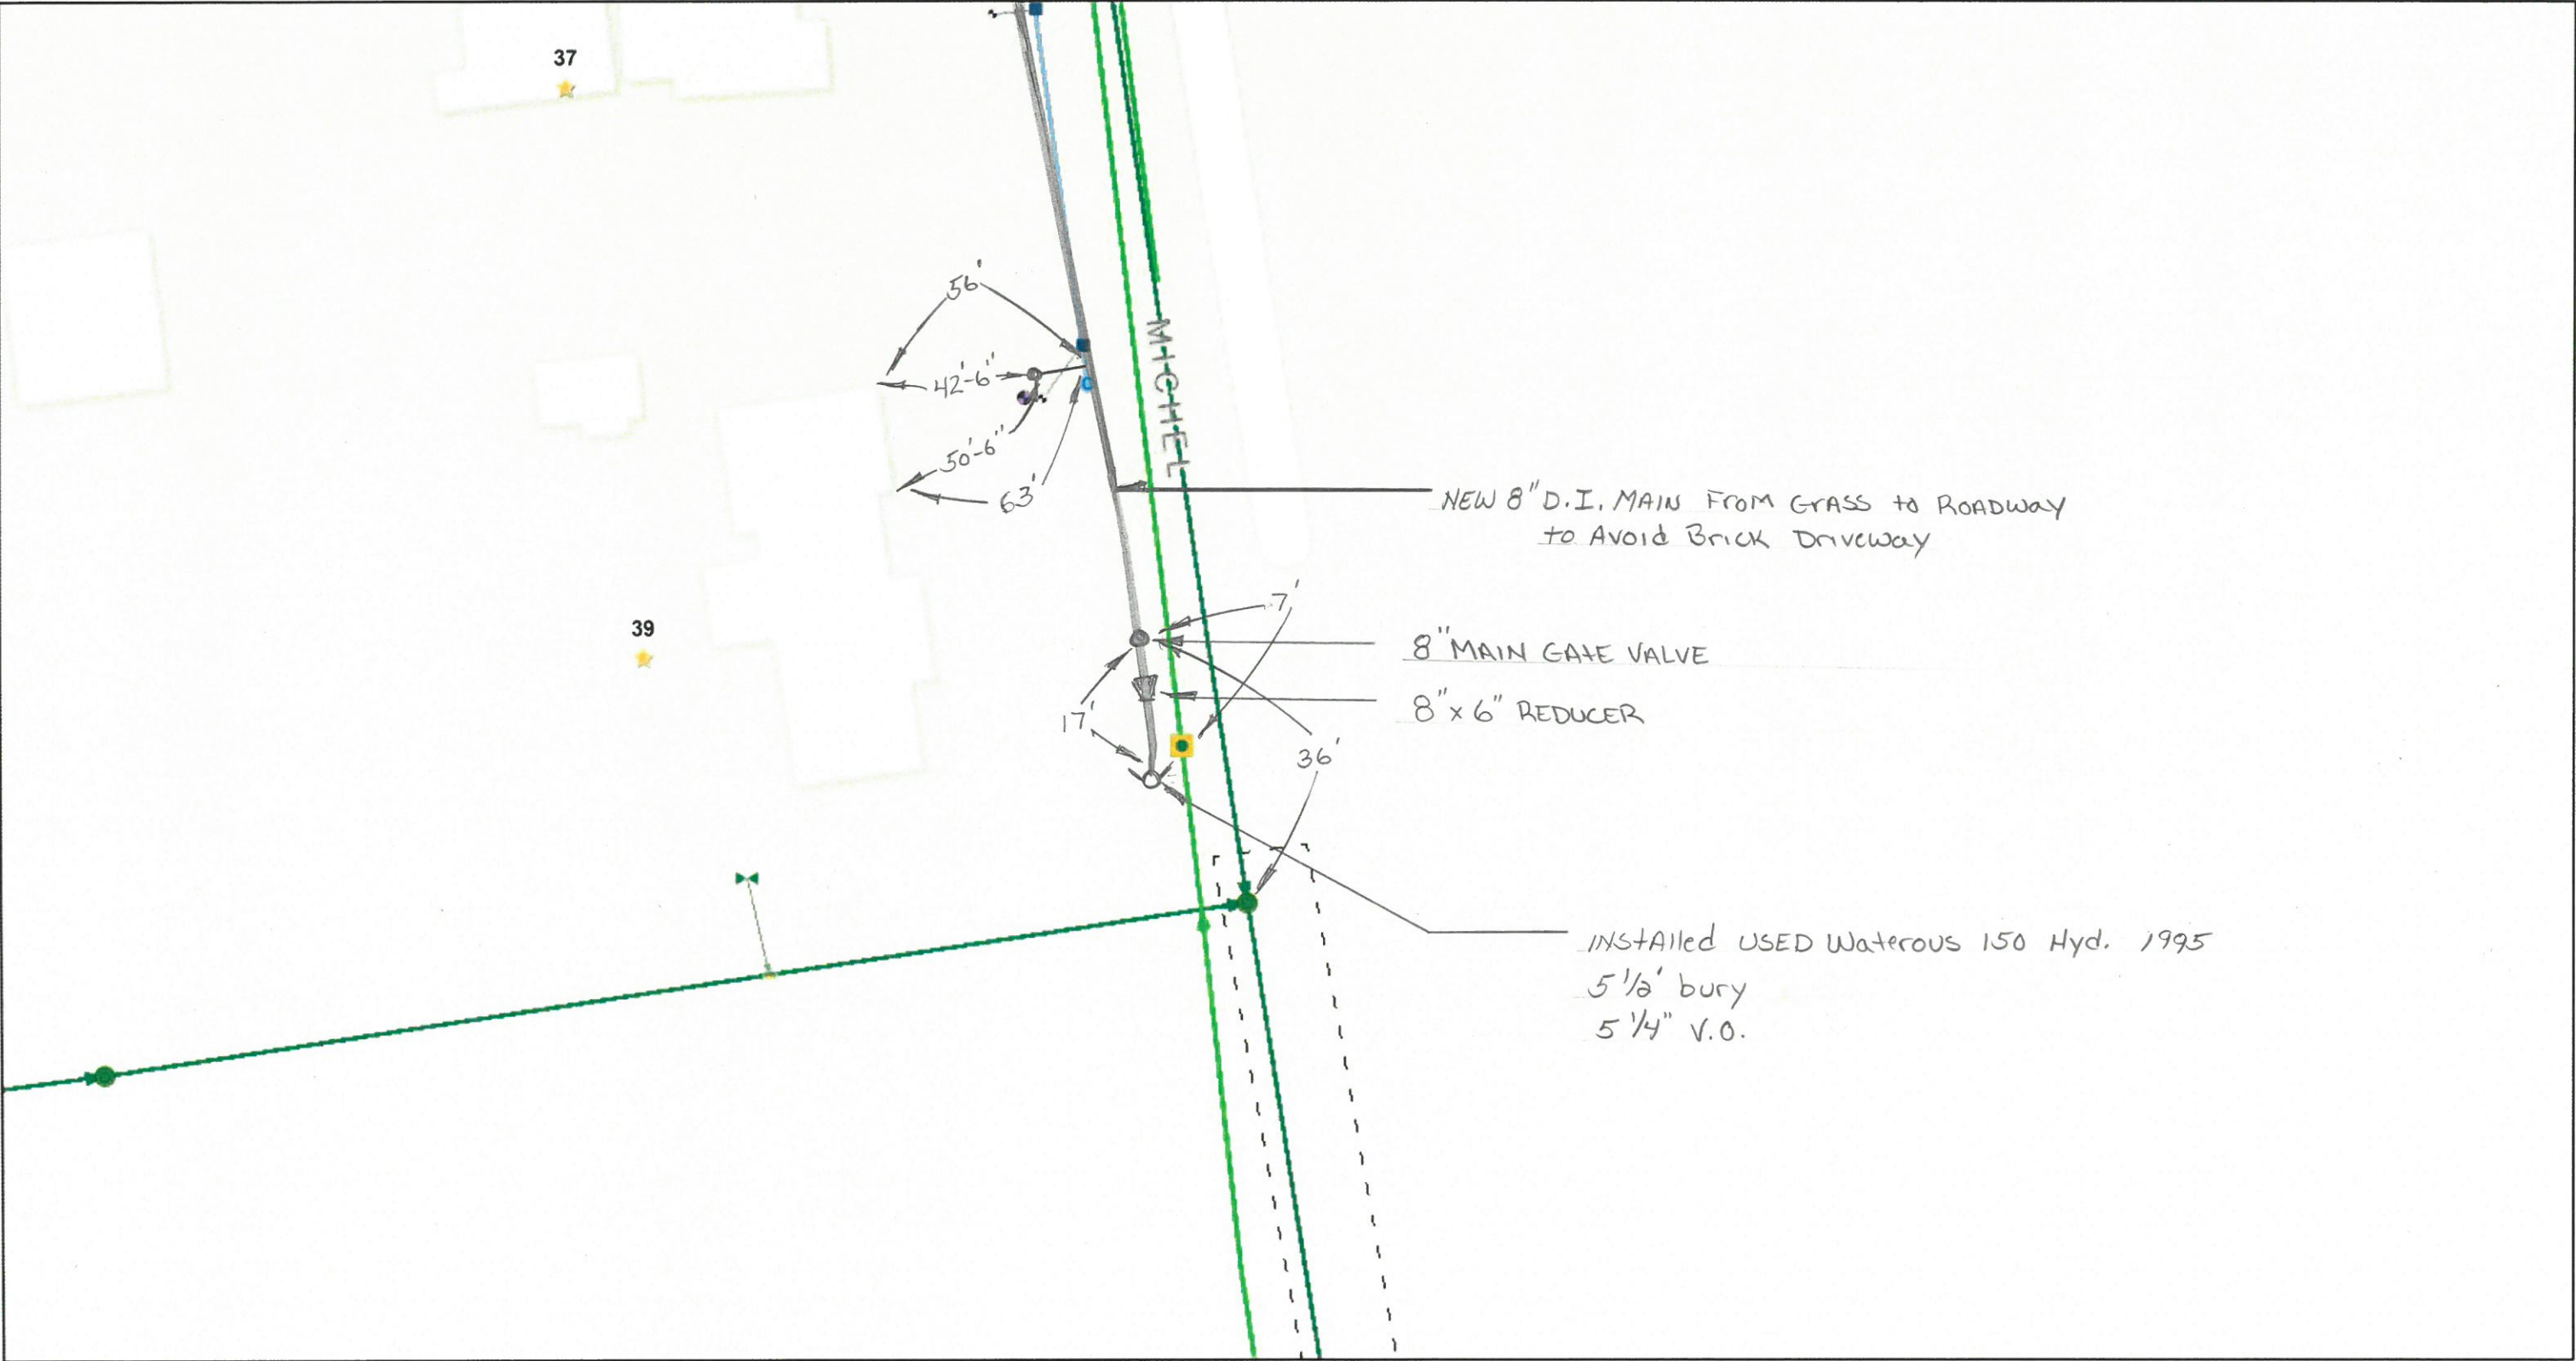

7/22/2019, 8:11:30 AM

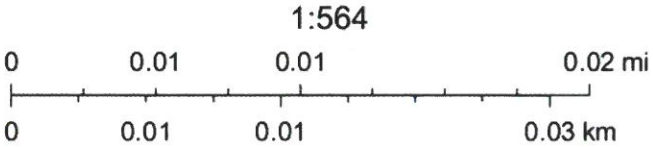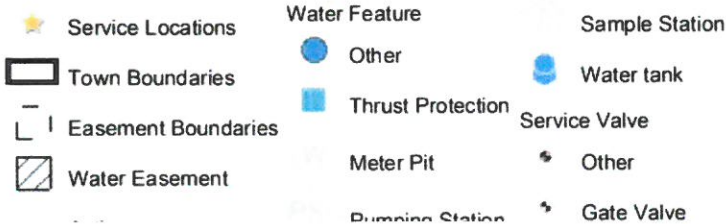

Sources: Esri, HERE, Garmin, USGS, Intermap, INCREMENT P, NRCan, Esri Japan, METI, Esri China (Hong Kong), Esri Korea, Esri (Thailand), NGCC, (c) OpenStreetMap contributors, and the GIS