EAST LONGMEADOW DEPARTMENT OF PUBLIC WORKS

Job: North Main St & Harkness Ave Intersection

Sheet No: (water) of

Calculated By: Pope Date 12-4-2018
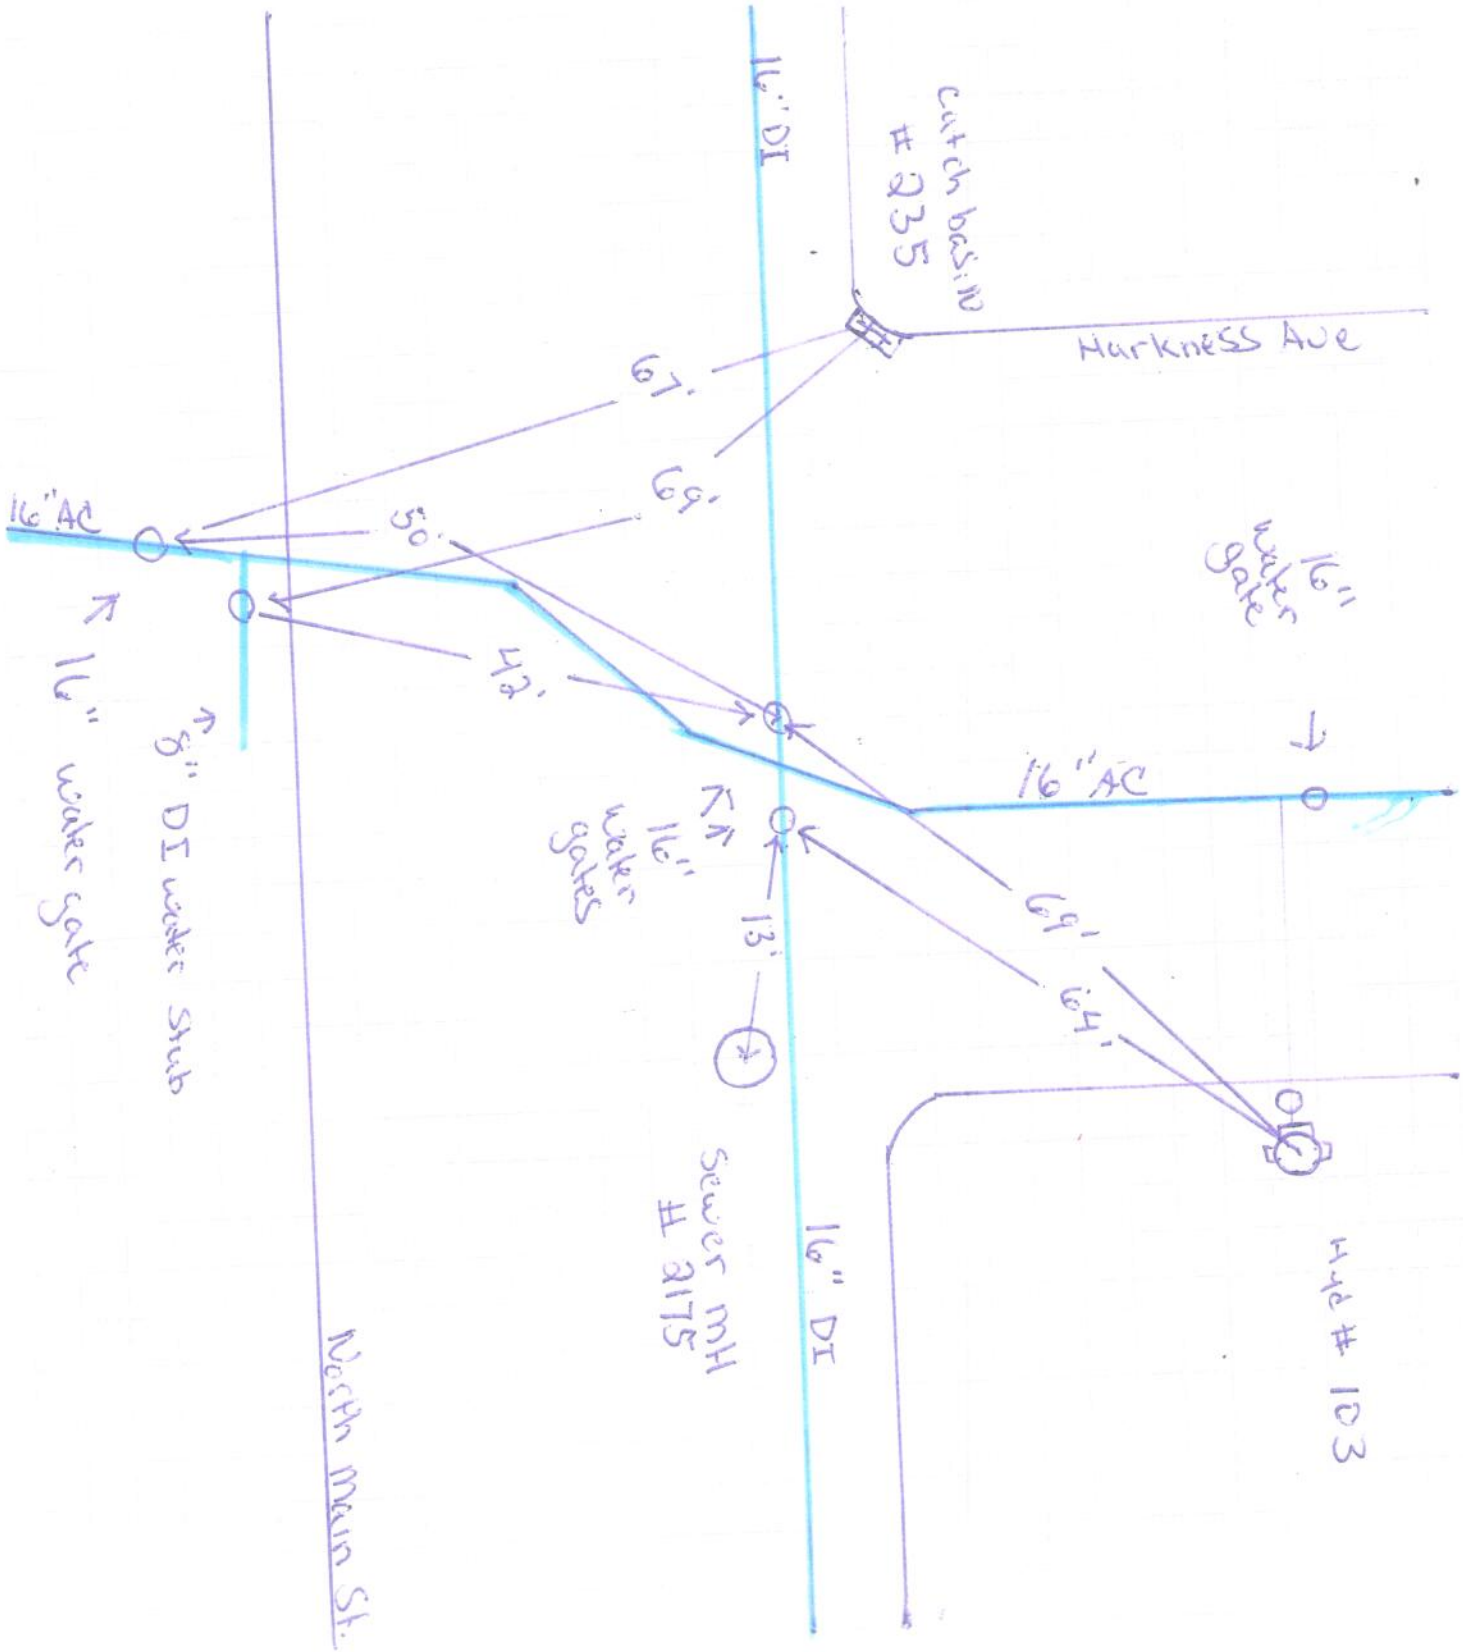
Scale: