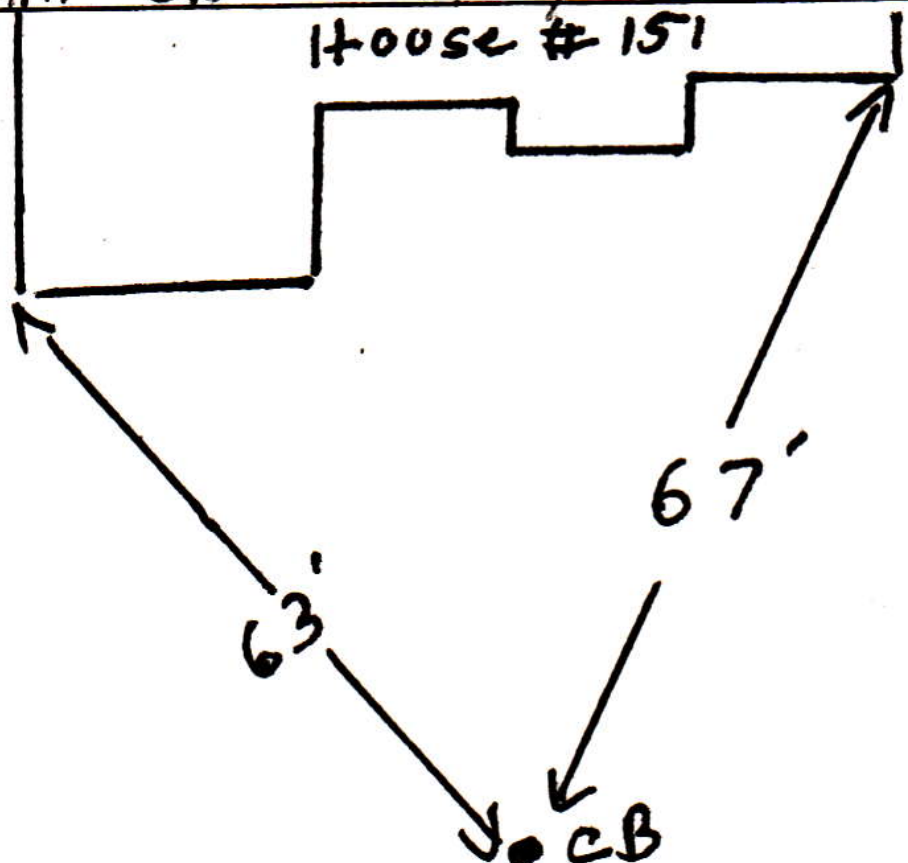| NO. STREET | Lot #18 | DATE INST. | MAKE: | SIZE |
|---|---|---|---|---|
| 151 NOTTINGHAM DR. | | 9/23/03 | BADGER | 1" |