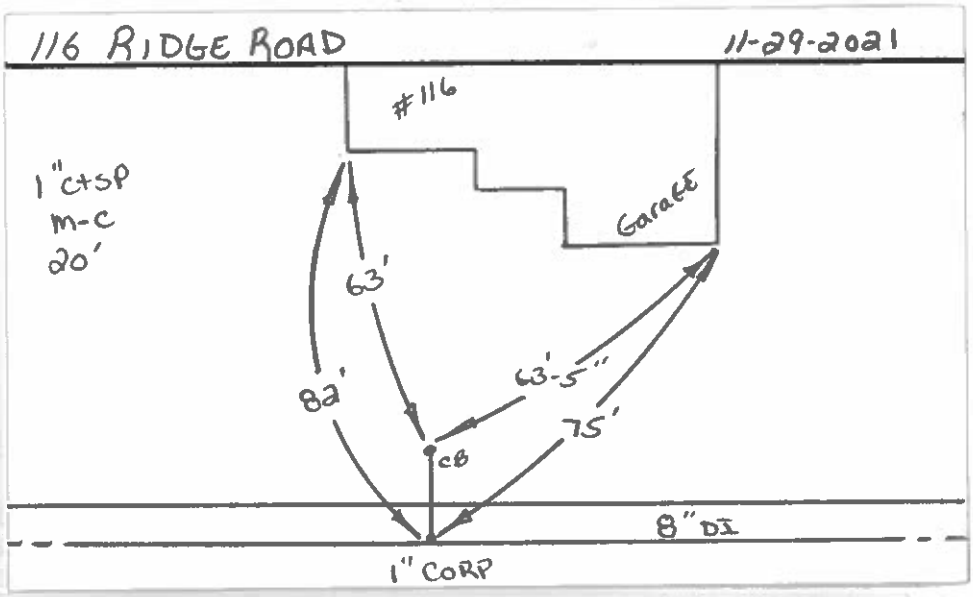
116 RIDGE ROAD
11-29-2021
#116
Garage
1" CTSP
M-C
20'
63'
82'
63'-5"
75'
CB
8" DI
1" CORP