EAST LONGMEADOW DEPARTMENT OF PUBLIC WORKS

Job: 5 Robin Road Water

Sheet No: _____ of _____

Calculated By: A Crochetiere Date 10-20-21

Scale: water Tie.

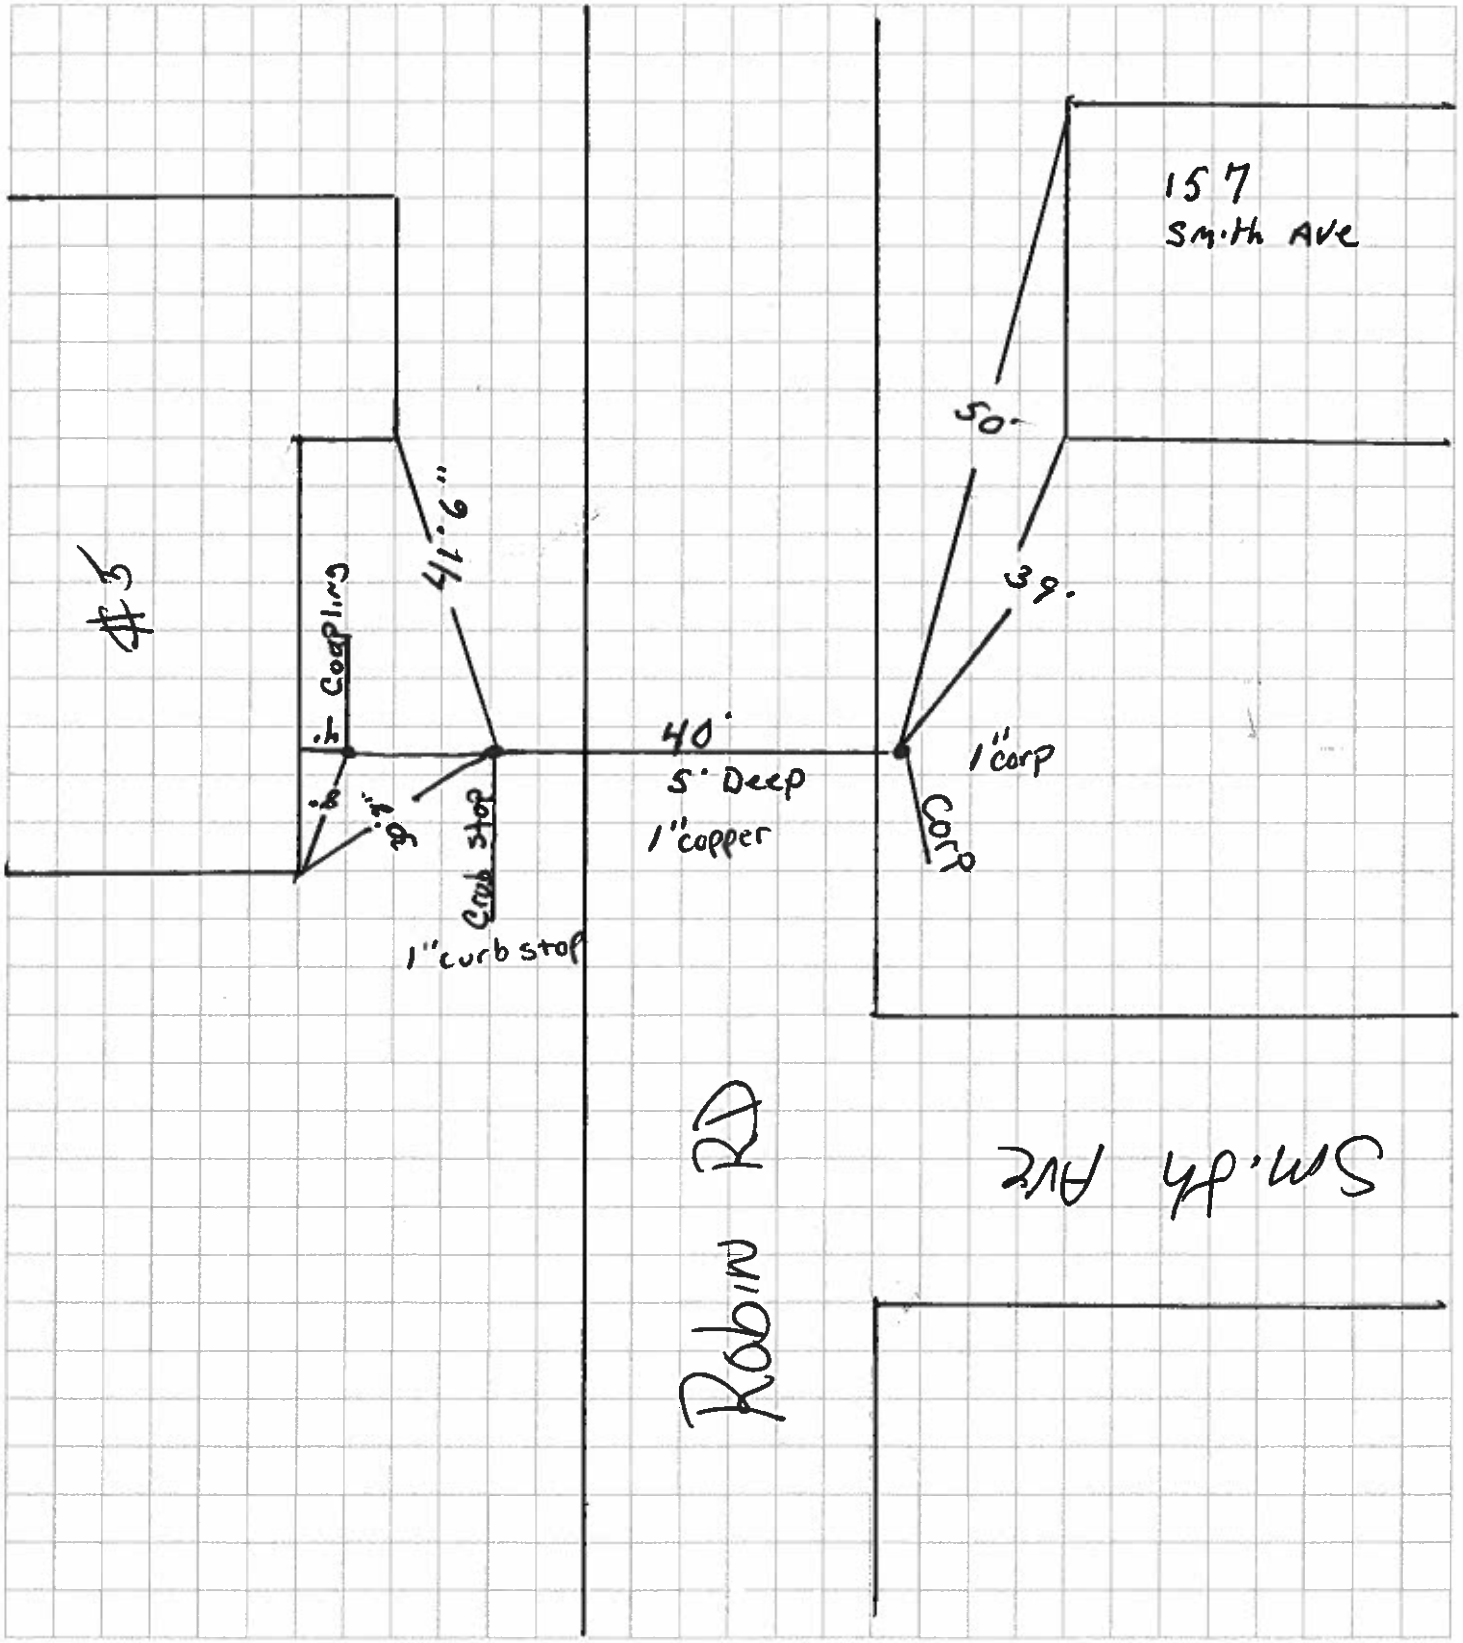

POS Reorder # 1923506