


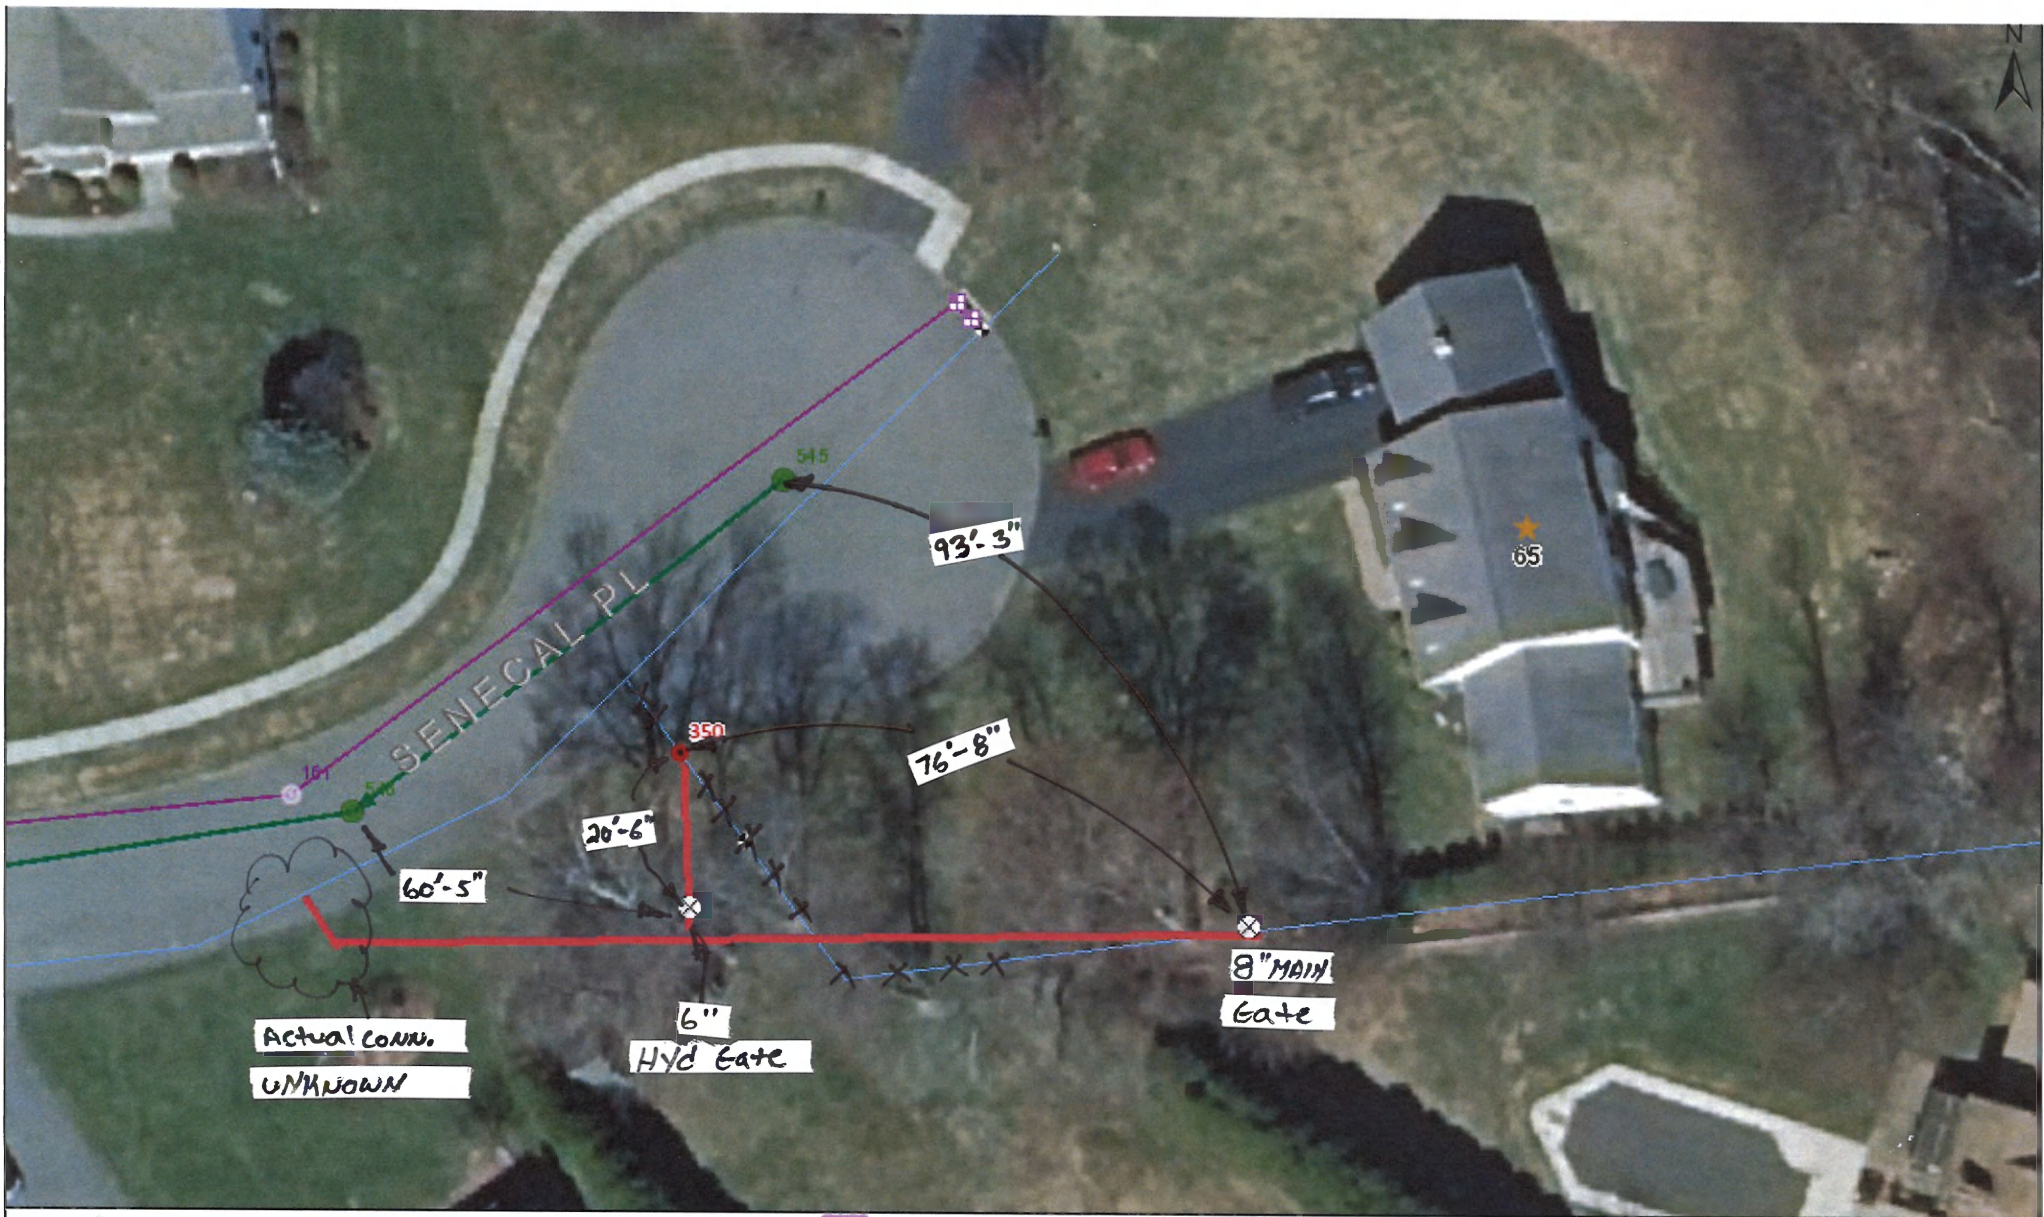

● Active Sewer Manhole	■ Chimney fitting	■ Undigitized Catch Basin	■ Detention Basin	● Coupling	■ Water Meter Pit
● Abandoned Sewer Manhole	▲ Reducer	▲ Other Drain Features	■ Drain Easement	● Other Water Valve	■ Water Pumping Station
✚ Sewer Connection	→ Sewer Lateral	● Capped End	● Hydrant	● Gate Valve	● Fire Pump
■ Other Features	→ Gravity Sewage Main	▲ Flared End Structure	■ Other Water Fitting	● Butterfly Valve	● Sample Station
■ Wet Well	→ Forced Sewage Main	■ Headwall; Endwall	● Bend Fitting	● Blow Off Valve	● Water tank
● Pump Station	→ Abandoned Gravity Sewage Main	■ Rip-rap	● Cap Fitting	● Other Service Valve	■ Water Main
● Other Fittings	→ Abandoned Forced Sewage Main	● Drain Manholes	● Cross Fitting	● Gate Valve	■ Abandoned / Inactive Water Main
● Bend fitting	■ Concrete Encasement	● Outfalls	● Plug Fitting	● Butterfly Valve	■ Proposed Water Main
● Tee Wye; Tee fitting; Wye fitting	■ Steel Sleeve	→ Drain Line	● Increaser; Reducer	● Blow Off Valve	■ Abandoned Water Lateral
● Cap fitting	■ DI Sleeve	→ Open Channel	● Tap Fitting	● Other Water Feature	■ Proposed Water Lateral
● Clean-out fitting	■ Catch Basin	● Culvert	● Tee Fitting	■ Thrust Protection	



1 inch = 47 feet
8/15/2025

