


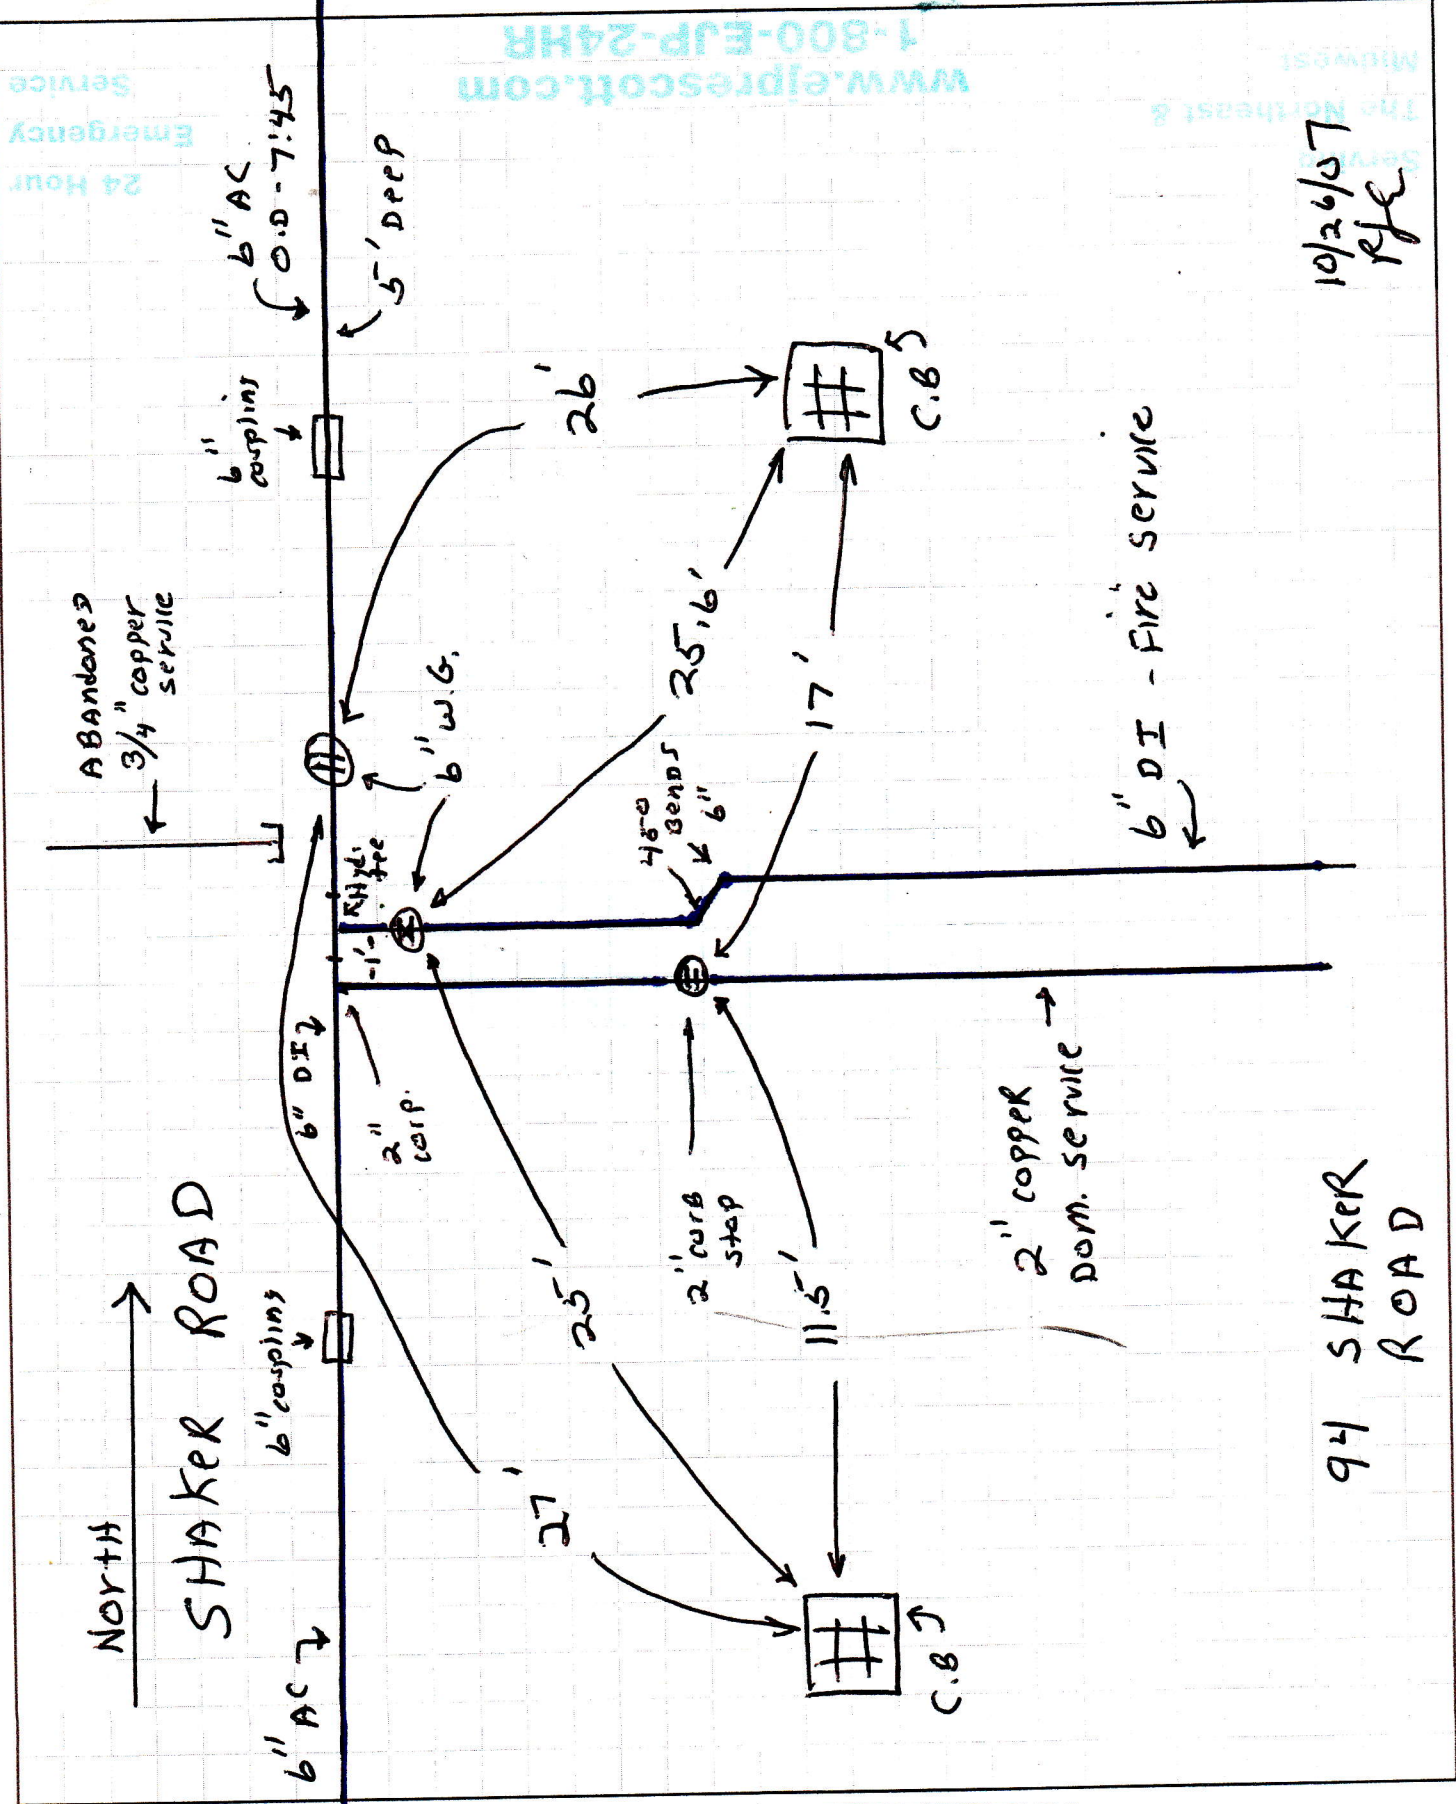

JOB _____

SHEET _____

NO.: _____

CALCULATED _____

BY: _____

SCALE _____

DATE _____

OF _____



Everett J. Prescott, Inc.

10/26/07
RJE

94 SHAKER ROAD

www.ejprescott.com
1-800-EJP-24HR

24 Hour
Emergency
Service

The Northeast &
Midwest