


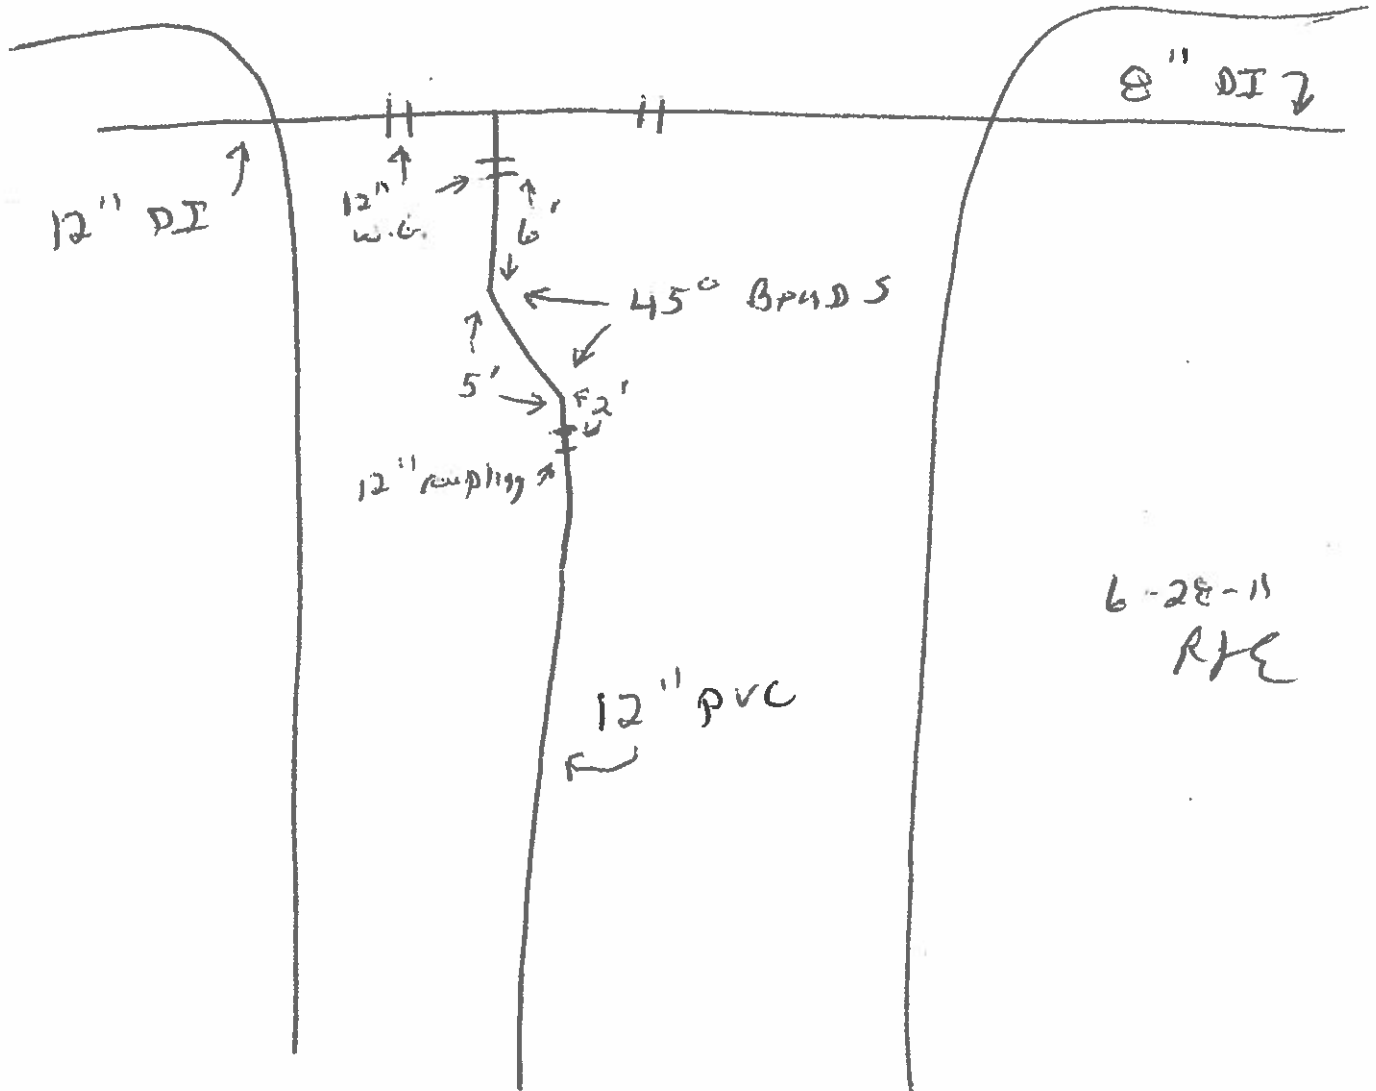

SHAKER ROAD



DEER PARK
DRIVE