Pipeline Specialists

TEAM EJP

Everett J. Prescott, Inc.

JOB

SHEET NO.: OF

CALCULATED BY: DATE

SCALE

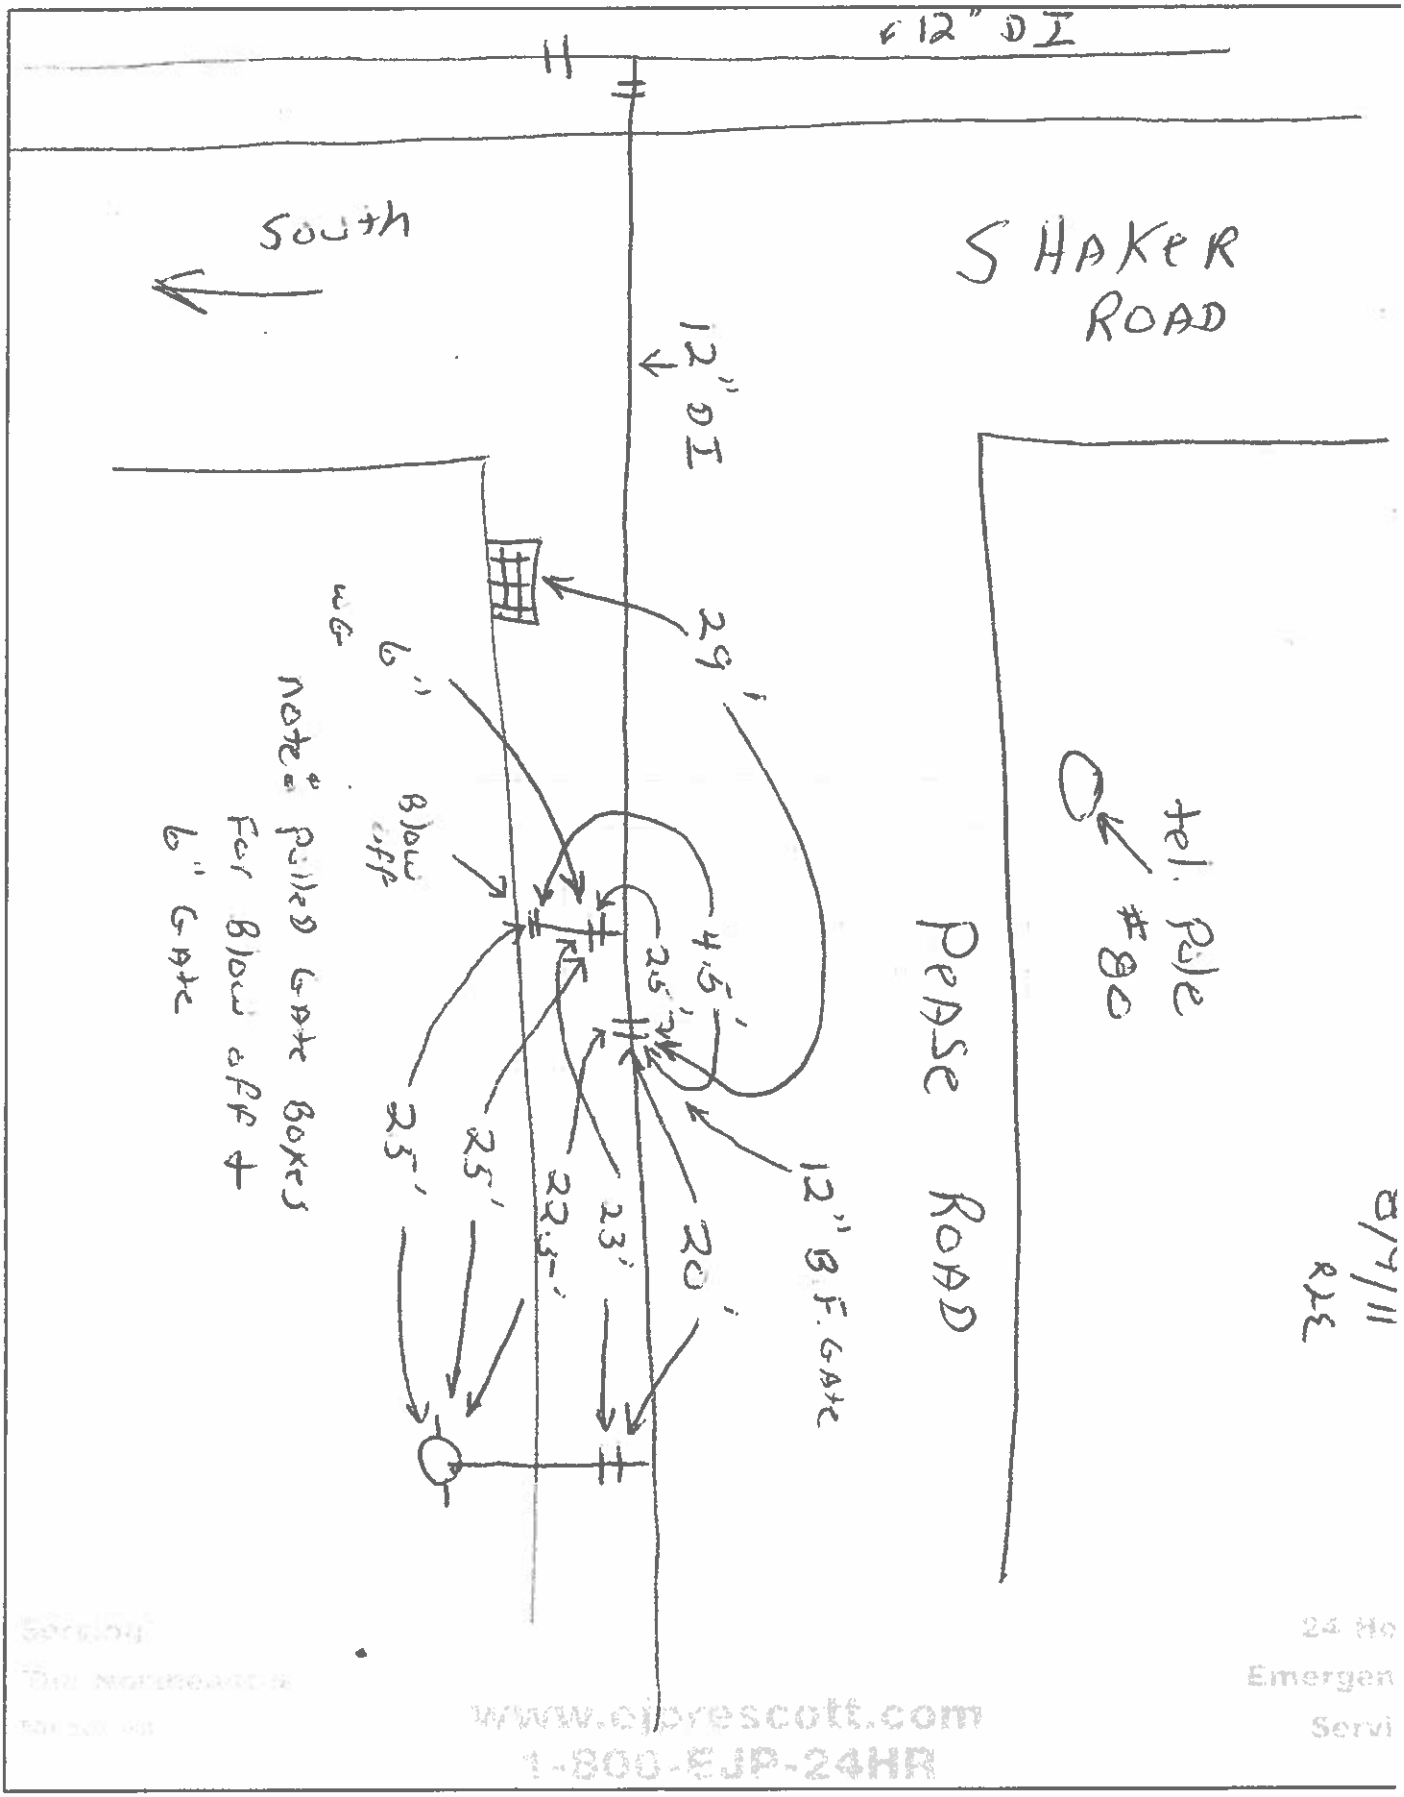

www.ejprescott.com
1-800-EJP-24HR