EAST LONGMEADOW DEPARTMENT OF PUBLIC WORKS

Job: 64 Waterman Ave (Water)

Sheet No: _____ of _____

Calculated By: Pope Date 11-21-17
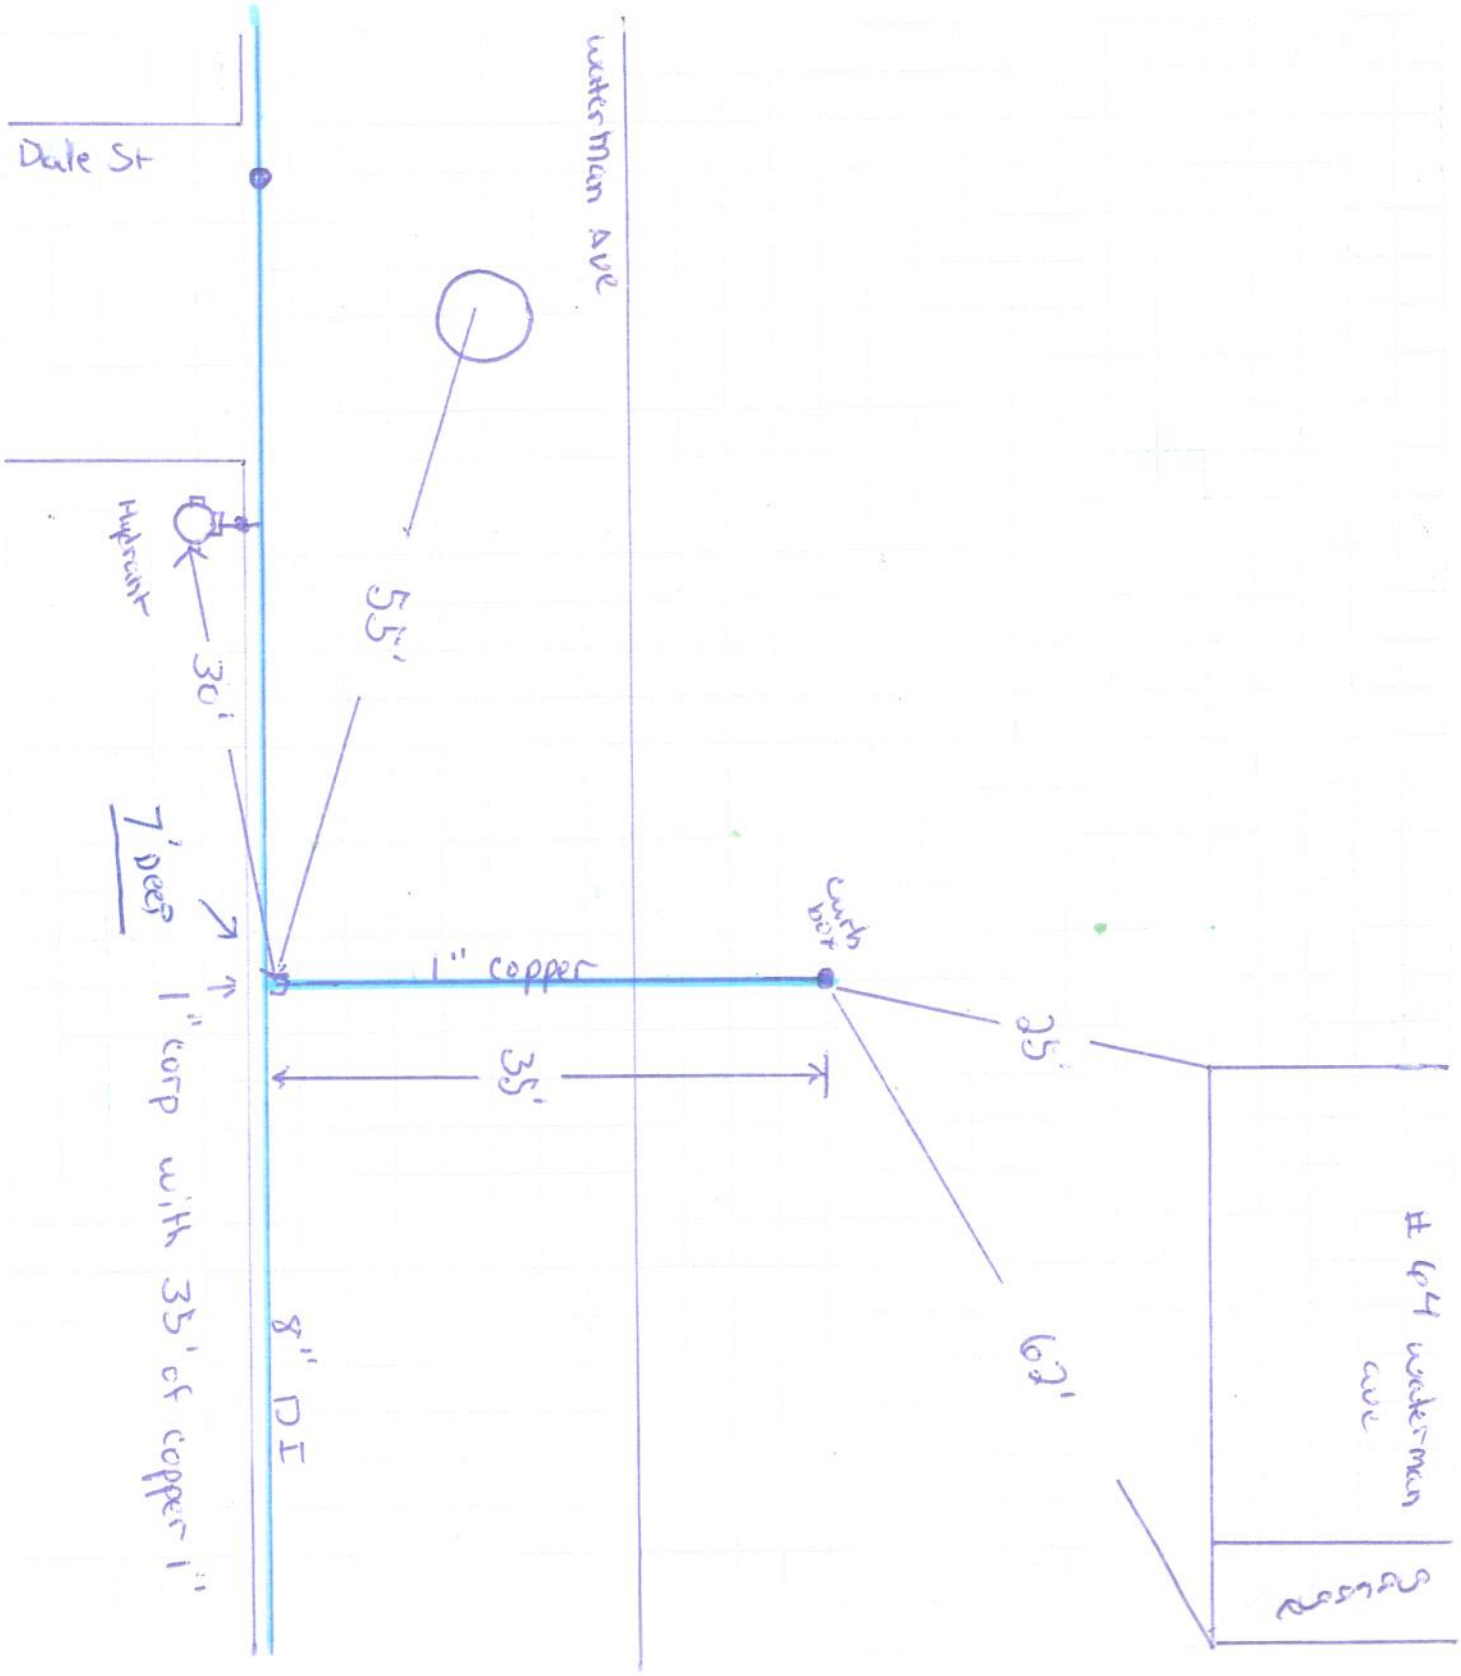
Scale: _____