


124 Westwood Avenue

1994

124

1" cts p m-c

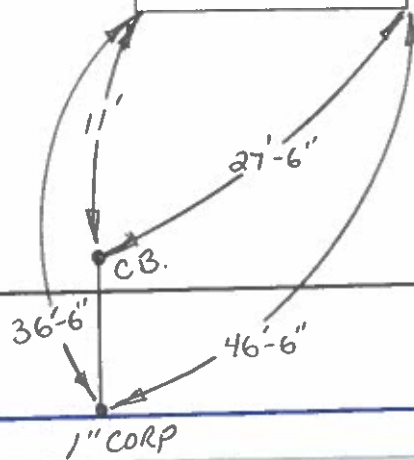

12" DI MAIN