


191 Westwood Avenue

1994

Vineyard
Avenue

#191

1" CTSR m-c

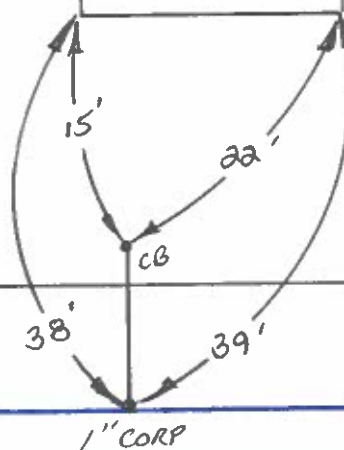

12" DI MAIN

1" CORP