


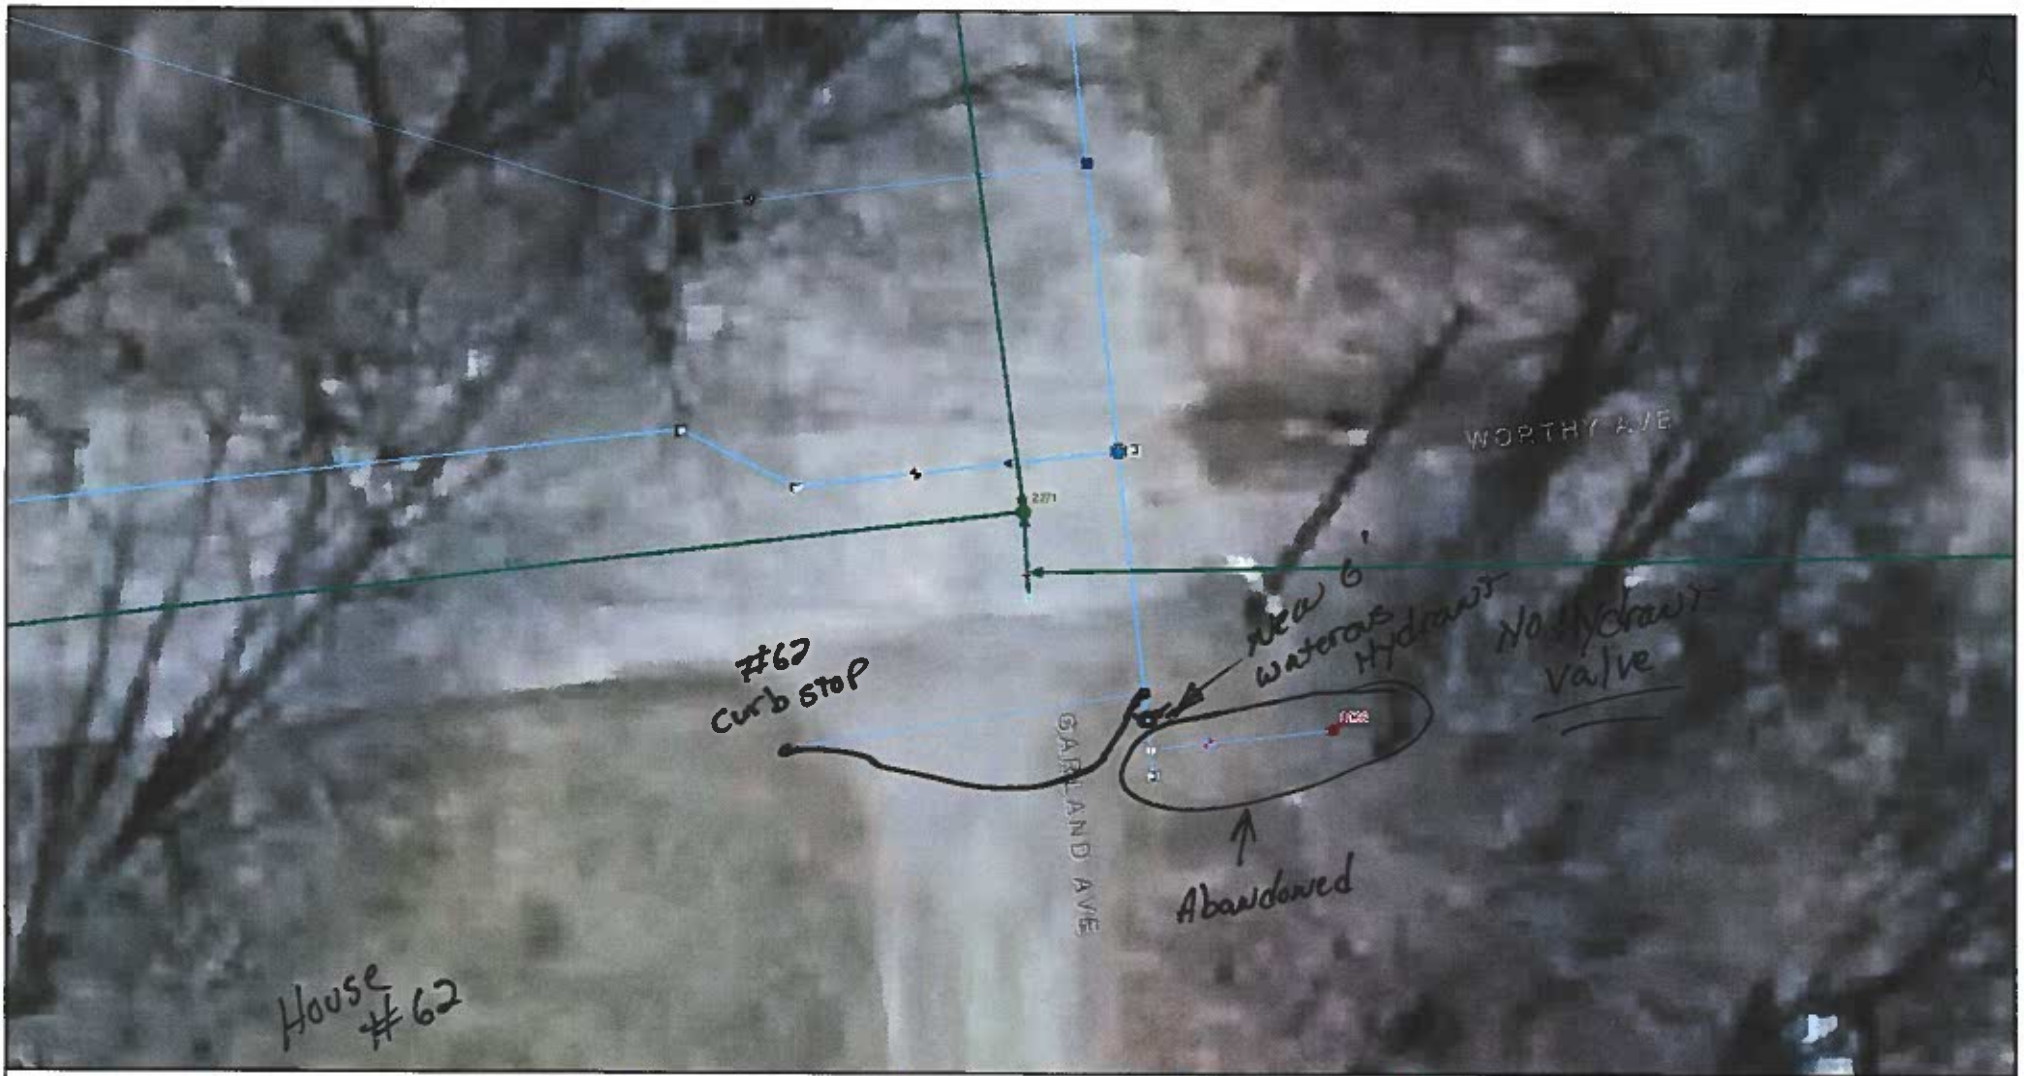

- Active Sewer Manhole - Abandoned Sewer Manhole - Sewer Connection - Other Features - Wet Well - Pump Station - Other Fittings	- Bend Fitting - Tee Wye; Tee fitting; Wye fitting - Cap fitting - Clean-out fitting - Chimney fitting - Reducer - Sewer Lateral - Gravily Sewage Main - Forced Sewage Main	- Abandoned Gravily Sewage Main - Abandoned Forced Sewage Main - Concrete Encasement - Steel Sleeve - DI Sleeve - Catch Basin - Undigitized Catch Basin - Other Drain Features	- Capped End - Flared End Structure - Headwall; Endwall - Rip-rap - Drain Manholes - Outfalls - Drain Line - Open Channel - Culvert	- Detention Basin - Drain Encasement - Hydrant - Other Water Fitting - Bend Fitting - Cap Fitting	- Cross Fitting - Plug Fitting - Reducer; Reducer - Tap Fitting - Tee Fitting - Coupling - Other Water Valve - Gate Valve - Butterfly Valve - Blow Off Valve	- Other Service Valve - Gate Valve - Butterfly Valve - Blow Off Valve - Other Water Feature - Thrust Protection	- Water Meter Pit - Water Pumping Station - Fire Pump - Sample Station - Water tank - Water Main - Abandoned / Inactive Water Main - Proposed Water Main	- Abandoned Water Lateral - Proposed Water Lateral - Water Lateral - Water Encasement - Encasement Boundaries - Break Out Tanks - UNG's - Pipelines	The Town of East Longmeadow and its mapping contractors assume no legal responsibility for the information contained herein. These data are not suitable for engineering applications or site work nor can the data be used to determine absolute elevation. Instead, the data should be used to portray some of uncertainty and possible risks. Map created by East Longmeadow Utilities Application Orthophotography Copyright Google db MapGIS.	1 inch = 12 feet 7/31/2023
---	---	---	---	--	---	--	---	--	---	---------------------------------------