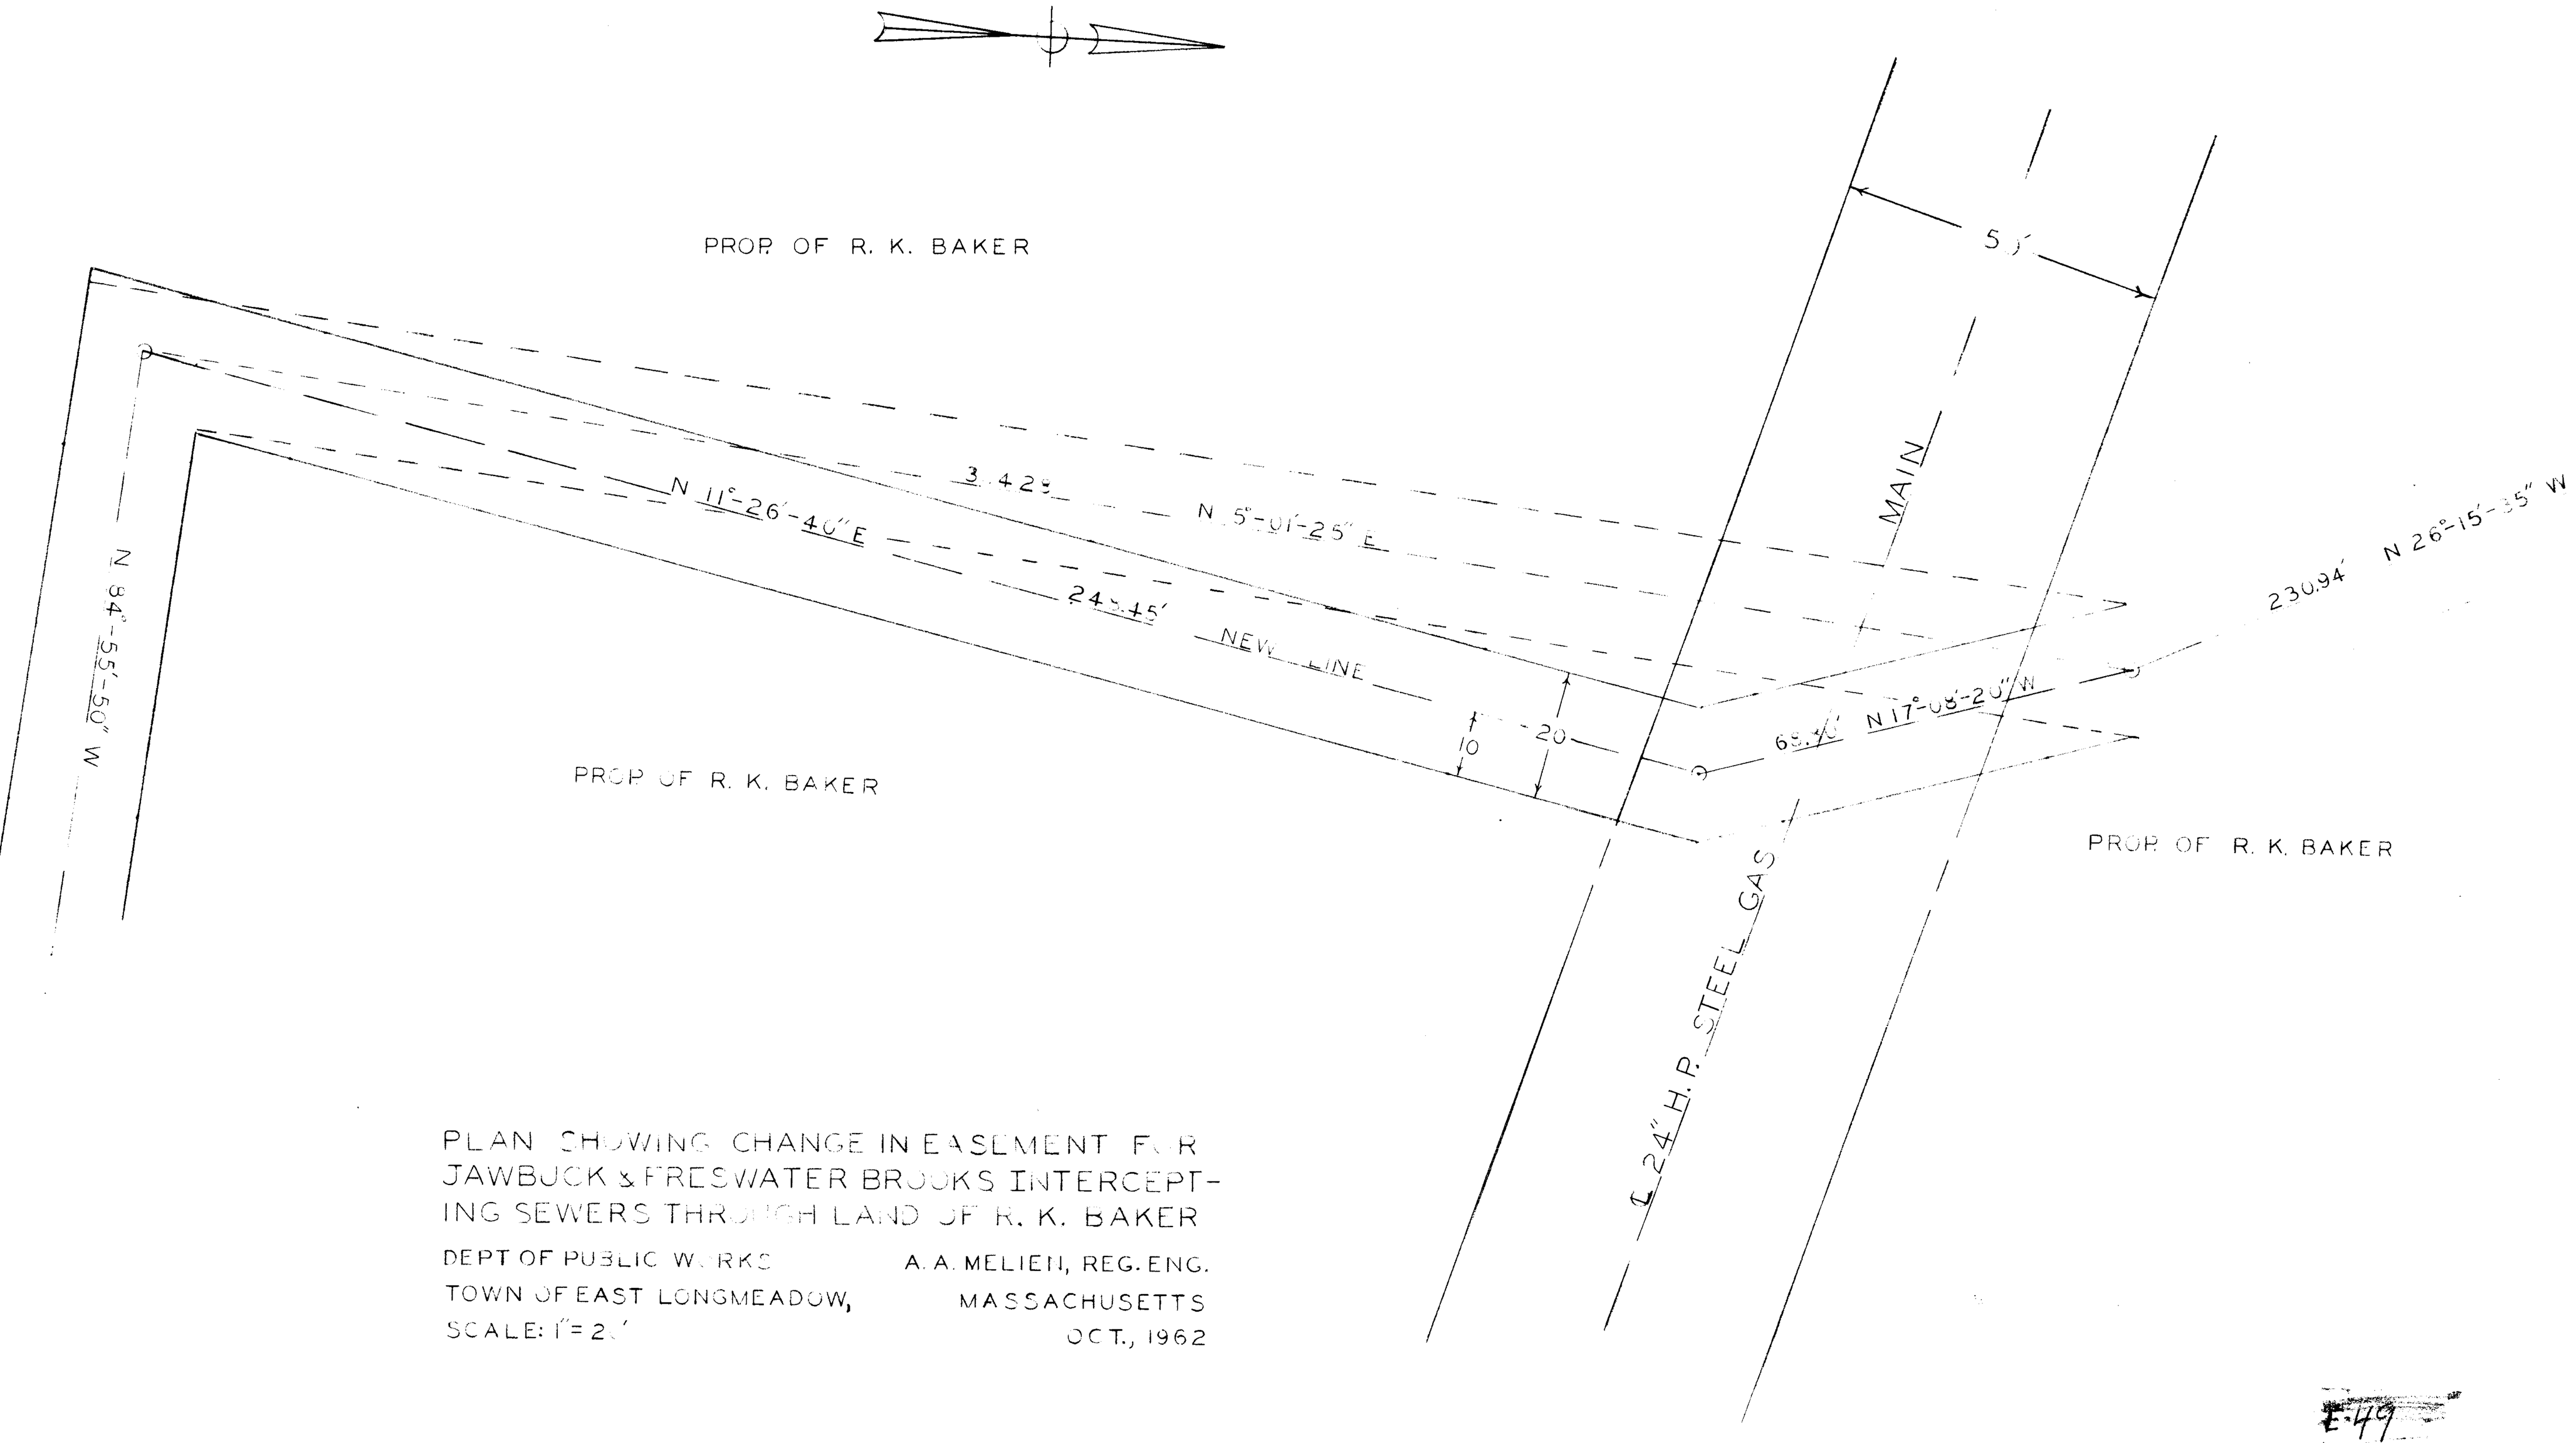

PLAN SHOWING CHANGE IN EASEMENT FOR JAWBUCK & FRESWATER BROOKS INTERCEPTING SEWERS THROUGH LAND OF R. K. BAKER

DEPT OF PUBLIC WORKS
TOWN OF EAST LONGMEADOW,
SCALE: 1" = 20'

A. A. MELIEN, REG. ENG.
MASSACHUSETTS
OCT., 1962

E-49