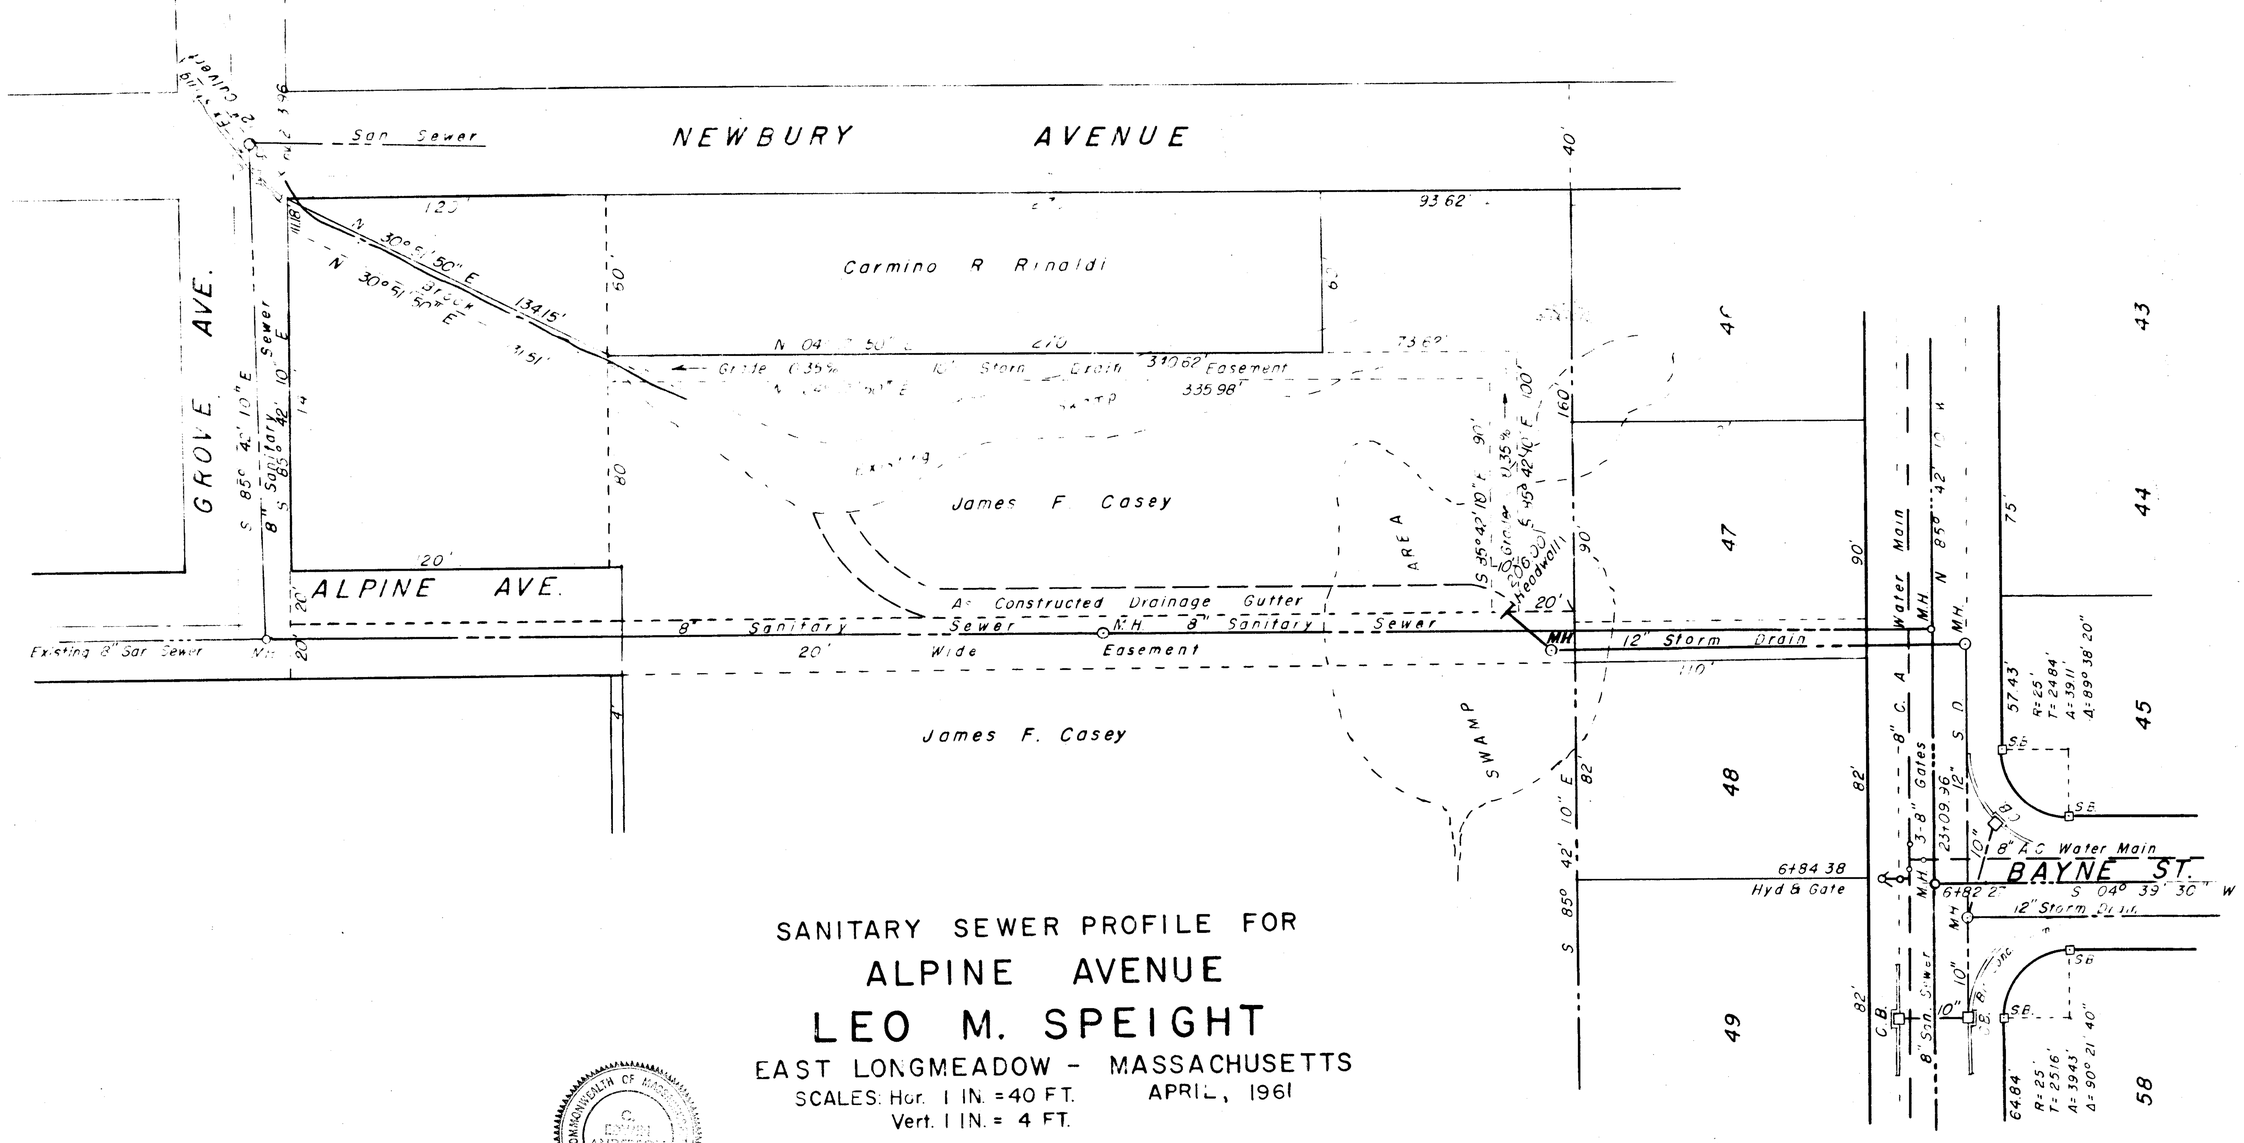

SANITARY SEWER PROFILE FOR

ALPINE AVENUE

LEO M. SPEIGHT

EAST LONGMEADOW - MASSACHUSETTS

SCALES: Hor. 1 IN. = 40 FT. APRIL, 1961
Vert. 1 IN. = 4 FT.

C. E. ANDERSON
ASSOCIATES
Civil Engineers Land Surveyors
Land Planning Consultants
Springfield - Massachusetts

Revised: 10' Storm Drain Easement Shown - March 15, 1963
Revised: As Constructed - Jan. 29, 1963
Revised to April 18, 1961 - Sept., 1961

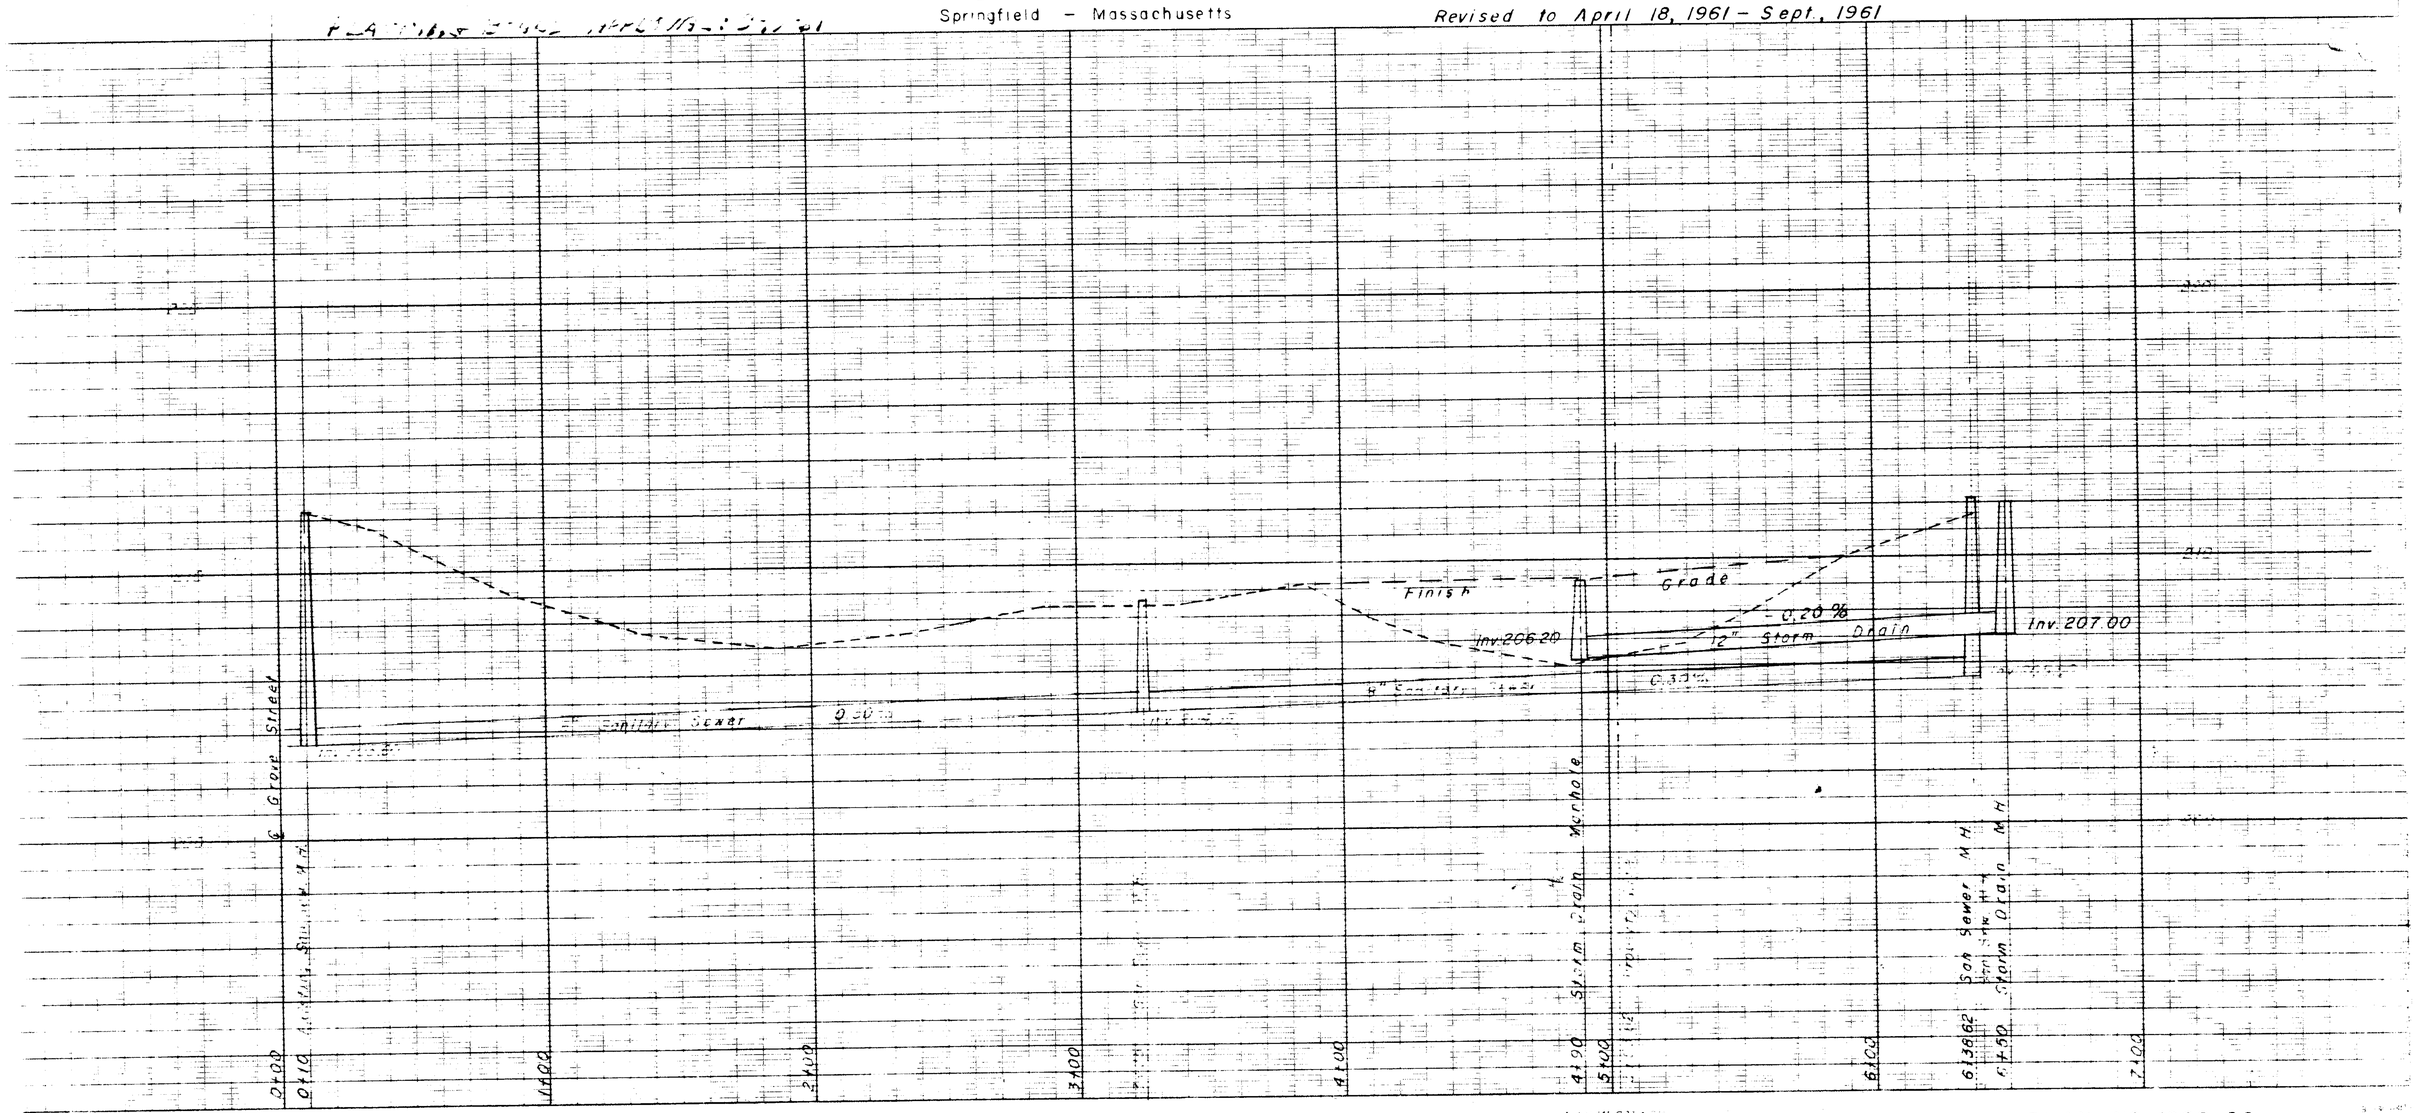

PLAN N° 1200-06

E-60