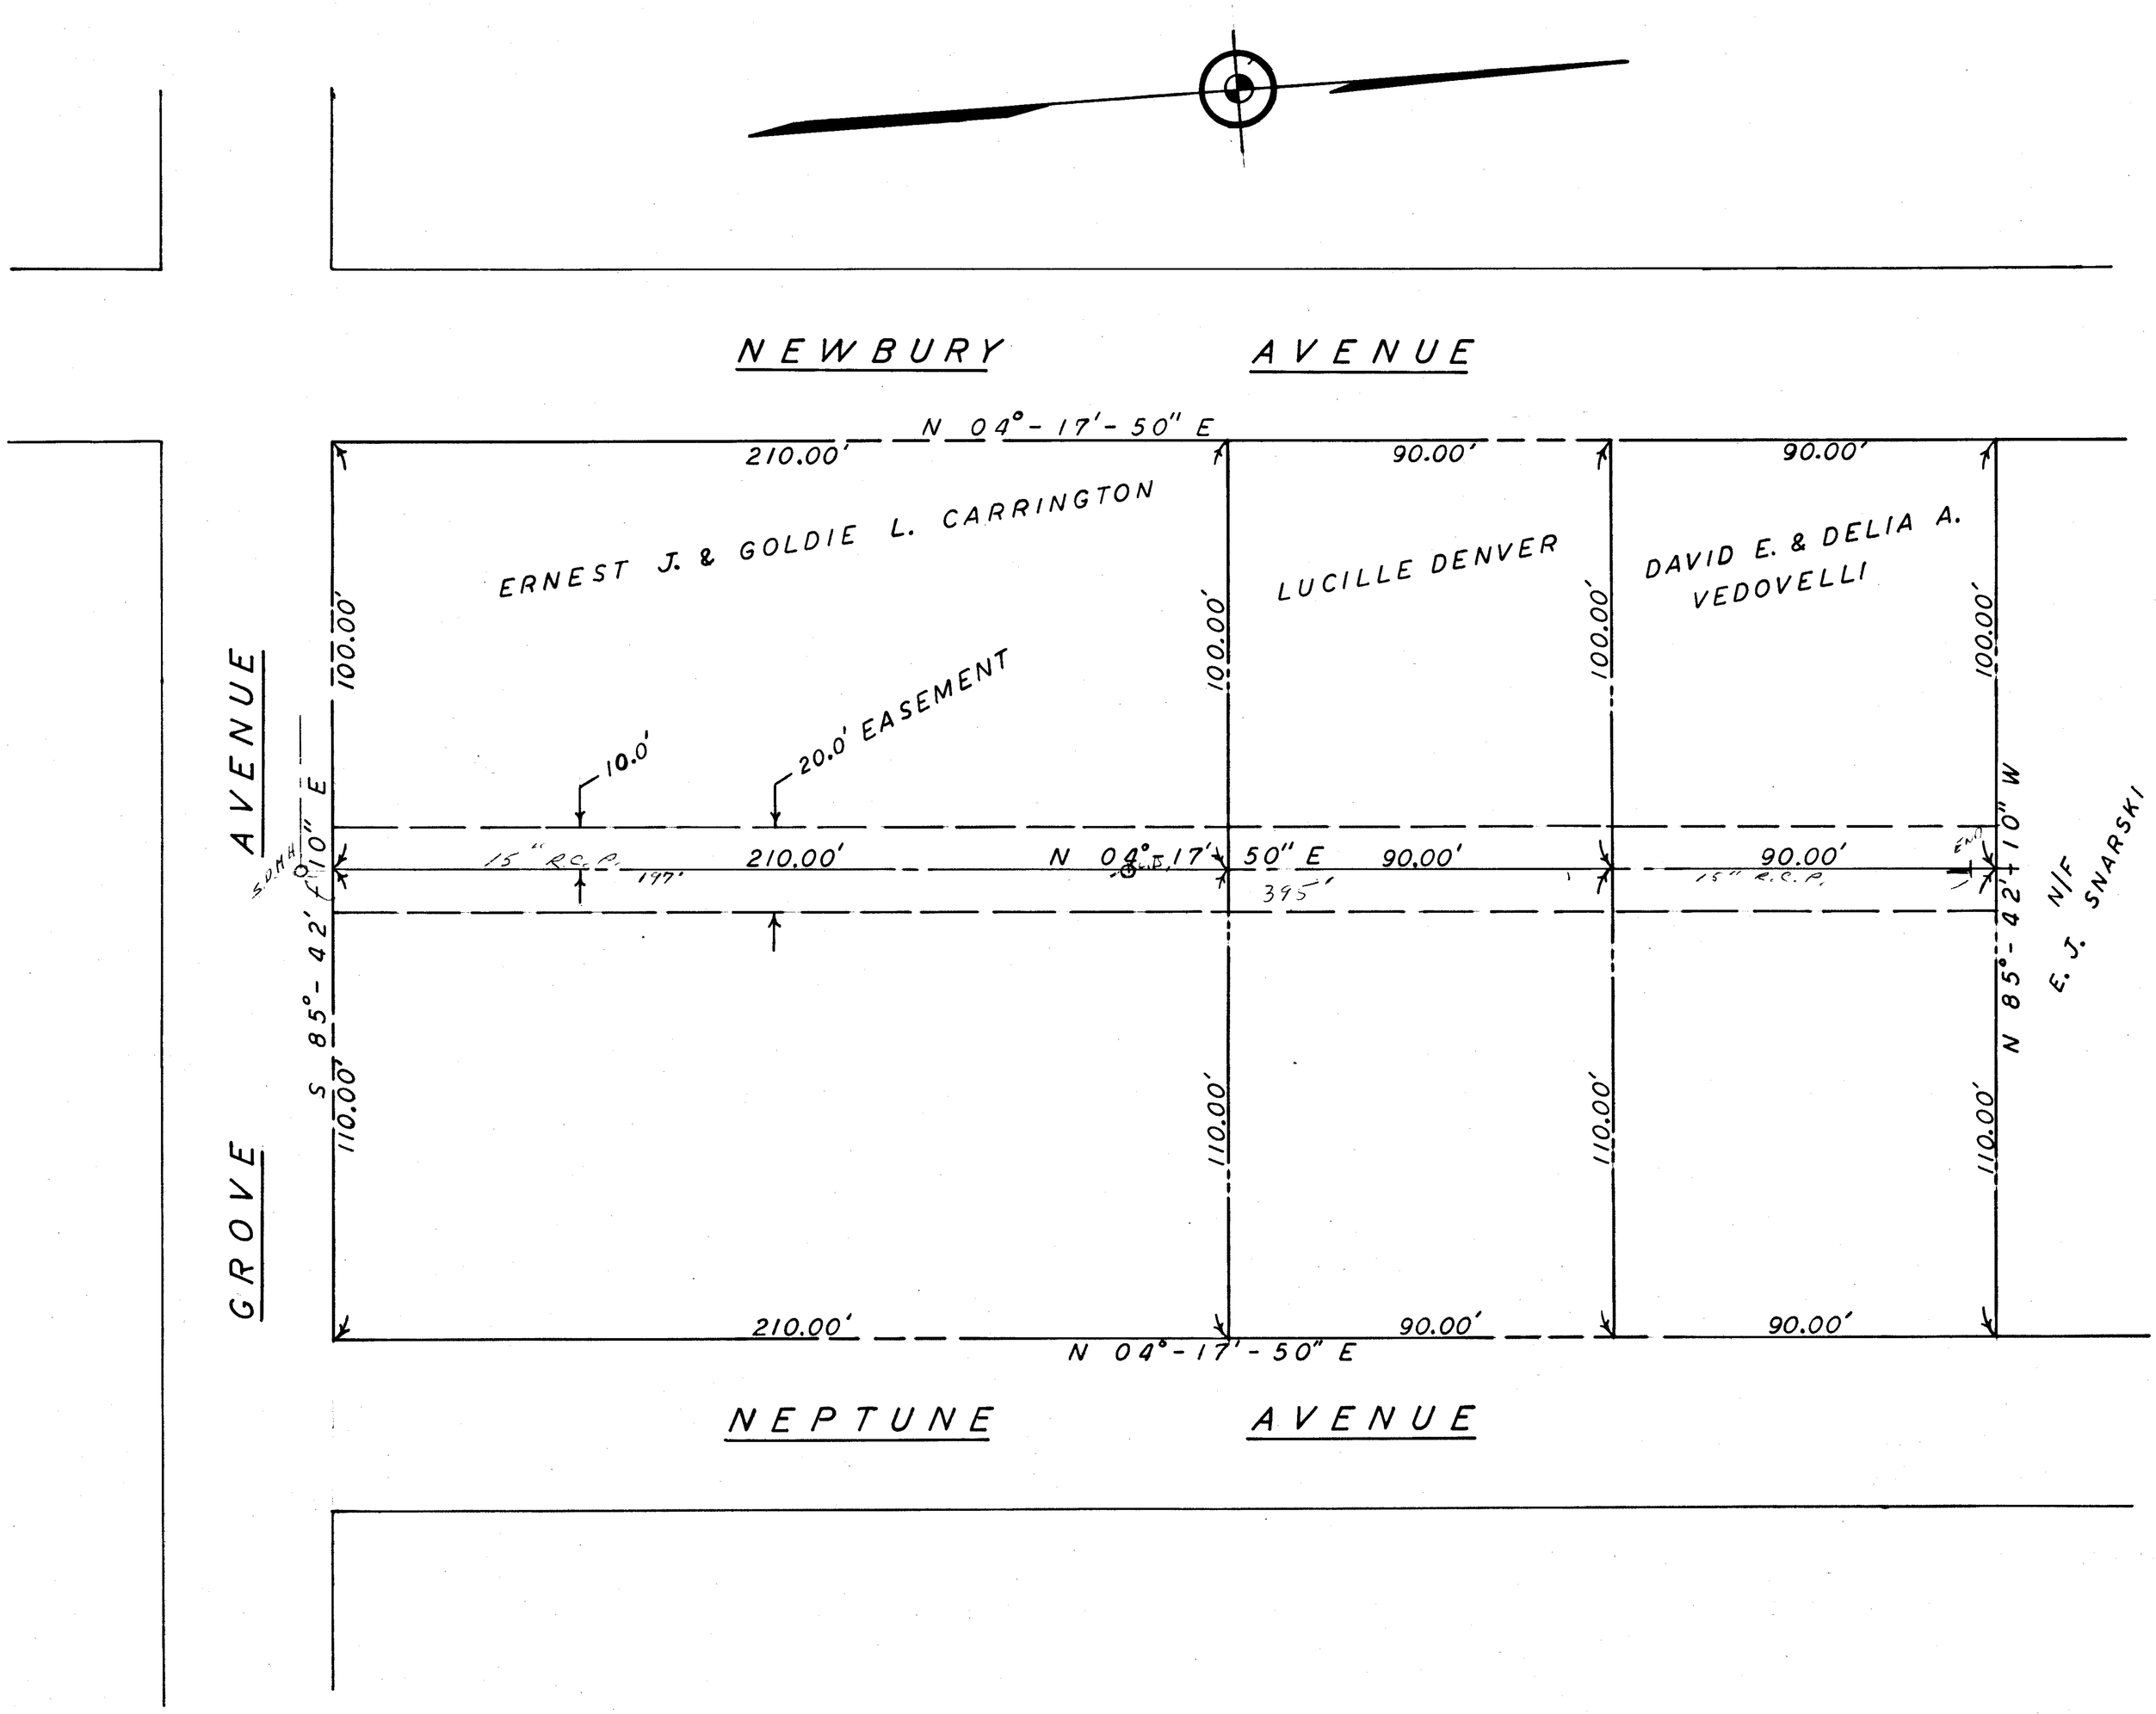

PLAN SHOWING EASEMENT FOR
STORM DRAINAGE PURPOSES
AT
GROVE AVENUE

DEPT OF PUBLIC WORKS A.A.MELIEN, ENG.
TOWN OF EAST LONGMEADOW, MASS.
SCALE: 1" = 30' OCT., 1964

E-78