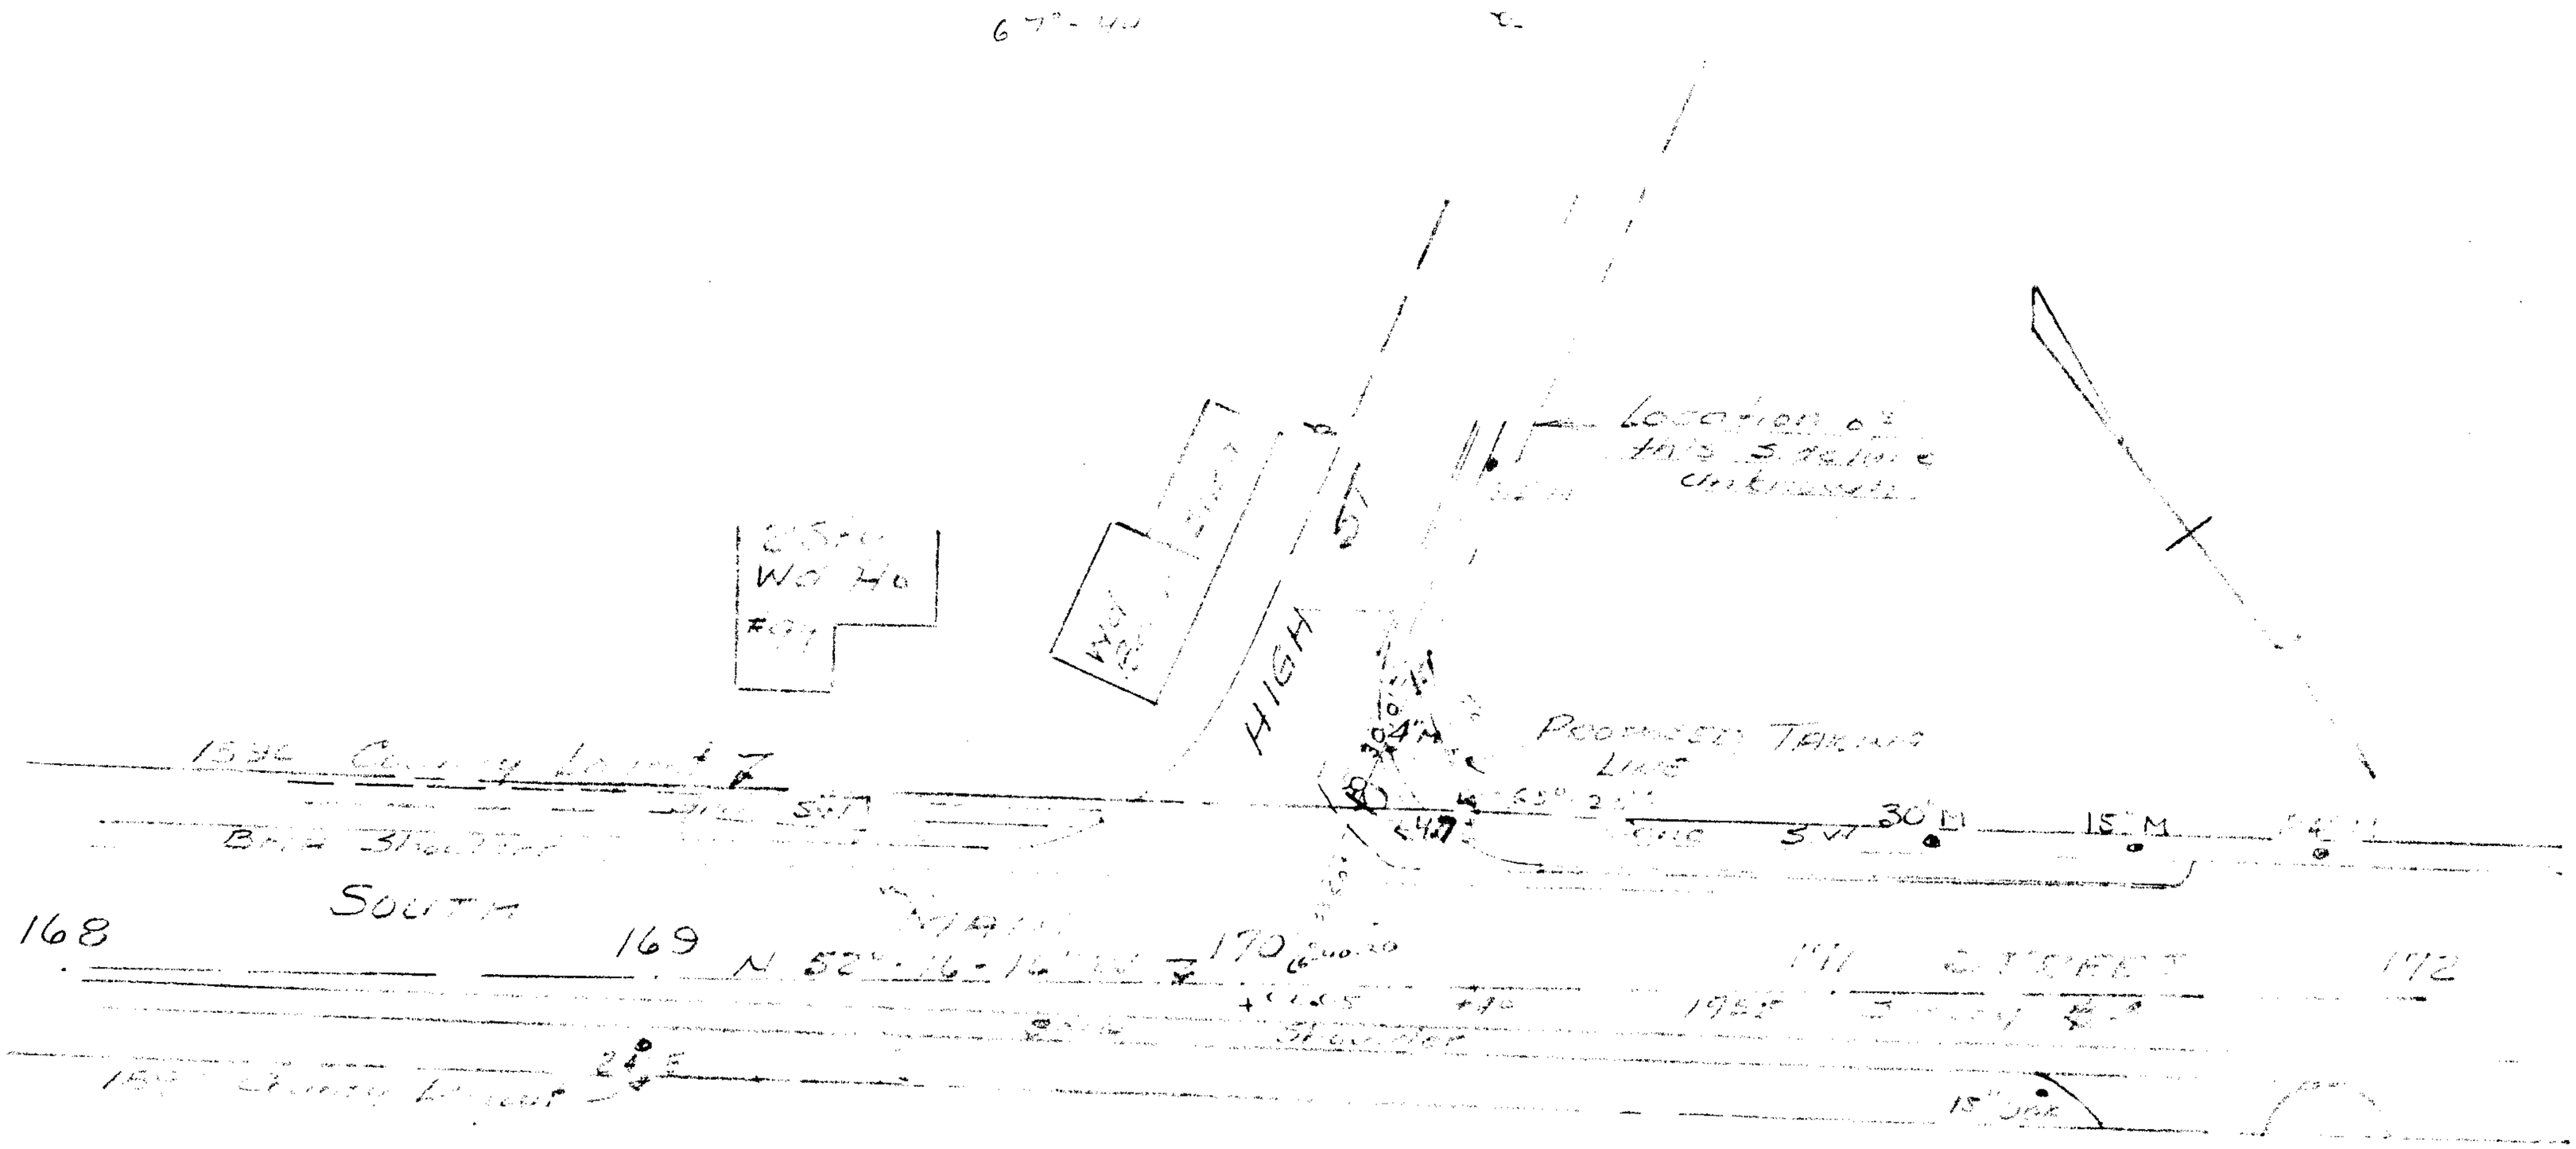
Location of this Structure
HIGH
Proposed Taking Line
30 M
15 M
SOUTH
168
169
170
171
172

DE. 13 (D