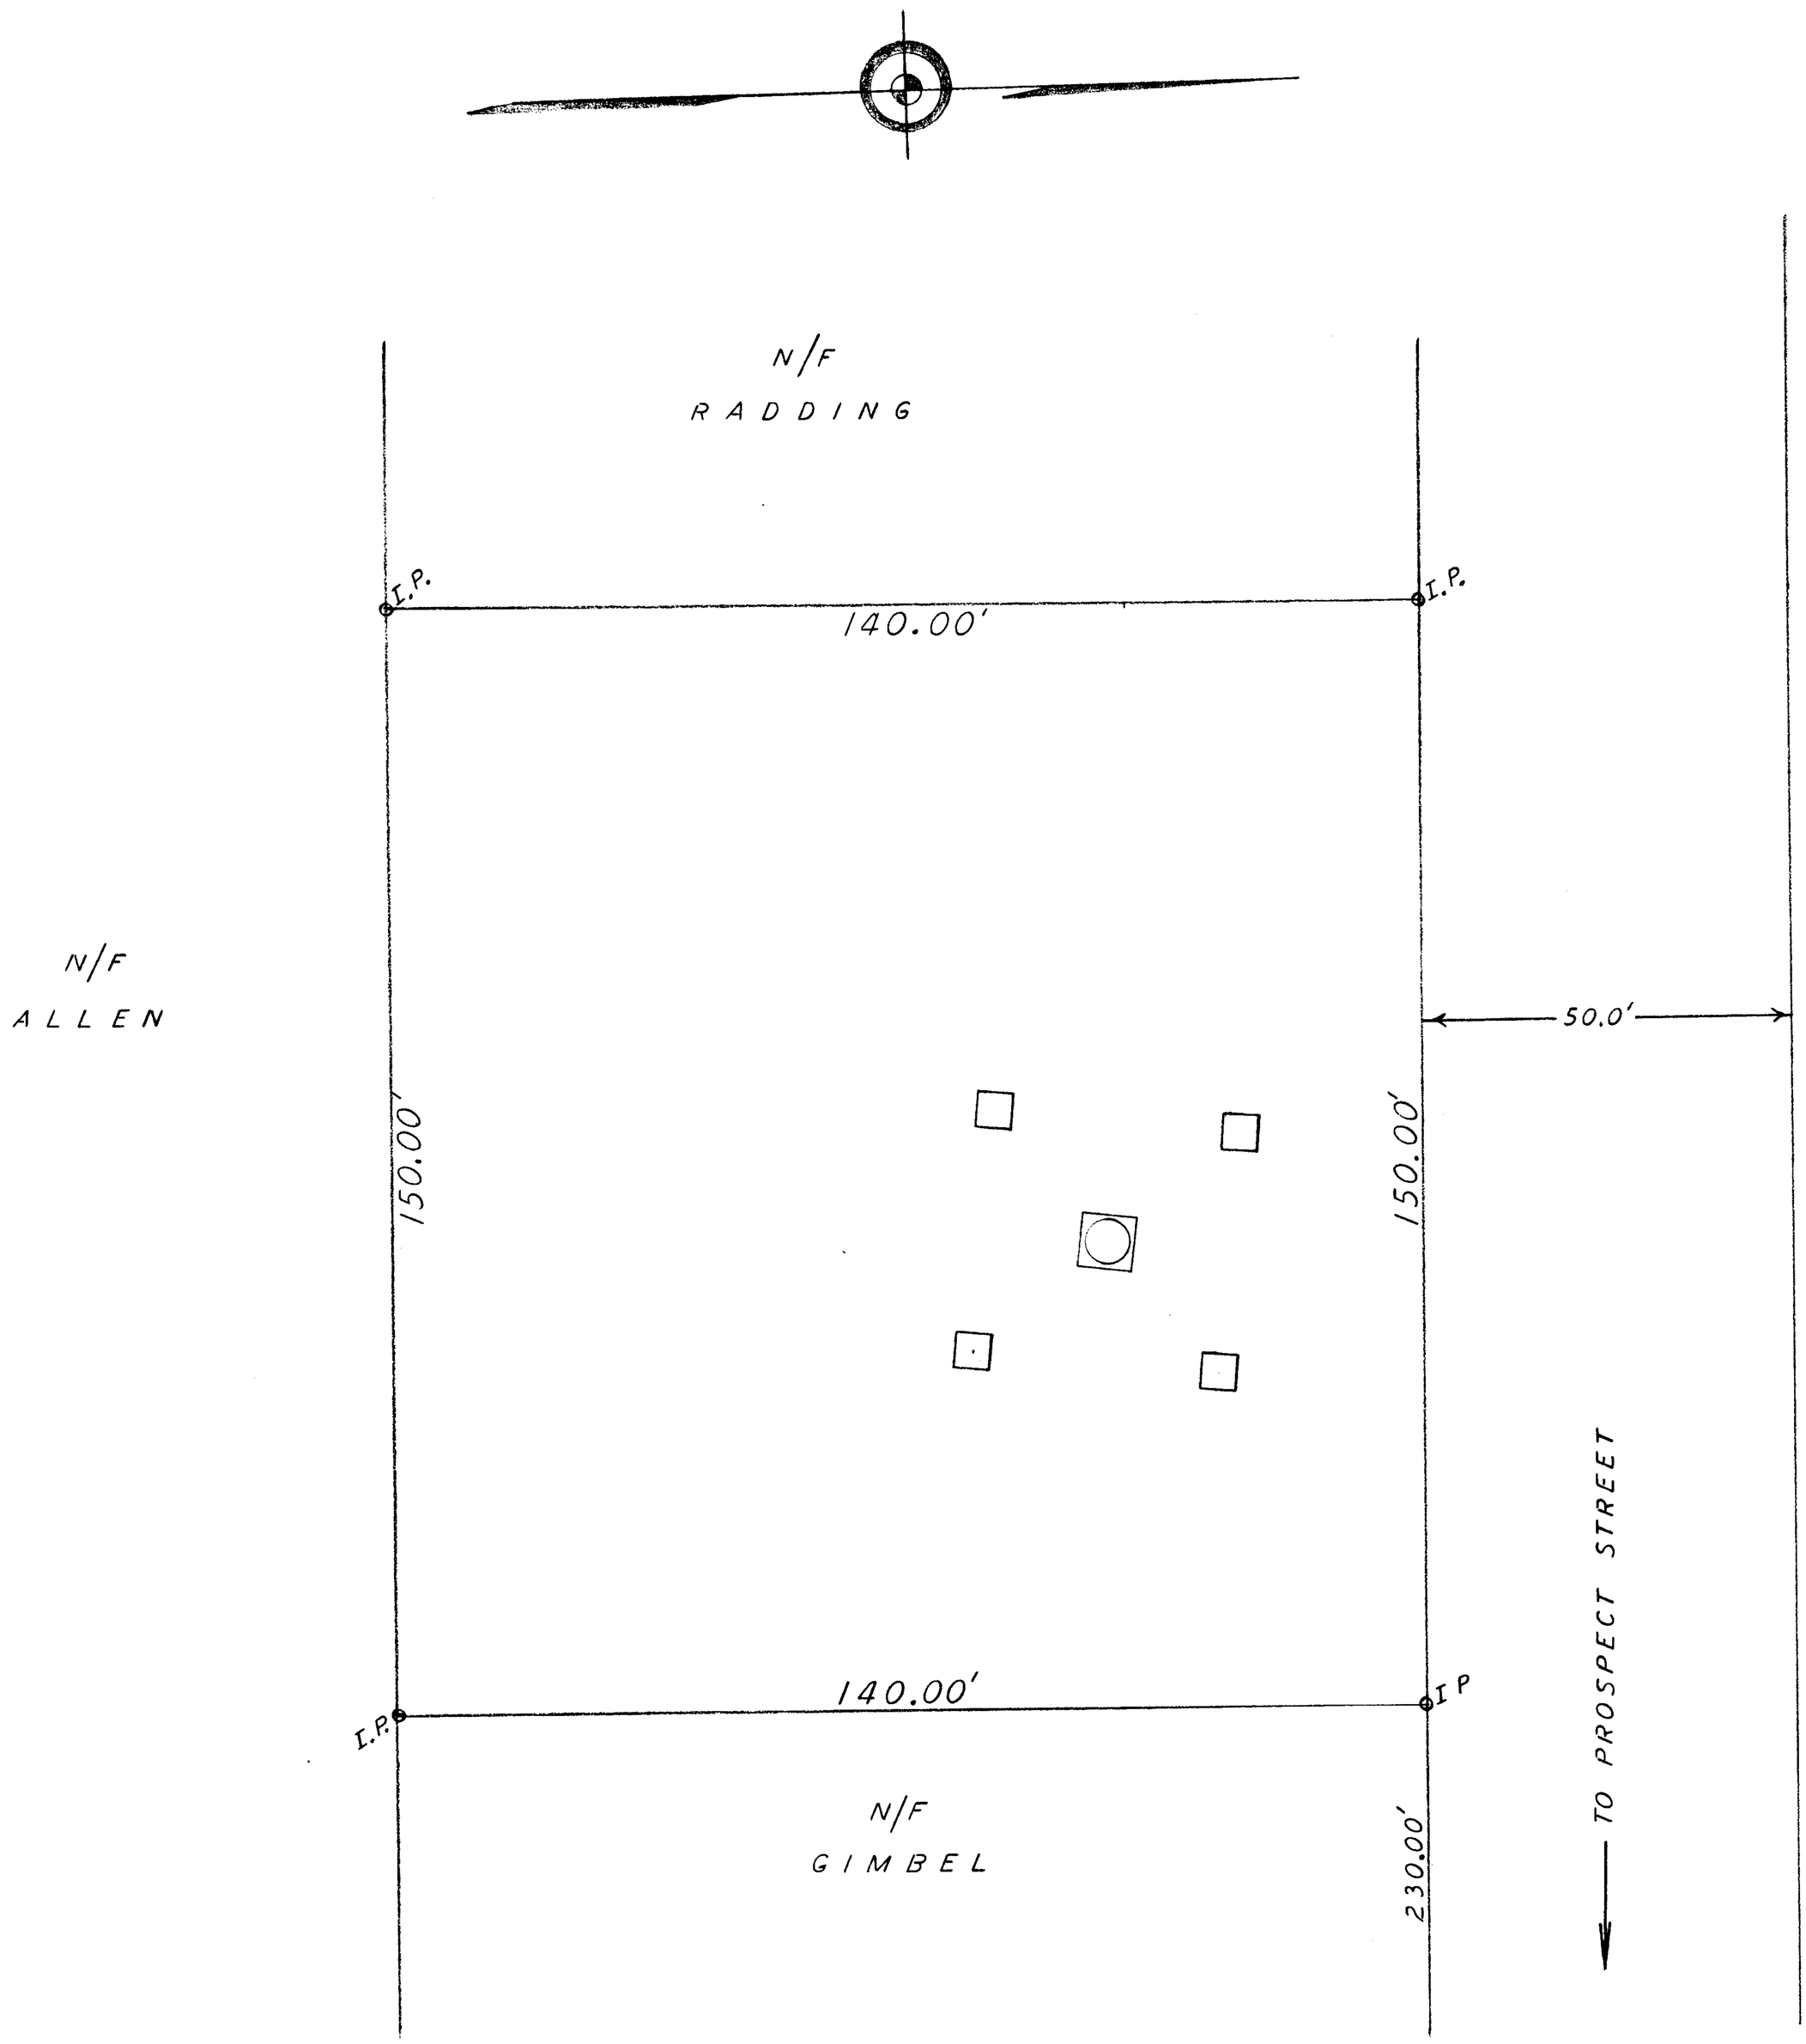

PLAN SHOWING LOCATION
OF
STAND PIPE

PROSPECT STREET EAST LONGMEADOW

DEPT. OF PUBLIC WORKS A. A. MELIEN, ENG.

SCALE: 1" = 20' NOV., 1964

F. 13 2