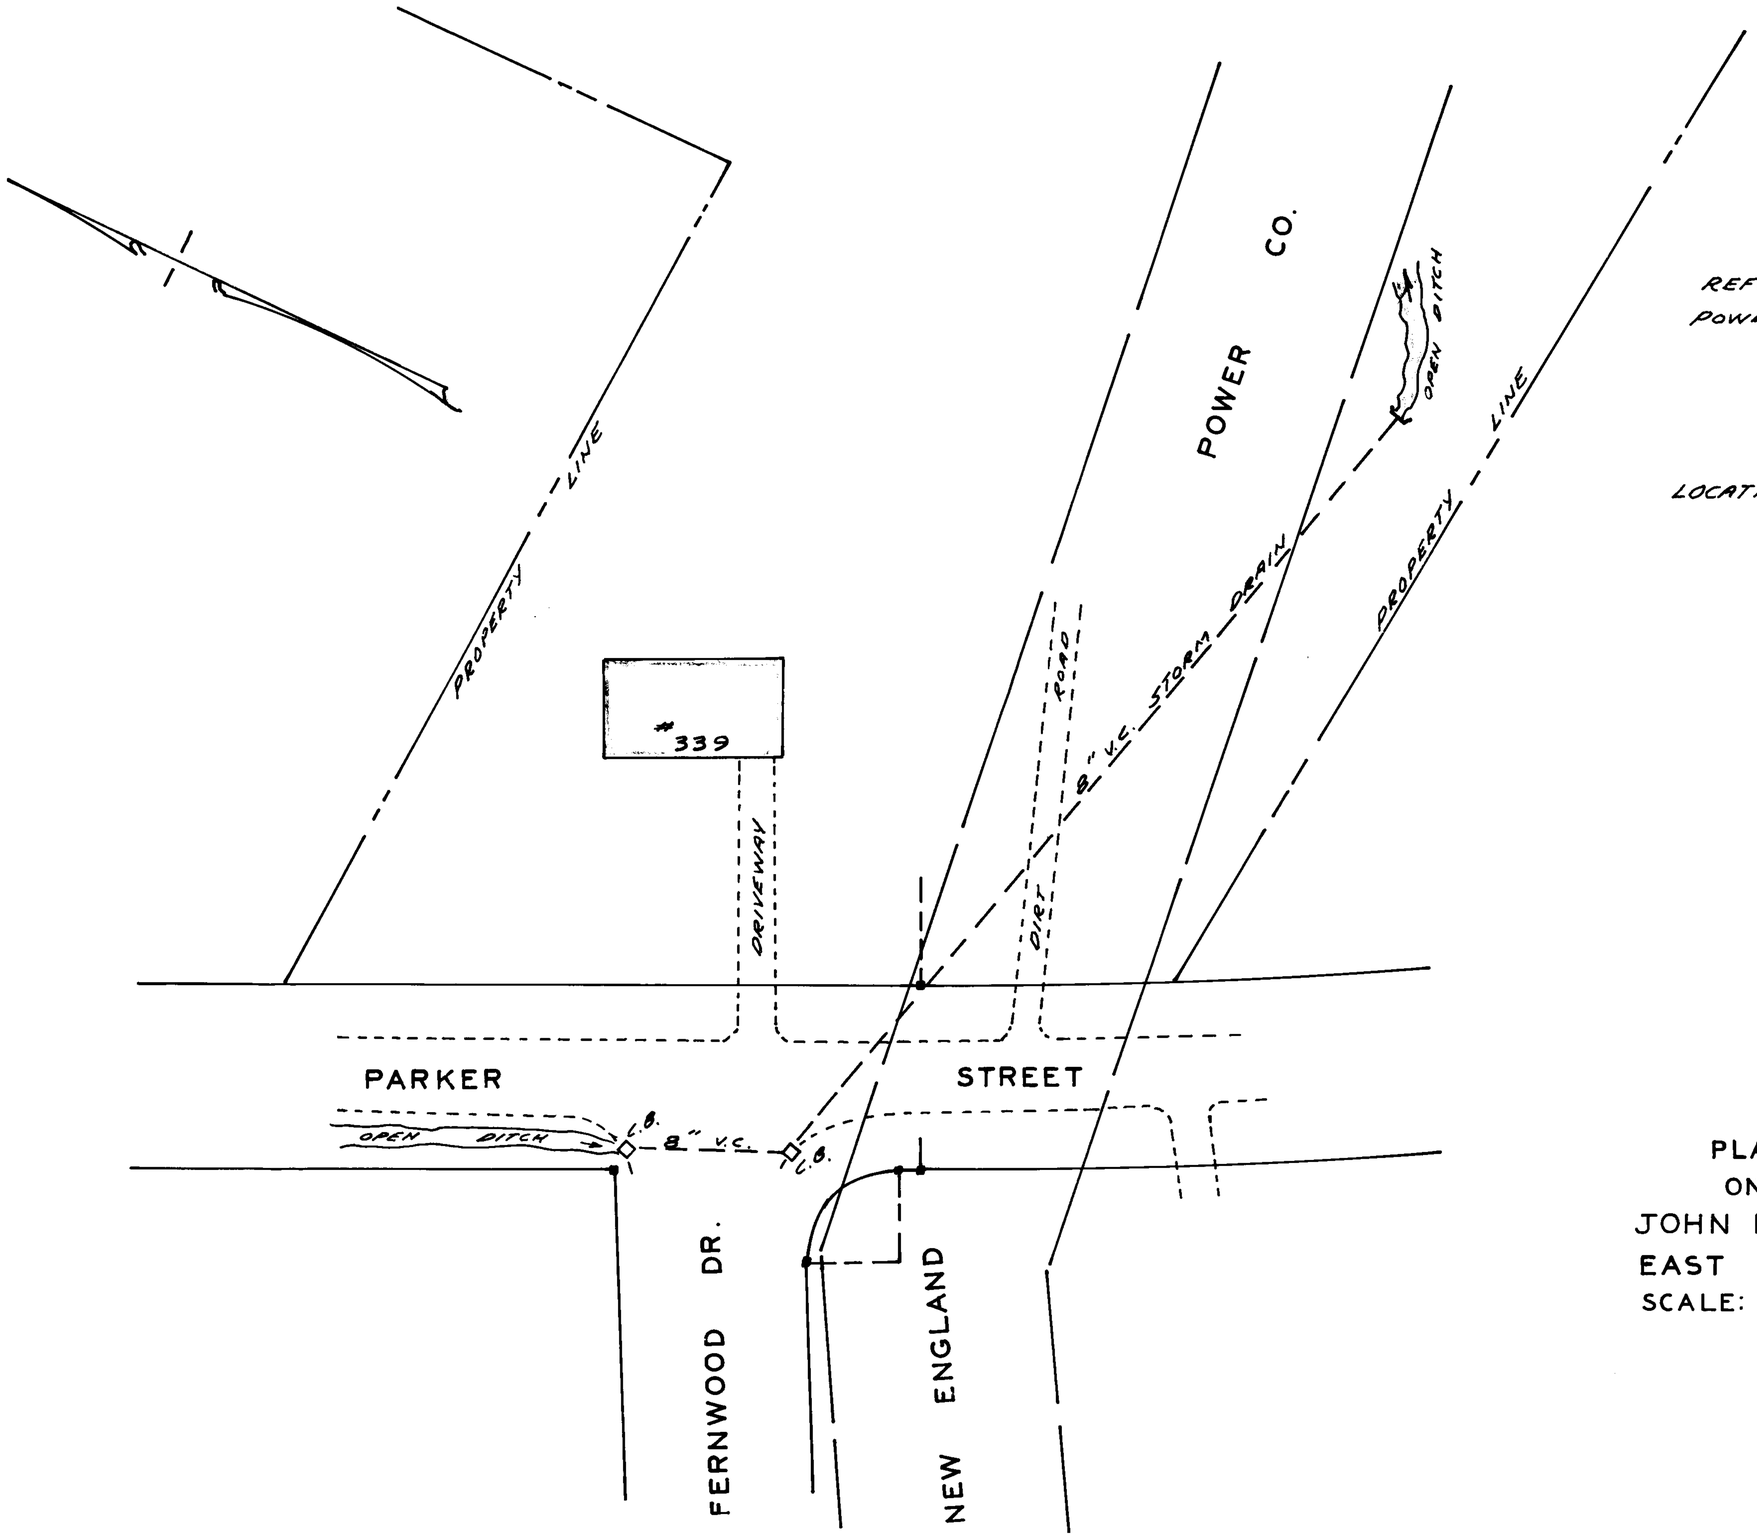

REFER TO DEED BK 2306 PG. 558 FROM POWERS ET ALS TO AGNOLI ETALS - 1954

LOCATION MADE BY D.P.W. - MAY 1977

PLAN SHOWING STORM DRAIN
ON LAND FORMERLY OF
JOHN F. & HELEN V. POWERS
EAST LONGMEADOW MASS.
SCALE: 1" = 40' JUNE 1977