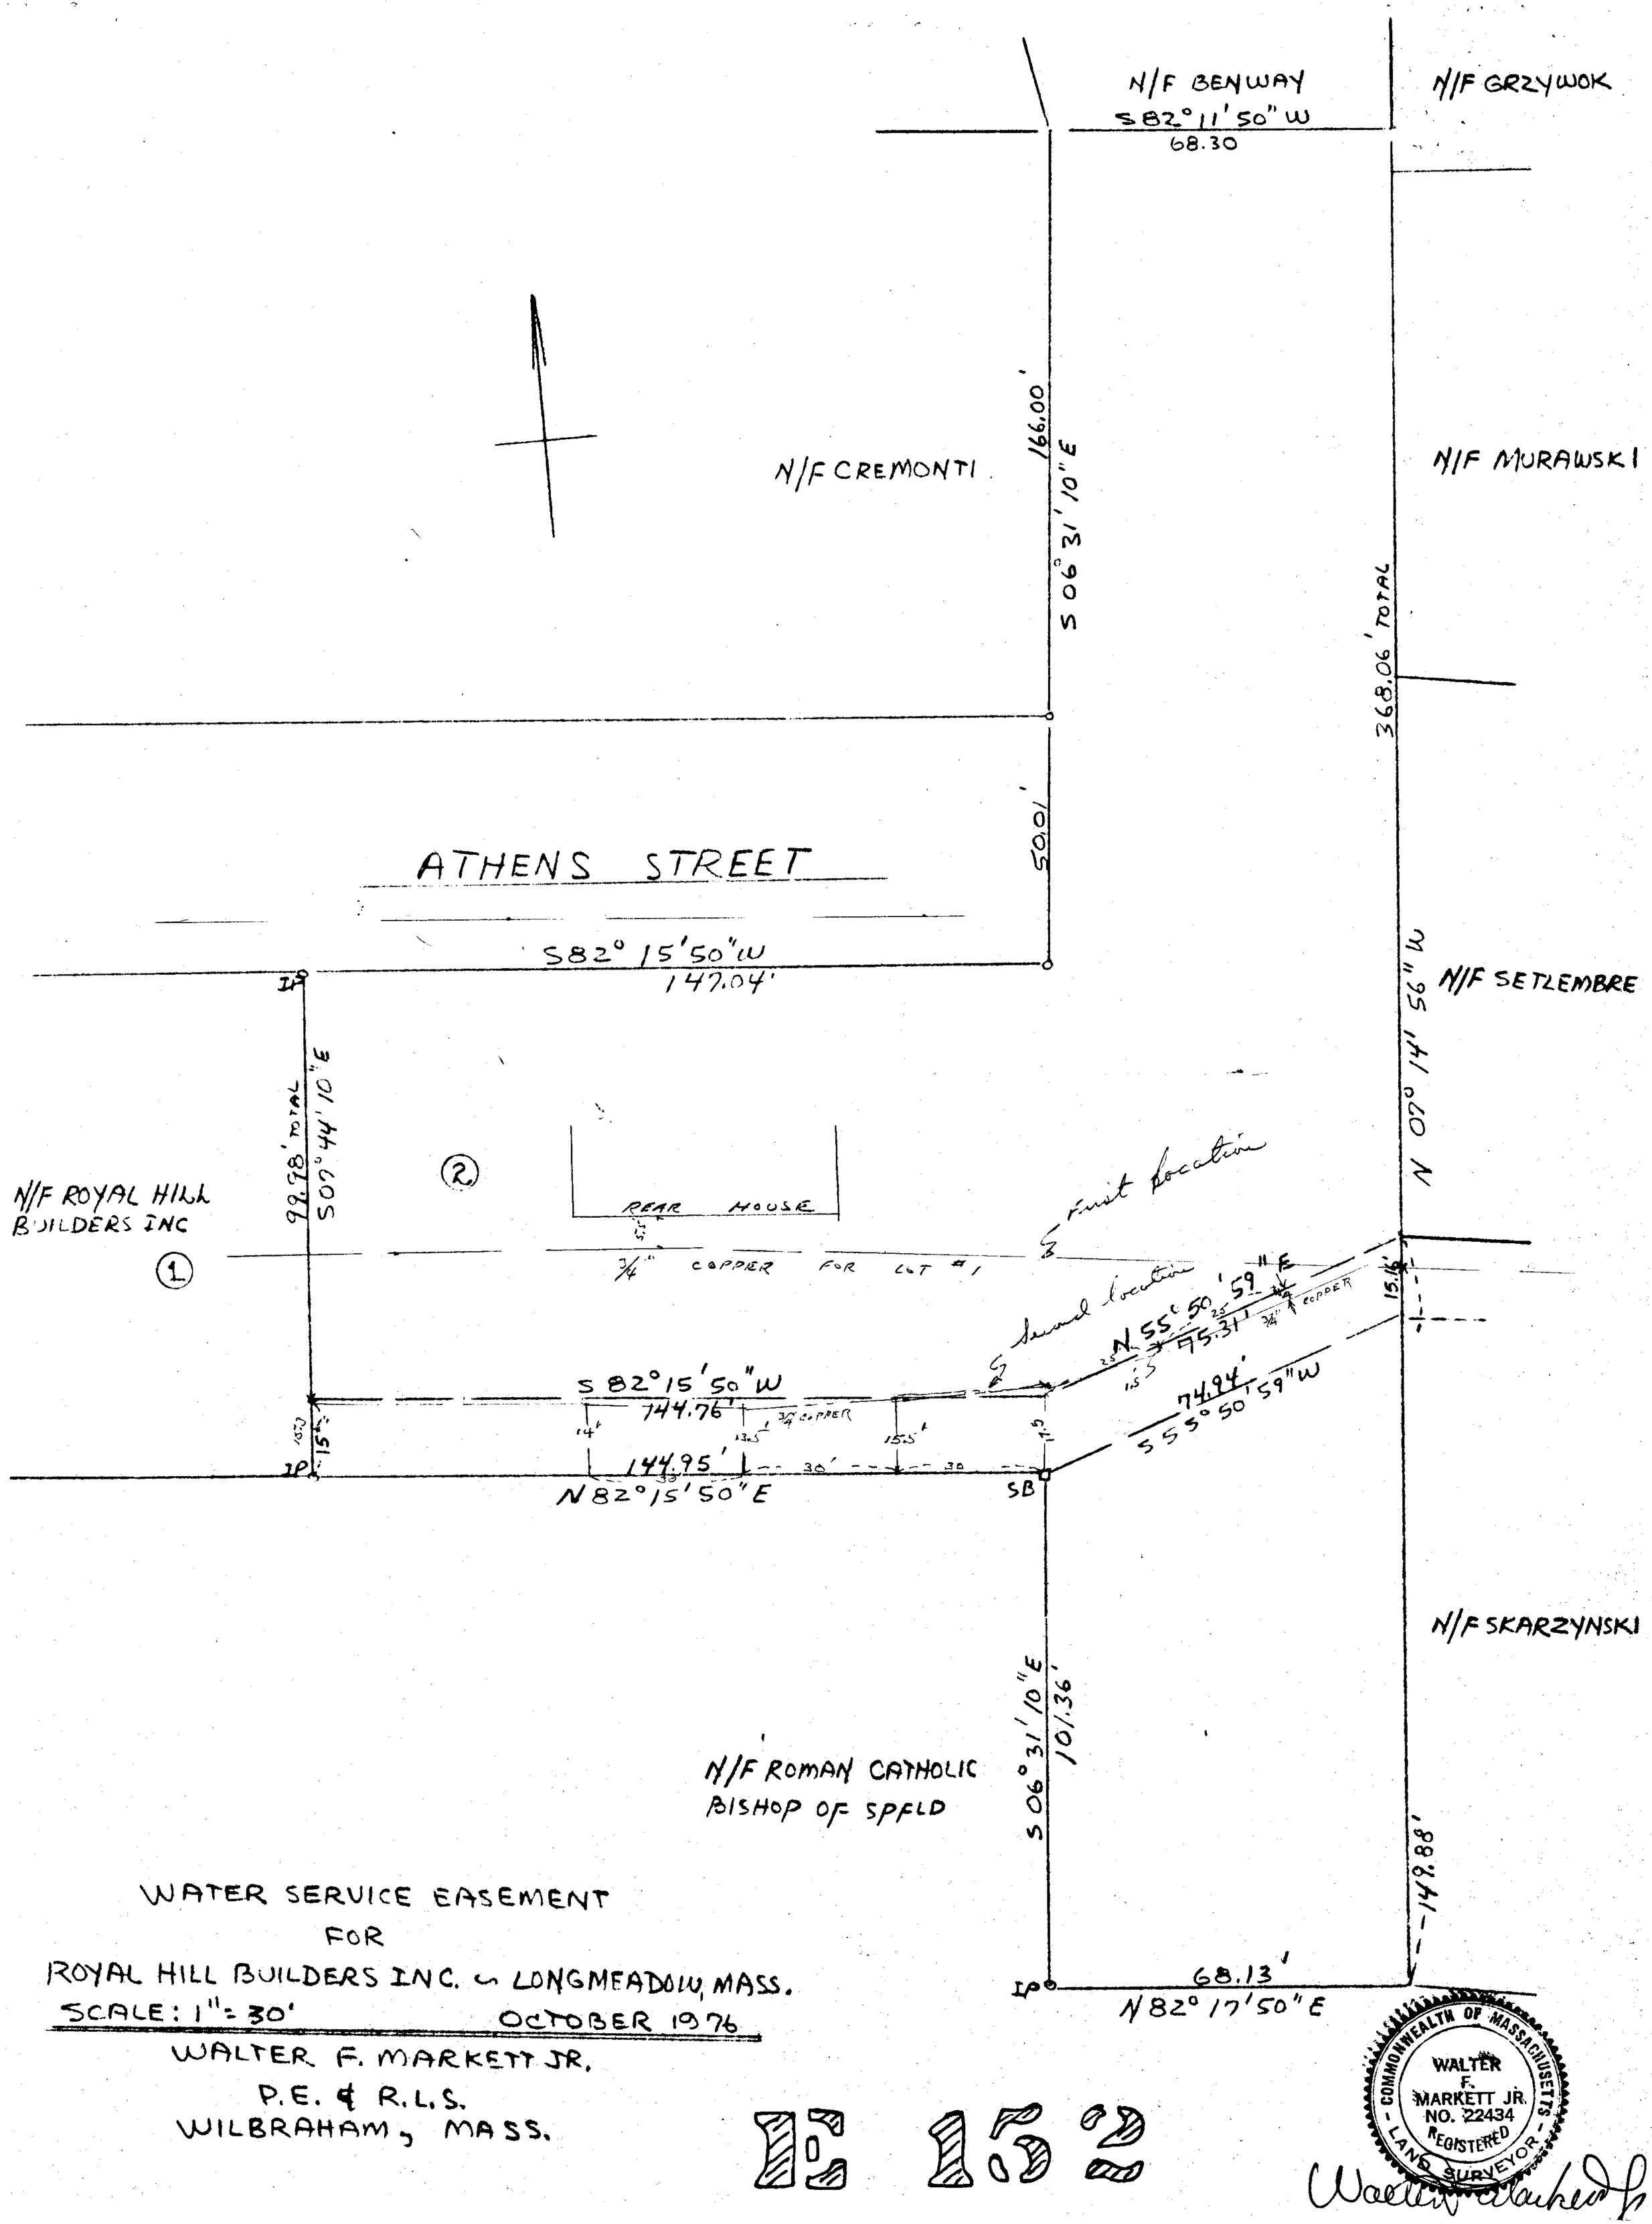

WATER SERVICE EASEMENT
FOR
ROYAL HILL BUILDERS INC. ~ LONGMEADOW, MASS.
SCALE: 1" = 30' OCTOBER 1976

WALTER F. MARKETT JR.
P.E. & R.L.S.
WILBRAHAM, MASS.

12 152

COMMONWEALTH OF MASSACHUSETTS
WALTER F. MARKETT JR.
NO. 22434
REGISTERED
LAND SURVEYOR

Walter F. Markett Jr.