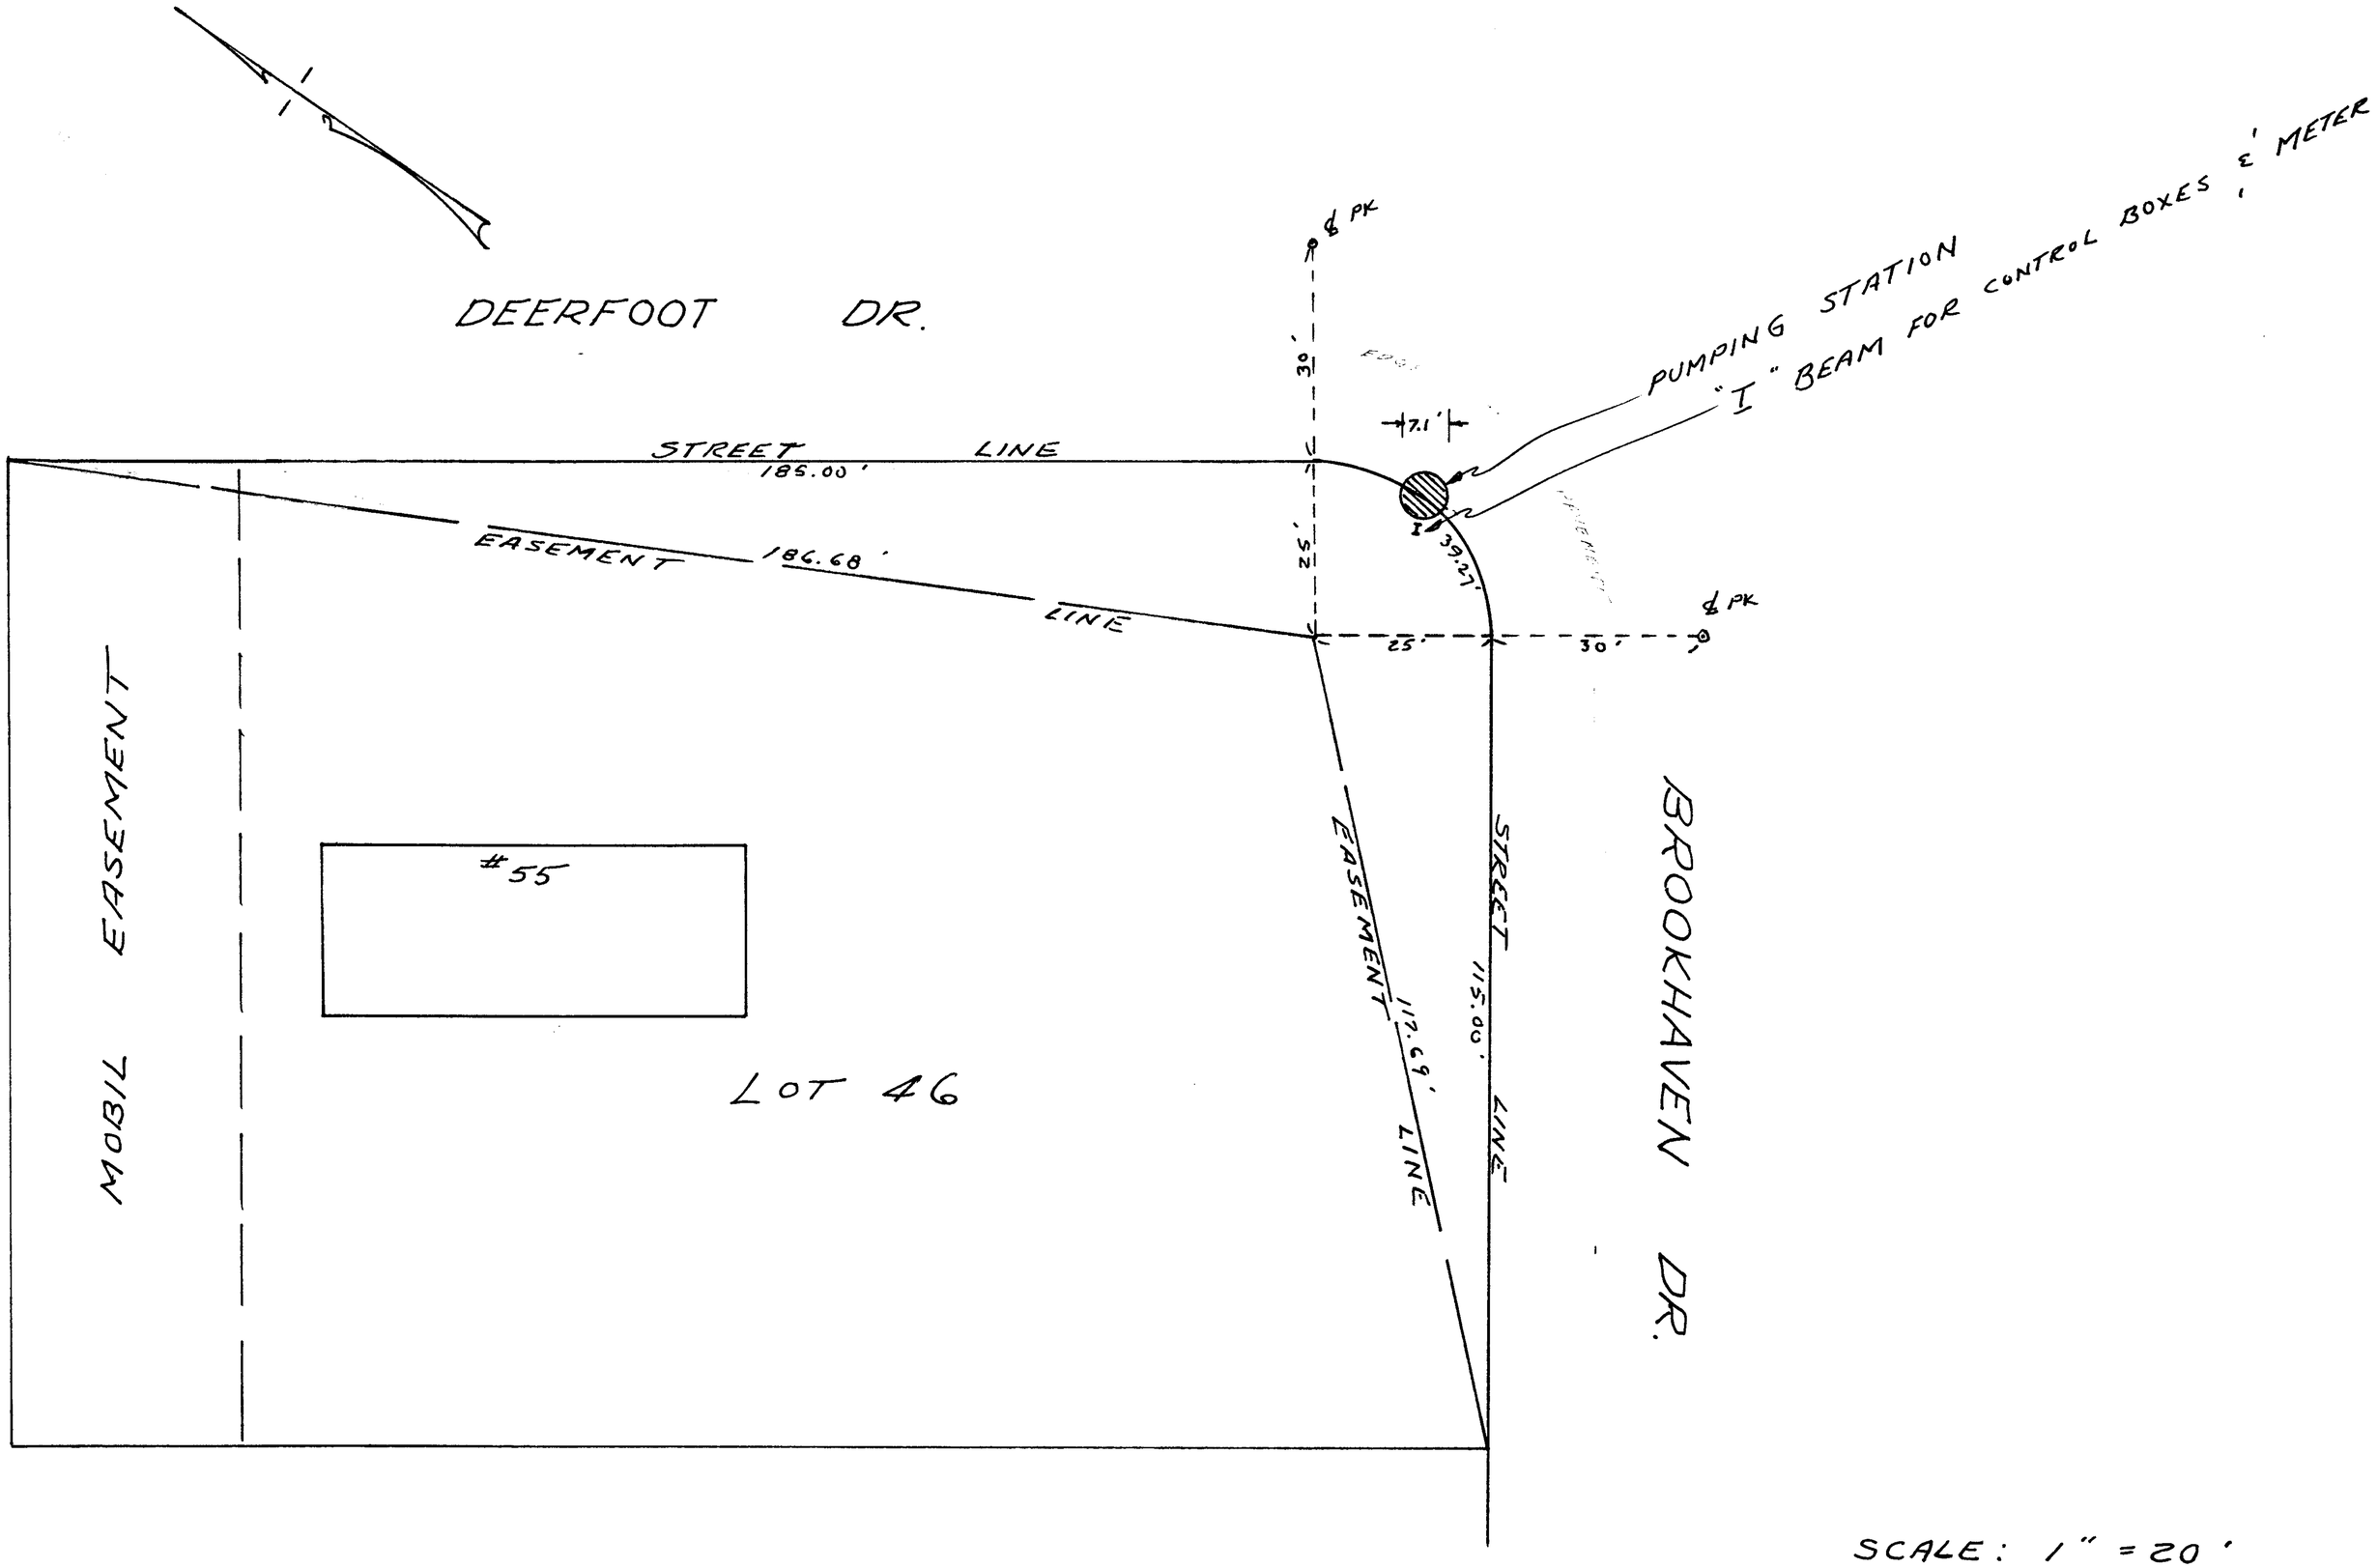

SCALE: 1" = 20'

E-1664A