


GARETSON & ELLIS

Archie T. Rintoul

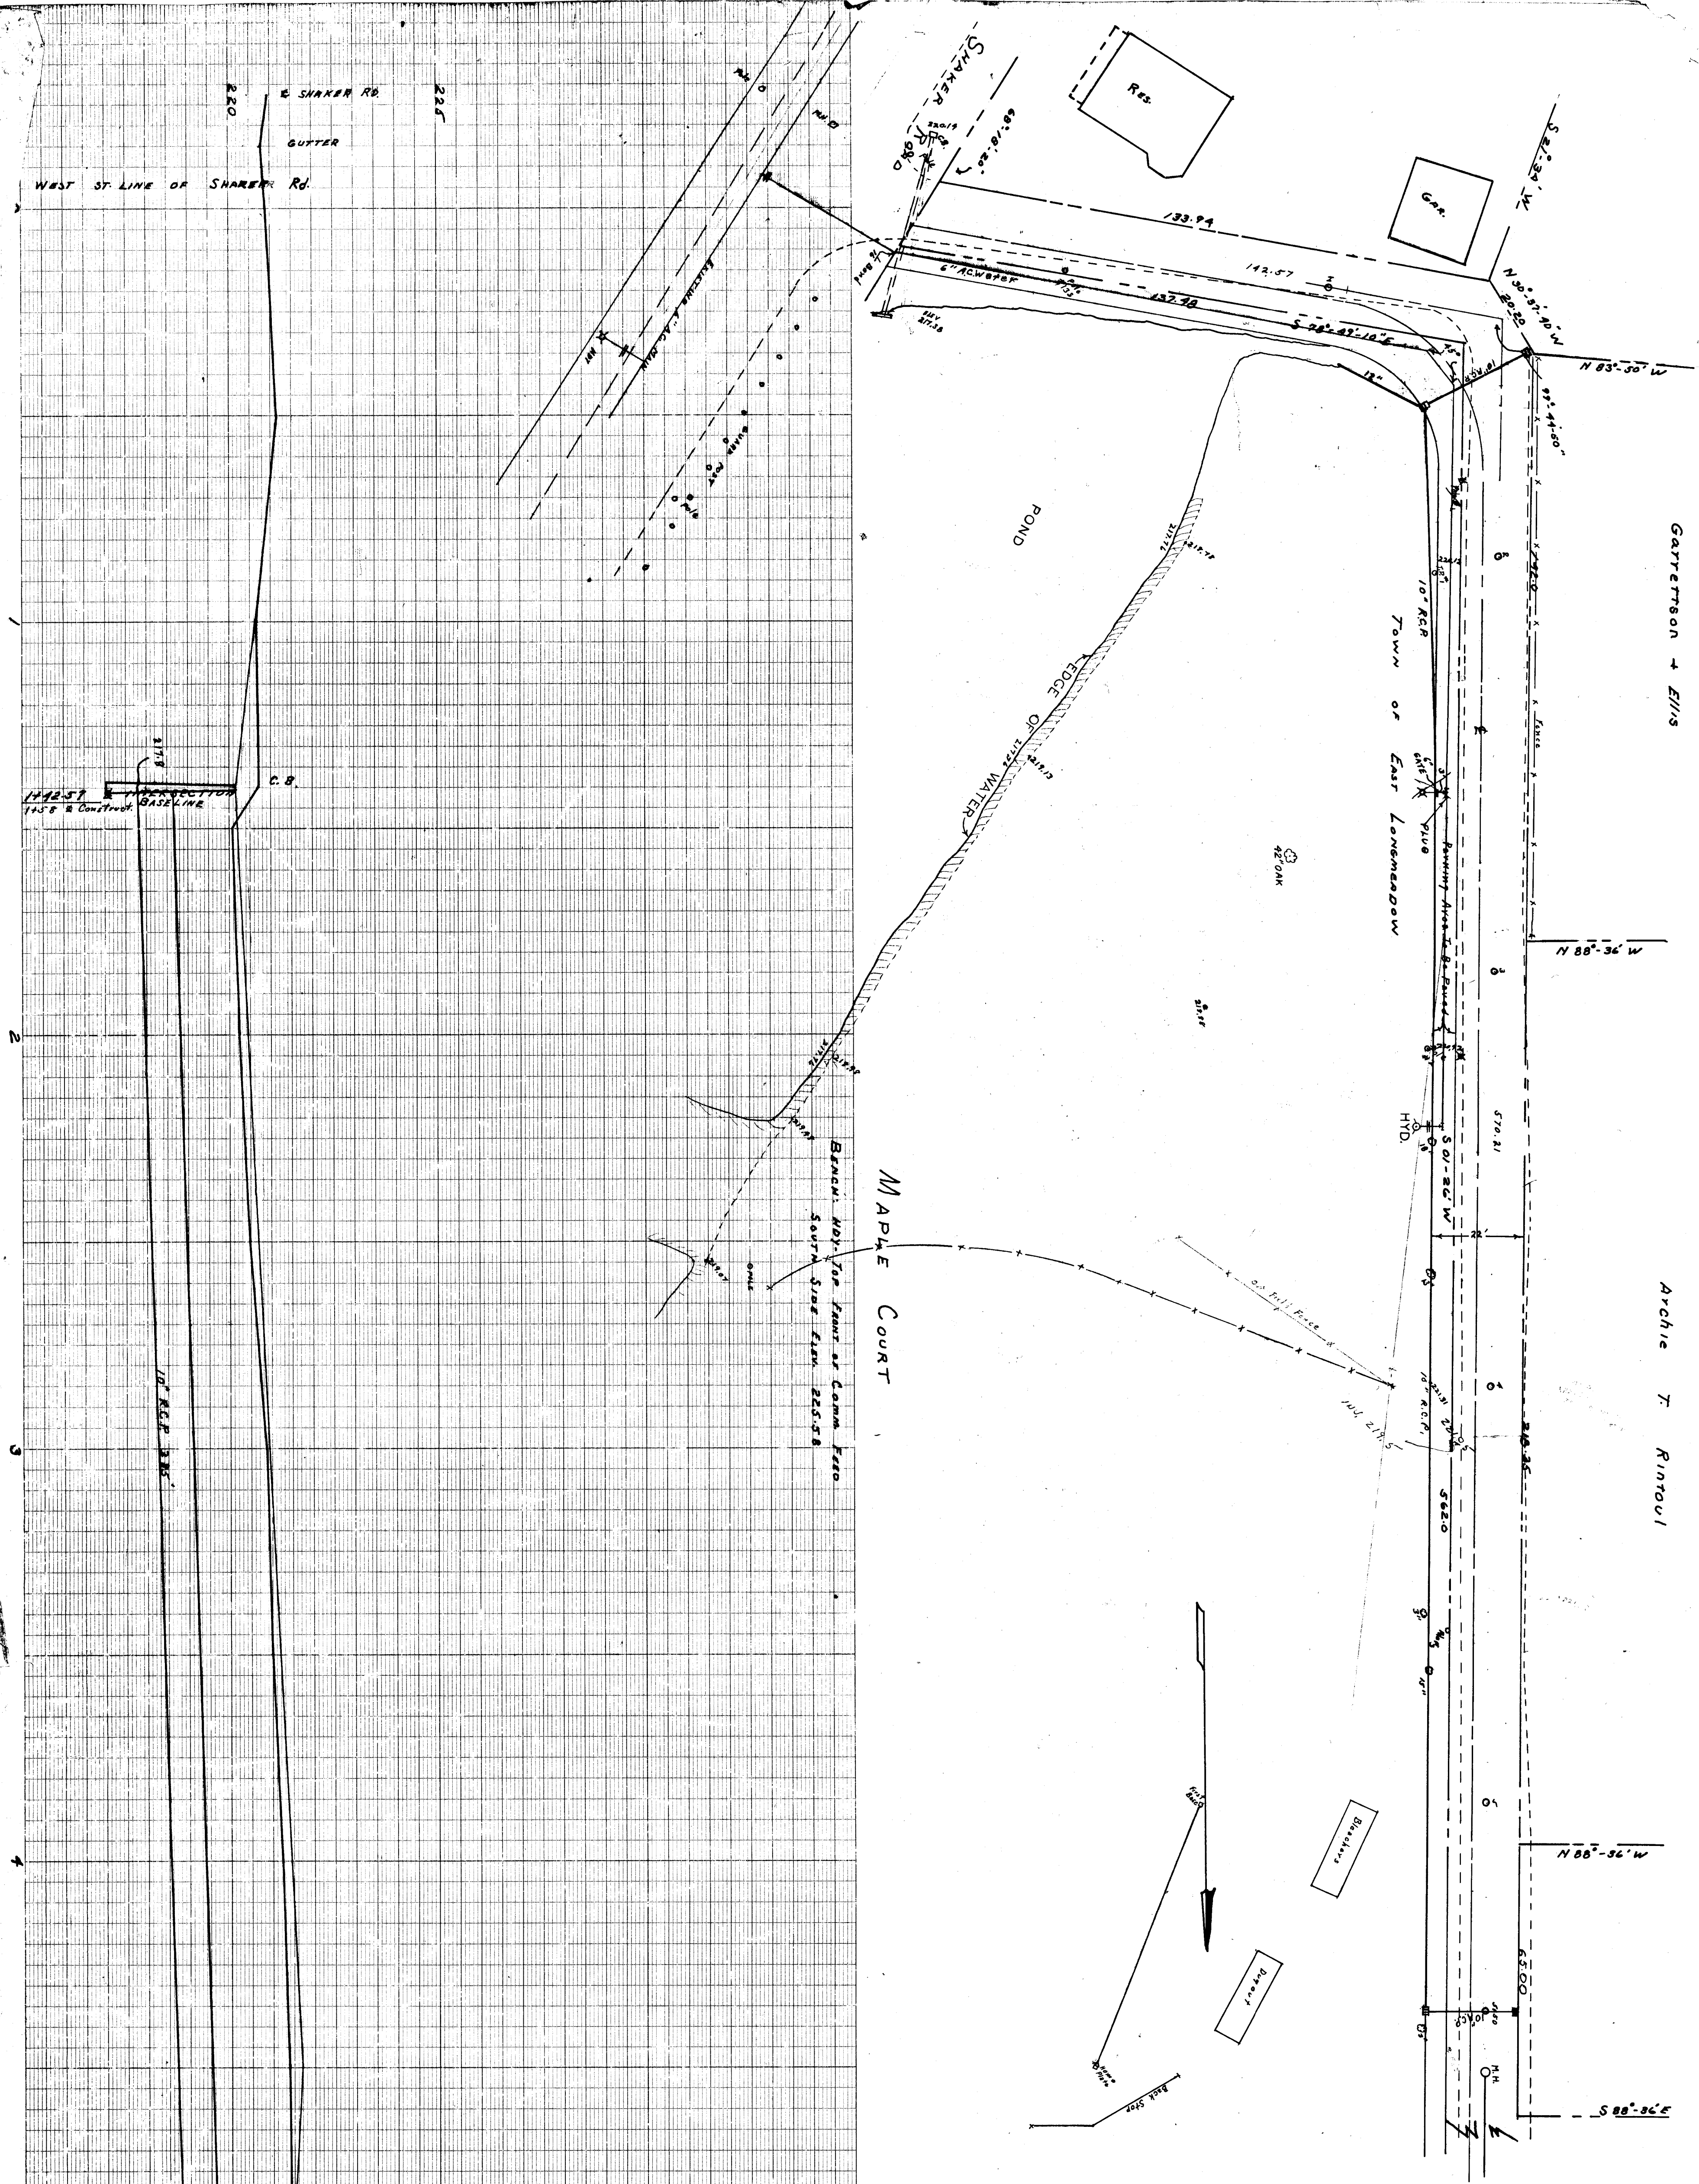

PLAN AND PROFILE
MAPLE COURT
DEPT OF PUBLIC WORKS
TOWN OF EAST LONG MEADOW
SCALE: 1/4\"/>