

ON CROWN MADE IN NEW
BRIMMED IN NEW





ENGINEER DELISEN CO
BY
J. DELISEN





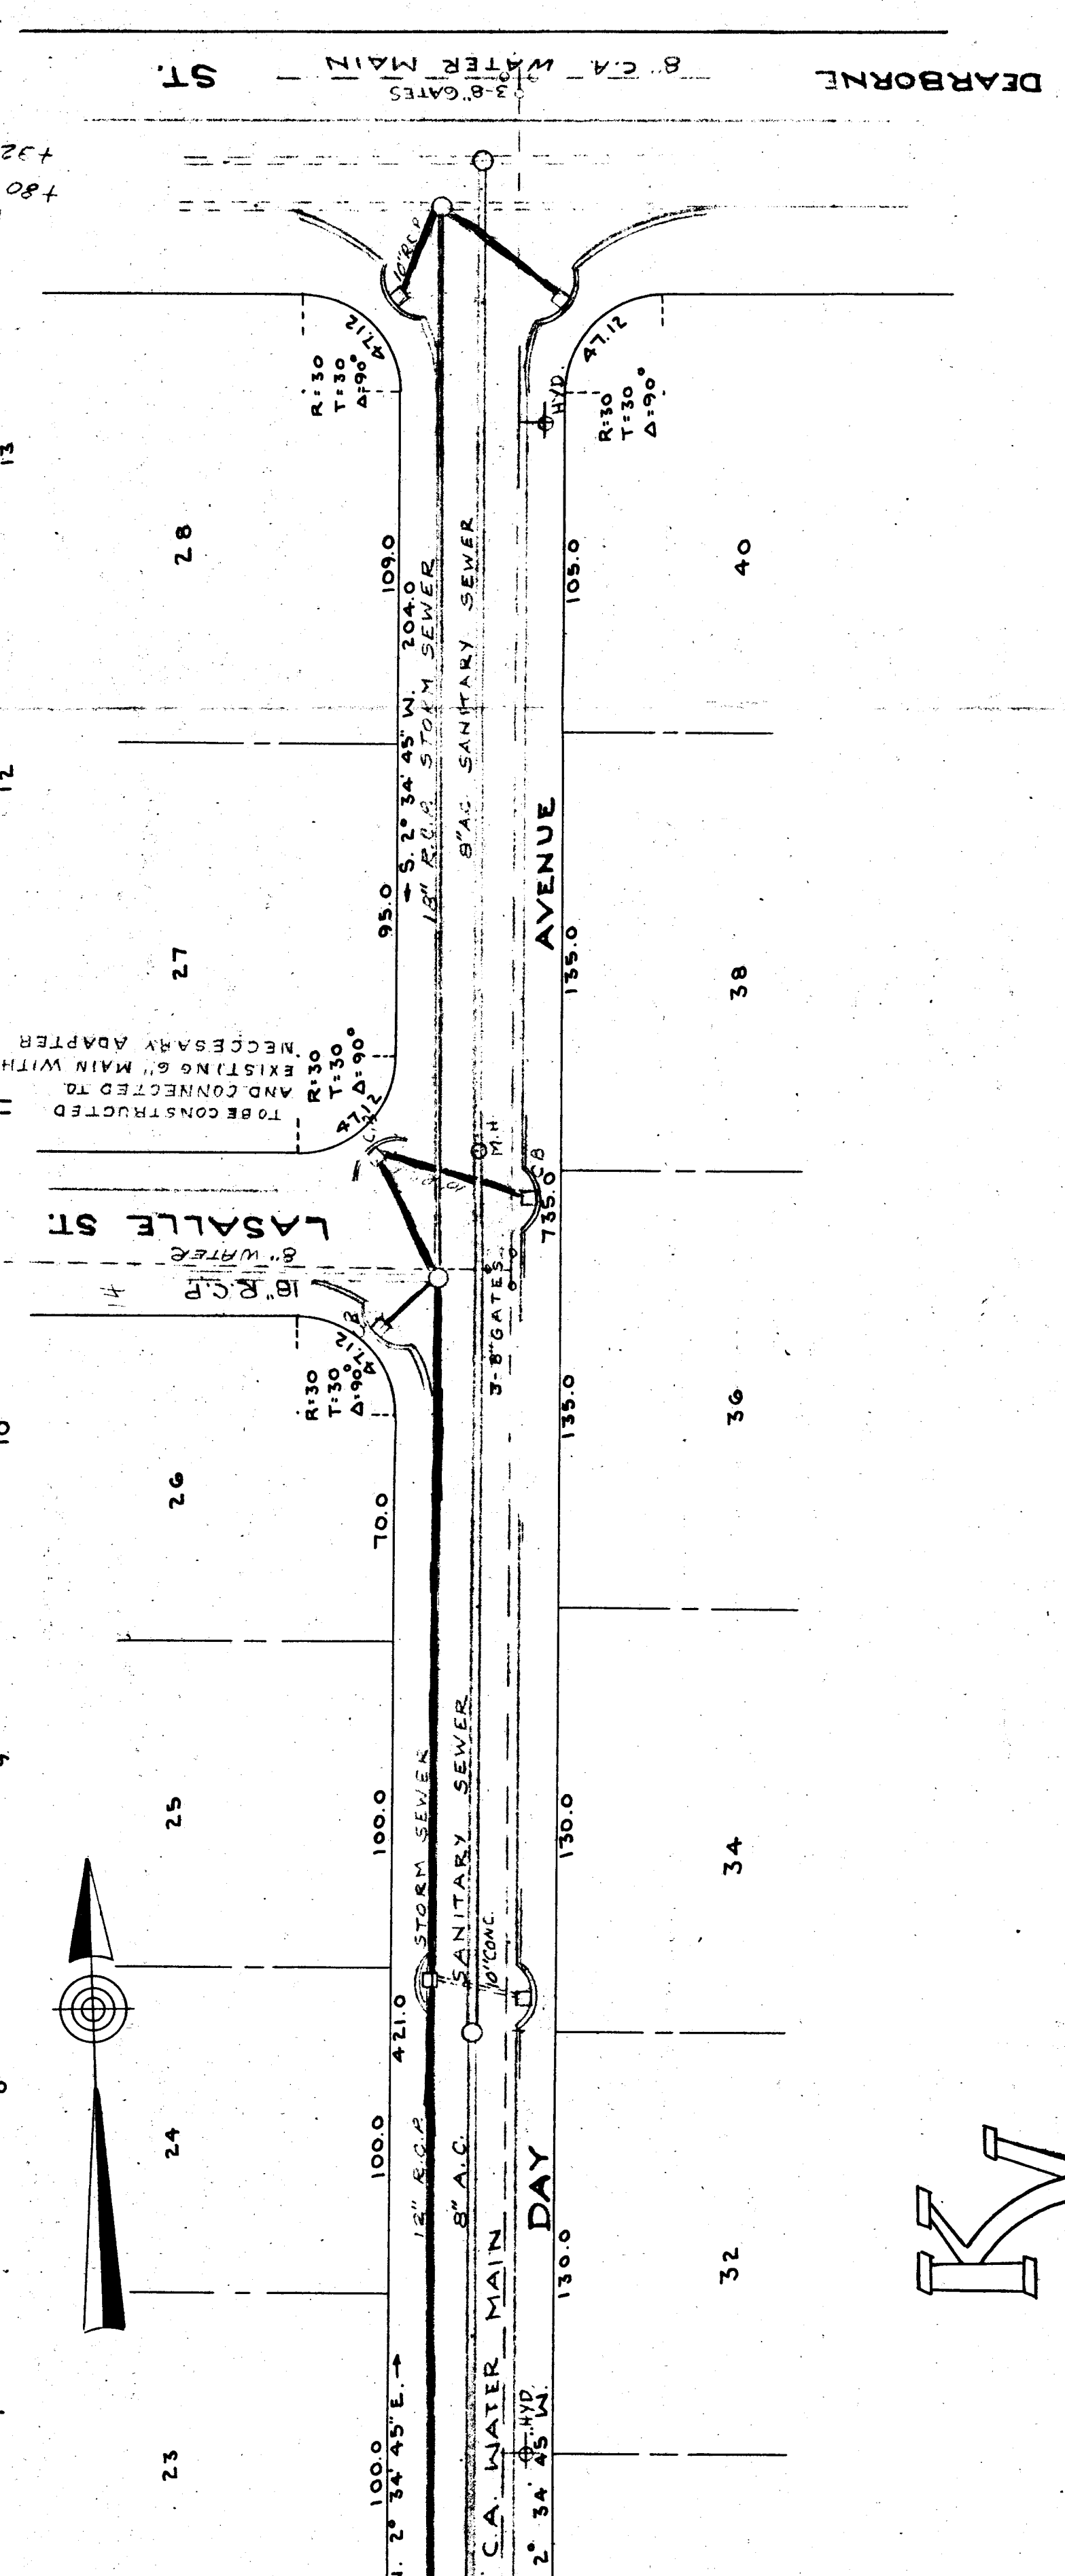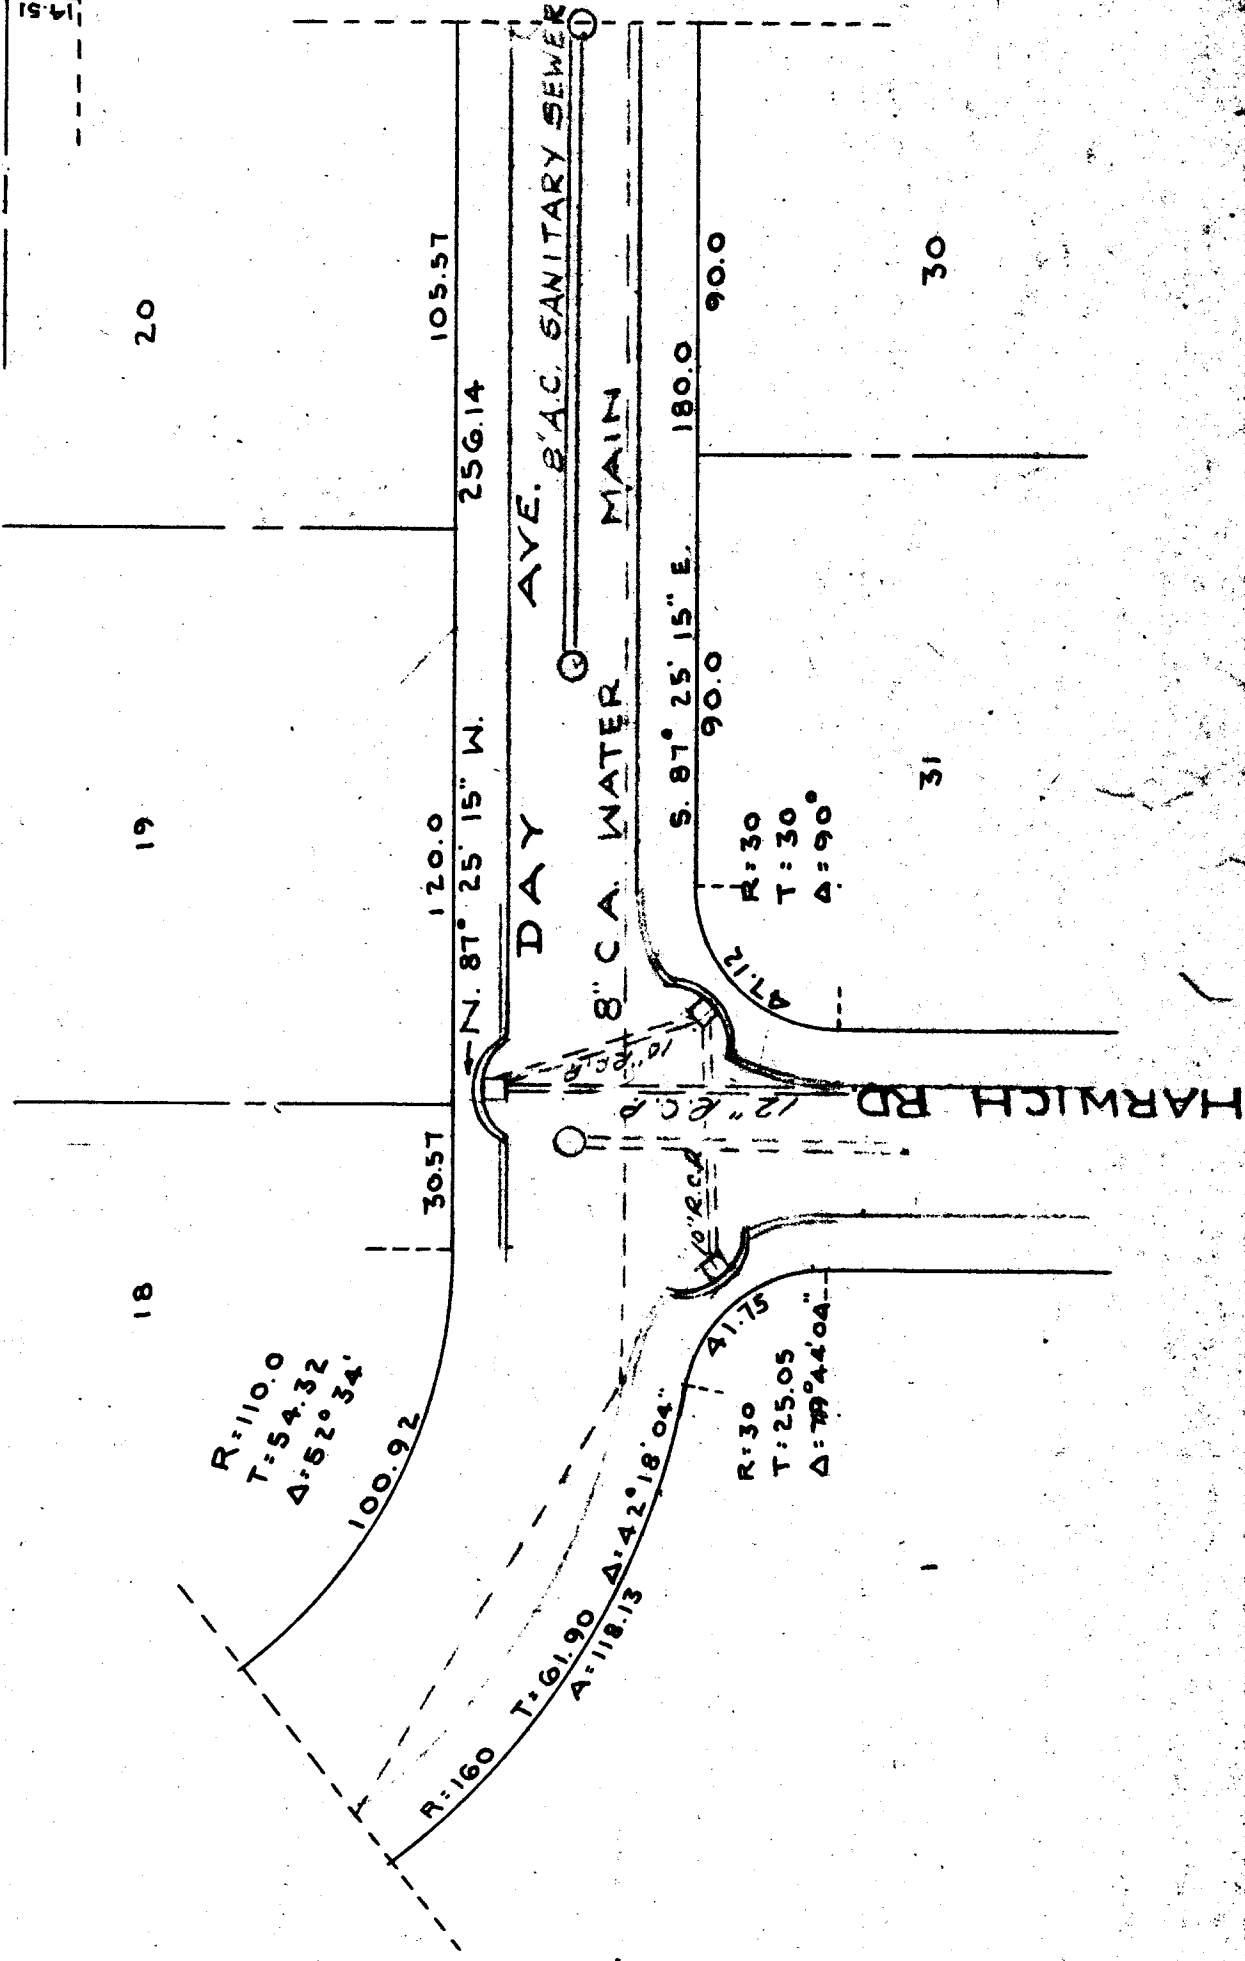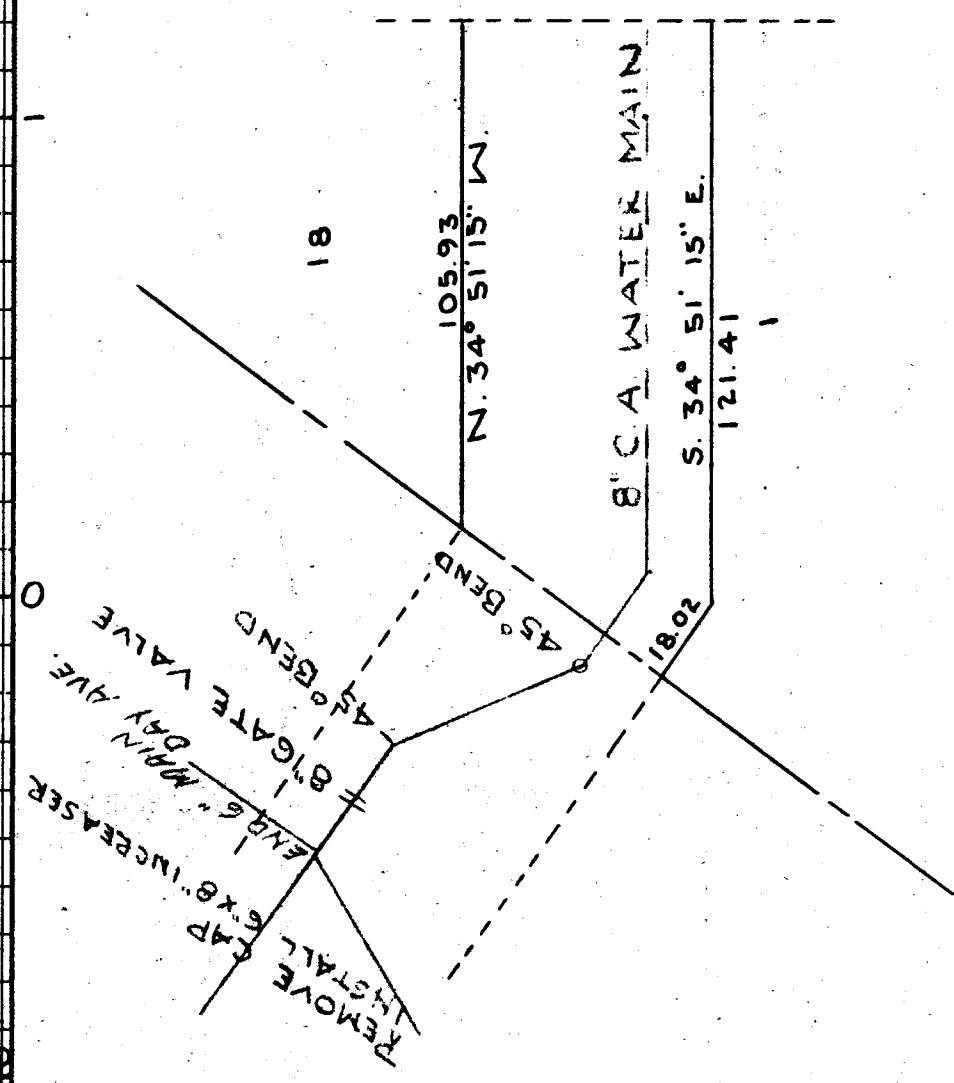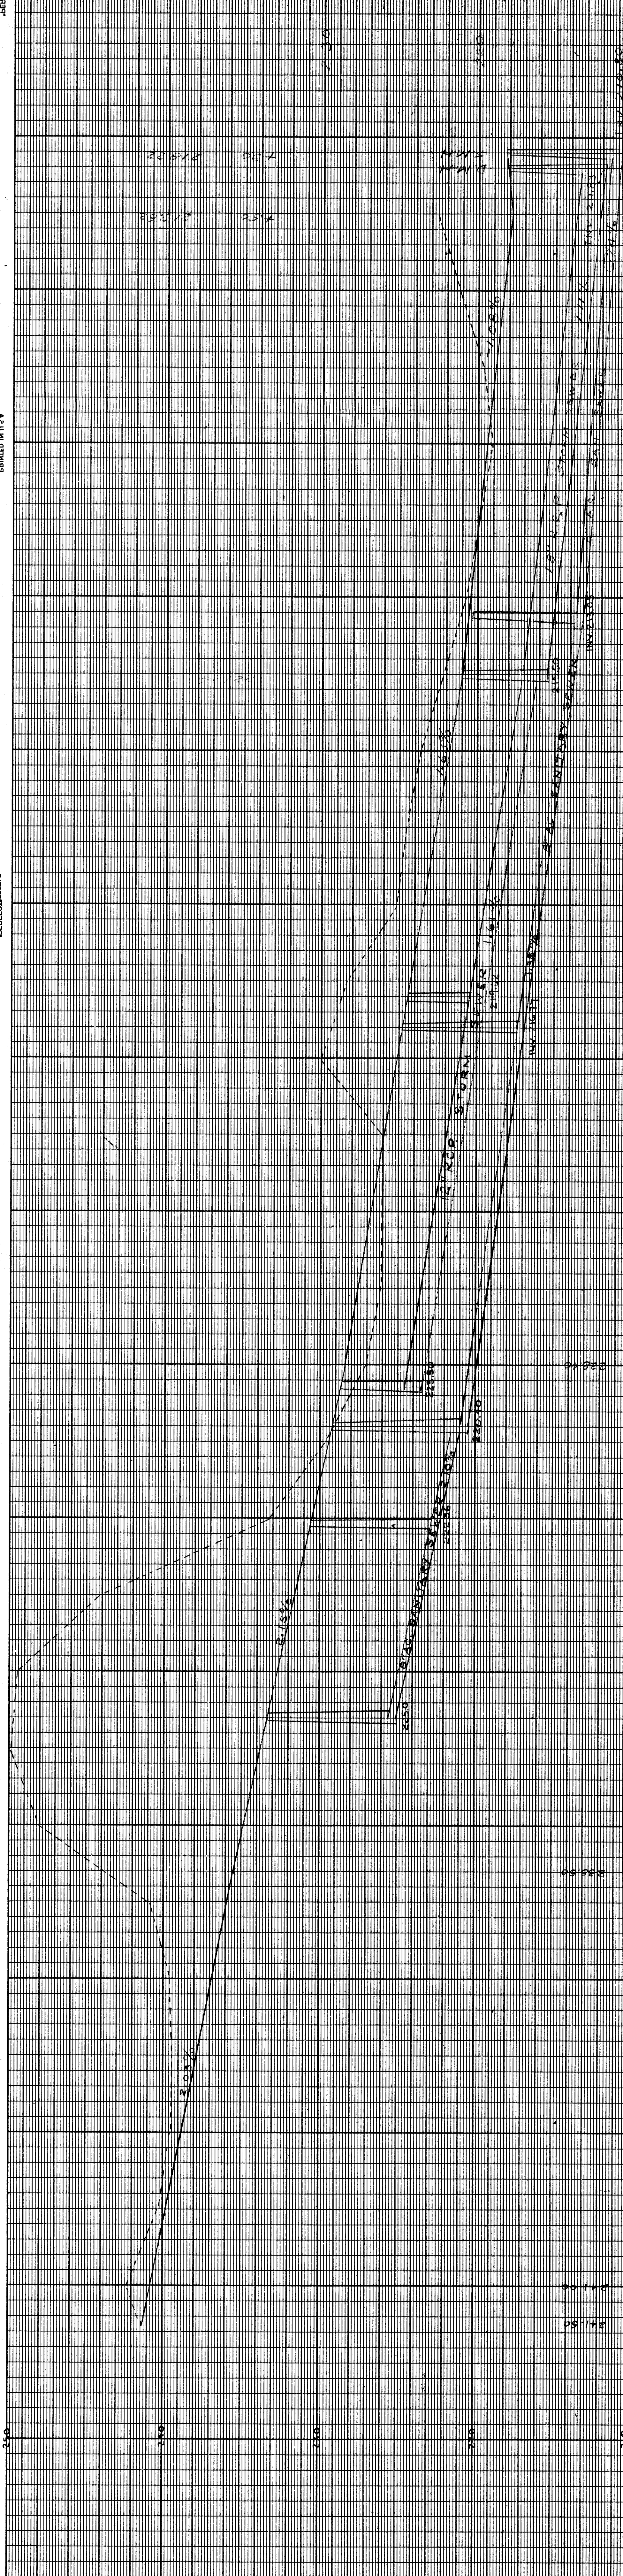

K

PLAN & PROFILE OF
DAY AVENUE
SANDSTONE MANOR
OWNED BY
KAY VEE REALTY COMPANY INC.
SCALE: 1"=40'
SMITH & WELLEN
602 WHITE STREET
REVISED: APRIL 3, 1958
ENGINEERING COMPANY INC.
SPRINGFIELD, MASS.
MARCH 1958

EAST LONGMEADOW PLANNING BOARD	APPLICATION FILED: 3-15-54
<i>William C. Delise</i>	FINAL PLAN FILED: 6-1-54
<i>John C. Delise</i>	HEARING DATE: 5-10-54
<i>John C. Delise</i>	PLAN APPROVED: 5-10-54
NOTES: REVISED: AUG. 1958	