




● Active Sewer Manhole	● Bend fitting	— Abandoned Gravity Sewage Main	● Capped End	■ Detention Basin	● Cross Fitting	● Other Service Valve	● Water Meter Pit	— Abandoned Water Lateral
● Abandoned Sewer Manhole	— Tee Wye; Tee fitting; Wye fitting	— Abandoned Forced Sewage Main	▲ Flared End Structure	■ Drain Easement	■ Plug Fitting	● Gate Valve	● Water Pumping Station	— Proposed Water Lateral
— Sewer Connection	● Cap fitting	— Concrete Encasement	■ Headwall; Endwall	● Hydrant	▲ Insealer; Reducer	● Butterfly Valve	● Fire Pump	— Water Lateral
■ Other Features	● Clean-out fitting	— Steel Sleeve	■ Rip-rap	■ Other Water Fitting	▲ Tap Fitting	● Blow Off Valve	● Sample Station	■ Water Easement
■ Wet Well	■ Chimney fitting	— DI Sleeve	● Drain Manholes	■ Bend Fitting	● Tee Fitting	● Other Water Feature	● Water tank	— Easement Boundaries
■ Pump Station	● Reducer	■ Catch Basin	● Outfalls	● Coupling	● Other Water Valve	■ Thrust Protection	■ Water Main	● Break Out Tanks
● Other Fittings	— Sewer Lateral	■ Undigitized Catch Basin	— Drain Line	● Other Water Valve	● Gate Valve	— Abandoned / Inactive Water Main	— Proposed Water Main	● LNG's
	— Gravity Sewage Main	▲ Other Drain Features	— Open Channel	● Butterfly Valve	● Blow Off Valve			— Pipelines
	— Forced Sewage Main		— Culvert					

The Town of East Longmeadow and its mapping contractors assume no legal responsibility for the information contained herein.

These data are not suitable for engineering applications or site work nor can the data be used to determine absolute delineation. Instead, the data should be used to portray zones of uncertainty and possible risks.

Map created by East Longmeadow Utilities Application
Orthophotography Copyright Google c/o MassGIS.

1 inch = 47 feet
3/2/2022

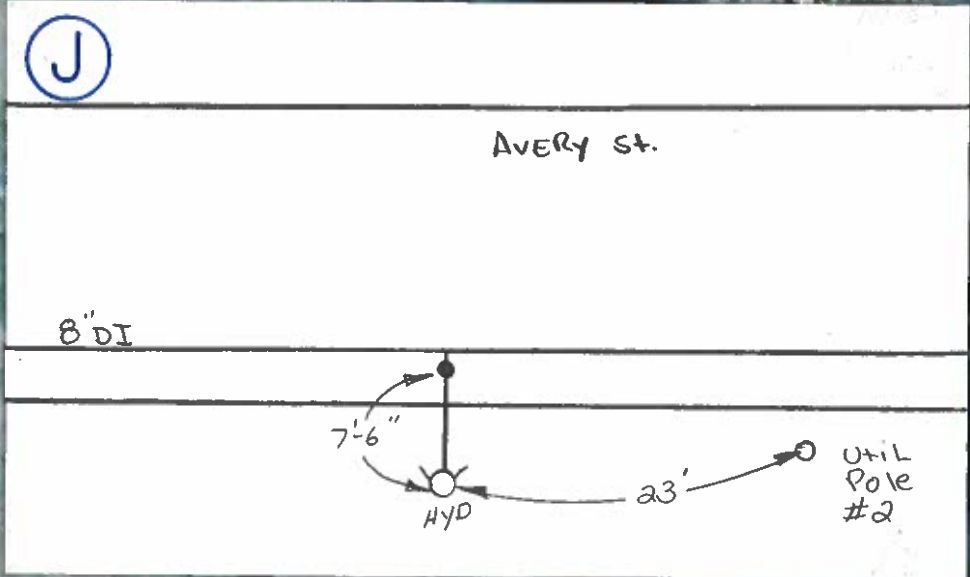

● Active Sewer Manhole	● Bend fitting	— Abandoned Gravity Sewage Main	● Capped End	■ Detention Basin	● Cross Fitting	● Other Service Valve	● Water Meter Pit
● Abandoned Sewer Manhole	— Tee Wye; Tee fitting; Wye fitting	— Abandoned Forced Sewage Main	▲ Flared End Structure	■ Drain Easement	● Plug Fitting	● Gate Valve	● Water Pumping Station
— Sewer Connection	● Cap fitting	— Concrete Encasement	■ Headwall; Endwall	● Hydrant	● Insealer; Reducer	● Butterfly Valve	● Fire Pump
■ Other Features	● Clean-out fitting	— Steel Sleeve	■ Rip-rap	■ Other Water Fitting	● Tap Fitting	● Blow Off Valve	● Sample Station
■ Wet Well	■ Chimney fitting	— DI Sleeve	● Drain Manholes	● Bend Fitting	● Tee Fitting	● Other Water Feature	● Water tank
■ Pump Station	● Reducer	■ Catch Basin	● Outfalls	● Cap Fitting	● Coupling	■ Thrust Protection	● Water Main
● Other Fittings	— Sewer Lateral	■ Undigitized Catch Basin	— Drain Line		● Other Water Valve		— Abandoned / Inactive Water Main
	— Gravity Sewage Main	▲ Other Drain Features	— Open Channel		● Gate Valve		— Proposed Water Main
	— Forced Sewage Main		— Culvert		● Butterfly Valve		
					● Blow Off Valve		



The Town of East Longmeadow and its mapping contractors assume no legal responsibility for the information contained herein.

These data are not suitable for engineering applications or site work nor can the data be used to determine absolute delineation. Instead, the data should be used to portray zones of uncertainty and possible risks.

Map created by East Longmeadow Utilities Application
Orthophotography Copyright Google c/o MassGIS.



1 inch = 47 feet
3/2/2022

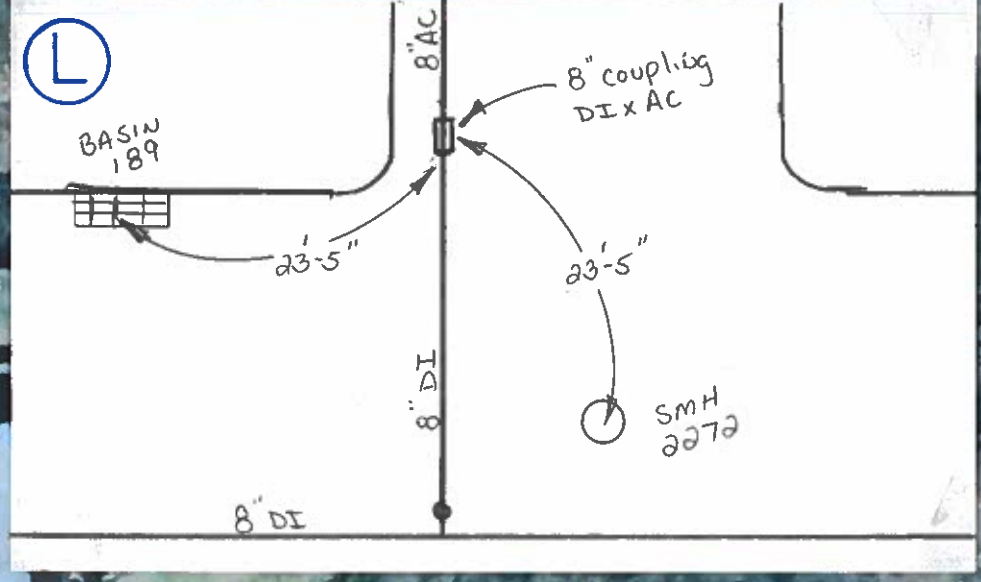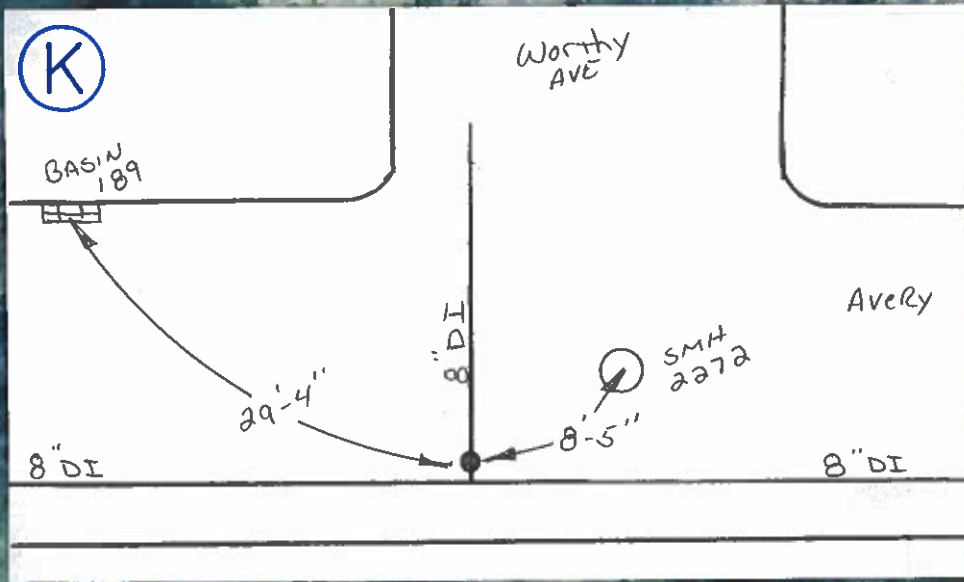


- | | | | | | | | |
|---------------------------|-------------------------------------|---------------------------------|------------------------|-----------------------|---------------------|-----------------------------------|-------------------------|
| ● Active Sewer Manhole | ● Bend fitting | — Abandoned Gravity Sewage Main | ● Capped End | ■ Detention Basin | ● Cross Fitting | ● Other Service Valve | ■ Water Meter Pit |
| ● Abandoned Sewer Manhole | — Tee Wye; Tee fitting; Wye fitting | — Abandoned Forced Sewage Main | ▲ Flared End Structure | ■ Drain Easement | ● Plug Fitting | ● Gate Valve | ■ Water Pumping Station |
| — Sewer Connection | ● Cap fitting | — Concrete Encasement | ■ Headwall; Endwall | ● Hydrant | ● Increase; Reducer | ● Butterfly Valve | ■ Fire Pump |
| ■ Other Features | ● Clean-out fitting | — Steel Sleeve | ■ Rip-rap | ● Other Water Fitting | ● Tap Fitting | ● Blow Off Valve | ■ Sample Station |
| ■ Wet Well | ■ Chimney fitting | — DI Sleeve | ● Drain Manholes | ● Bend Fitting | ● Tee Fitting | ● Other Water Feature | ■ Water tank |
| ■ Pump Station | ● Reducer | ■ Catch Basin | ● Outfalls | ● Coupling | ● Other Water Valve | ■ Thrust Protection | ■ Water Main |
| ● Other Fittings | — Sewer Lateral | ■ Undigitized Catch Basin | — Drain Line | ● Gate Valve | ● Butterfly Valve | ■ Abandoned / Inactive Water Main | ■ Proposed Water Main |
| | — Gravity Sewage Main | ▲ Other Drain Features | — Open Channel | ● Blow Off Valve | | | |
| | — Forced Sewage Main | | — Outvert | | | | |



The Town of East Longmeadow and its mapping contractors assume no legal responsibility for the information contained herein.

These data are not suitable for engineering applications or site work nor can the data be used to determine absolute delineation. Instead, the data should be used to portray zones of uncertainty and possible risks.

Map created by East Longmeadow Utilities Application
Orthophotography Copyright Google c/o MassGIS.



1 inch = 47 feet
3/2/2022

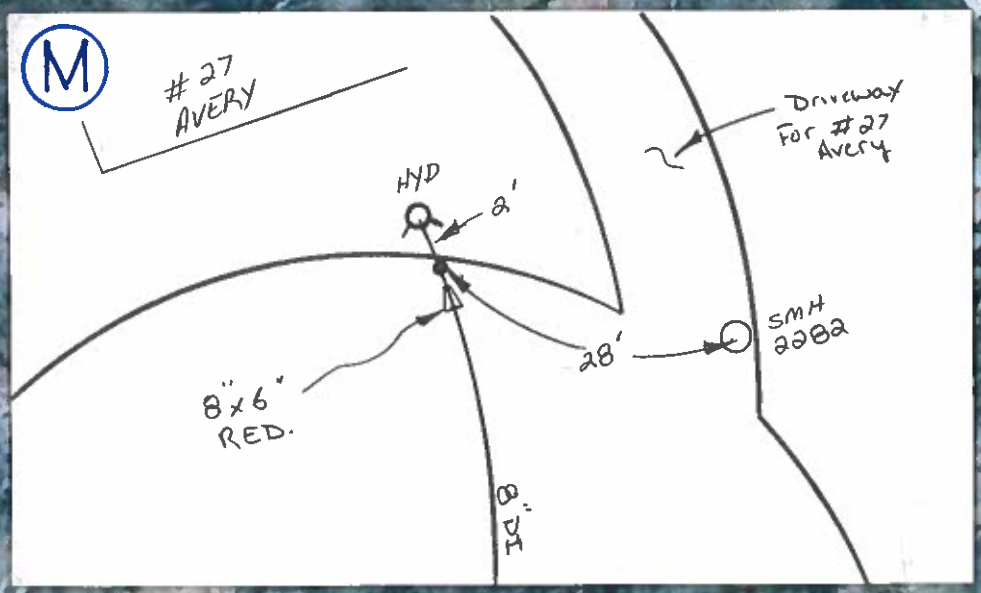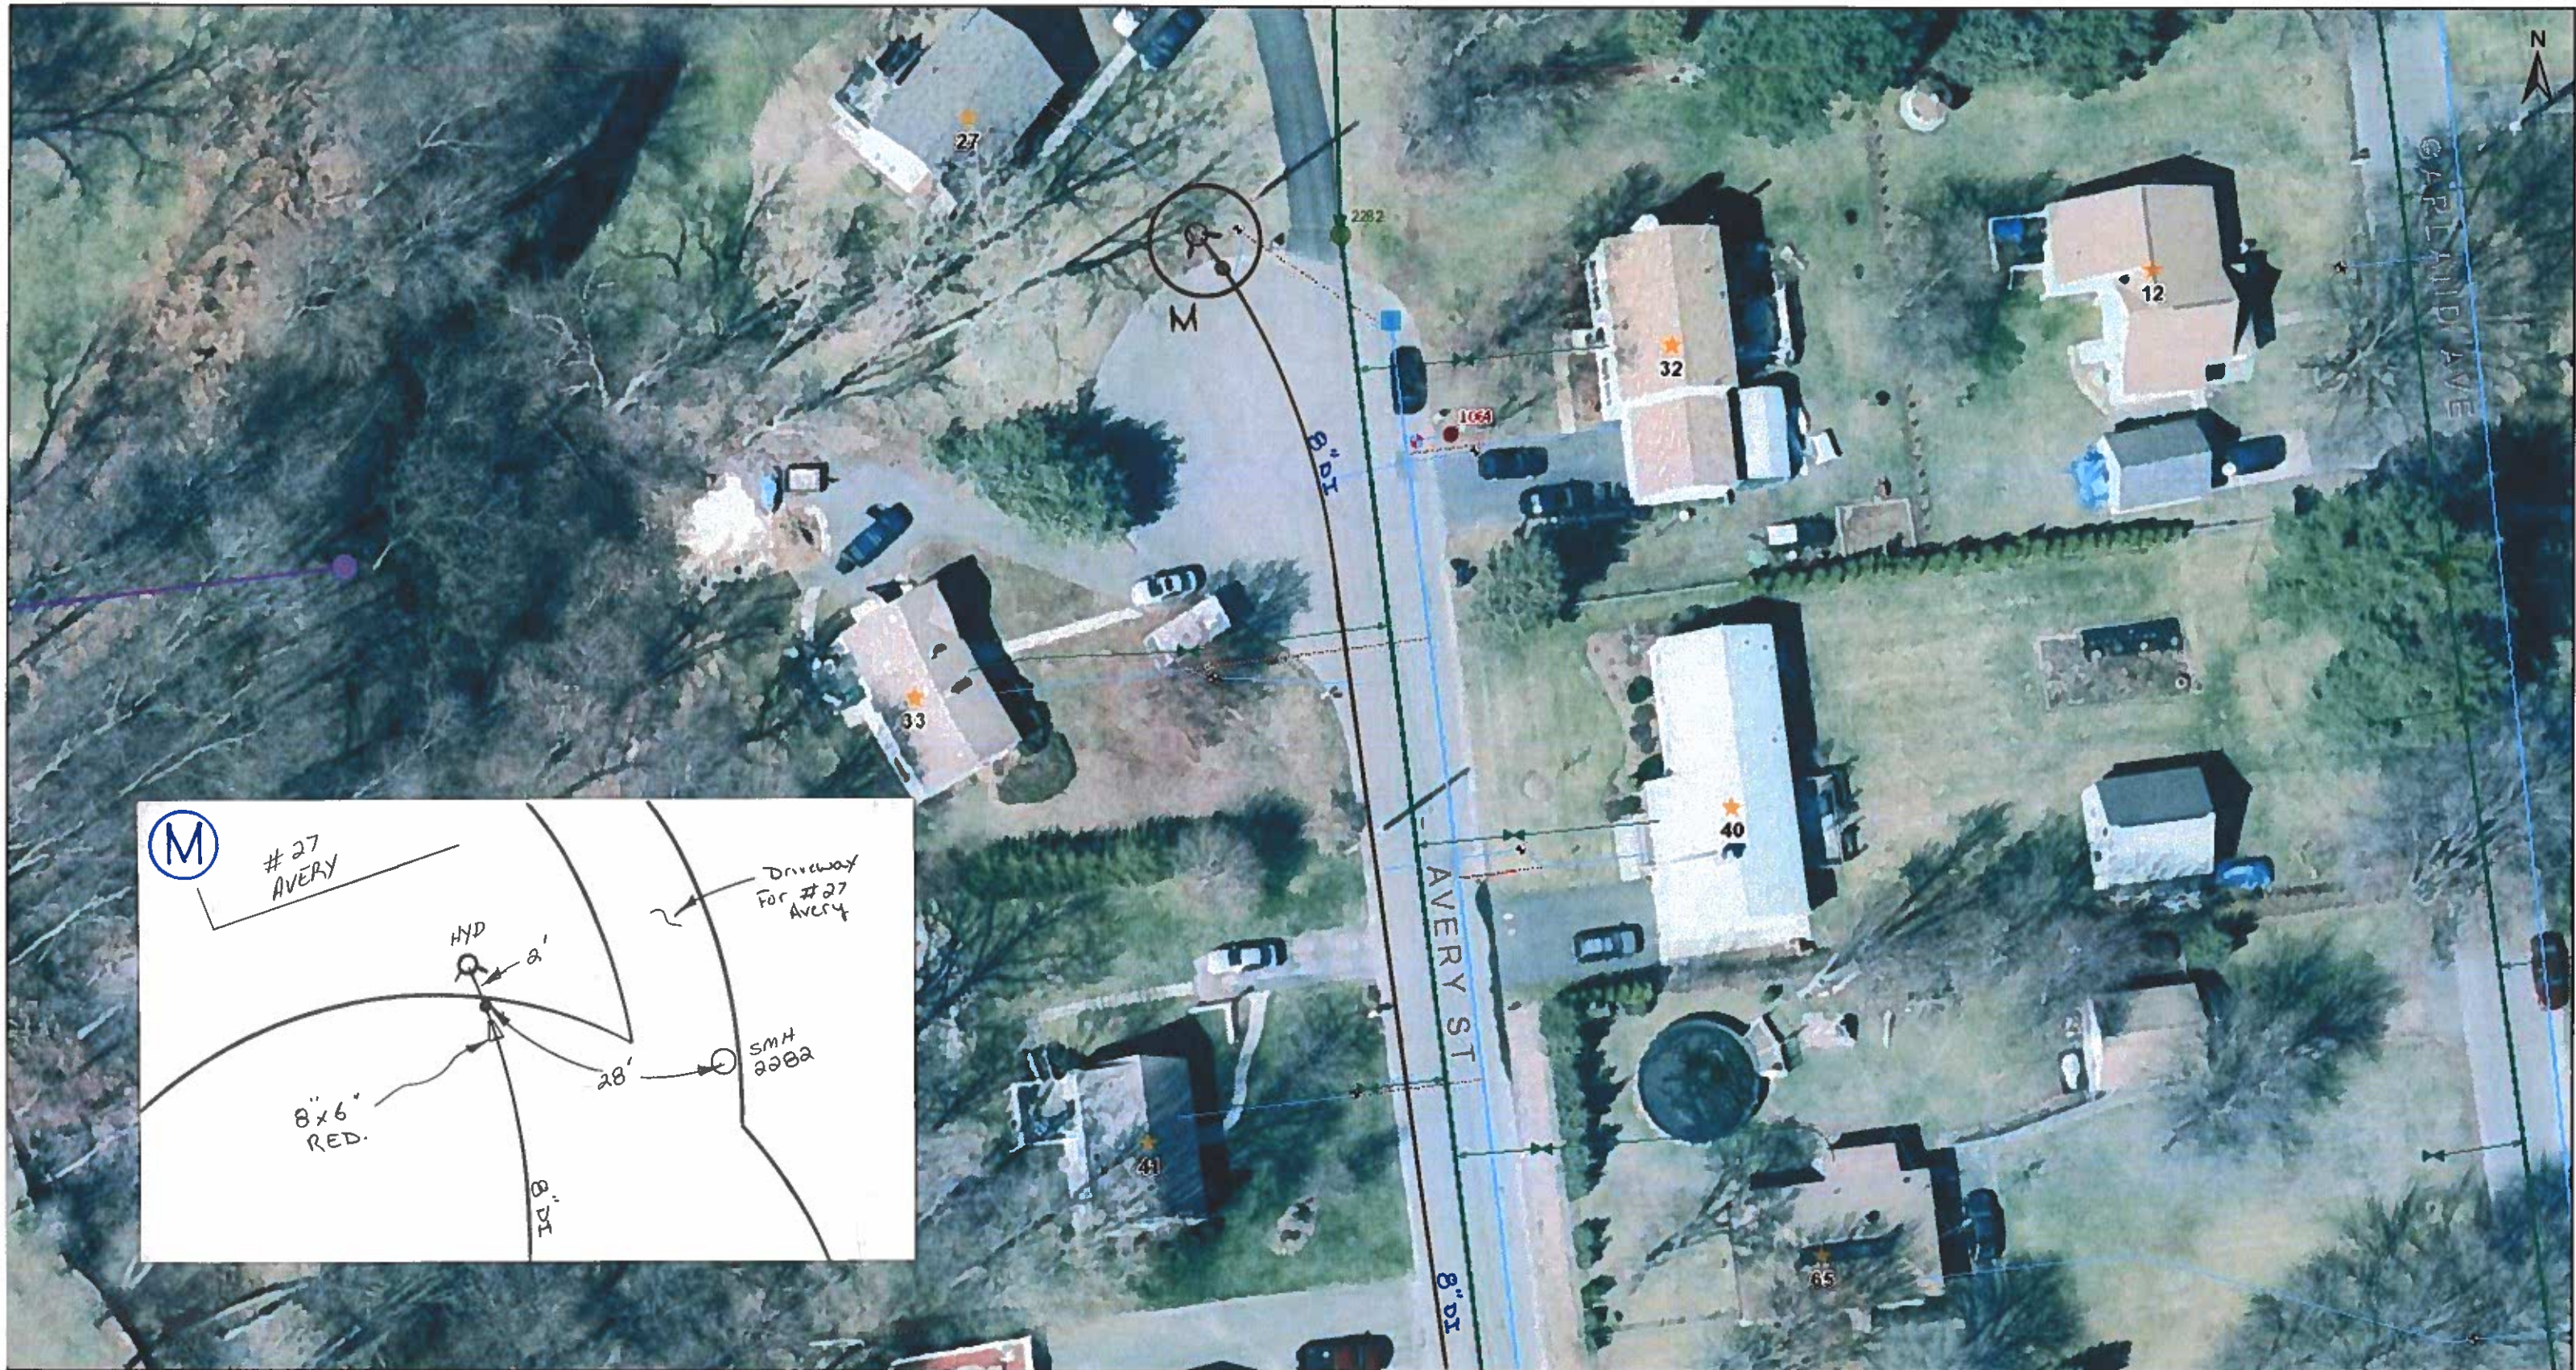

● Active Sewer Manhole	● Bend fitting	— Abandoned Gravity Sewage Main	● Capped End	■ Detention Basin	● Cross Fitting	● Other Service Valve	■ Water Meter Pit	— Abandoned Water Lateral
● Abandoned Sewer Manhole	— Tee Wye; Tee fitting; Wye fitting	— Abandoned Forced Sewage Main	▲ Flared End Structure	■ Drain Easement	● Plug Fitting	● Gate Valve	■ Water Pumping Station	— Proposed Water Lateral
● Sewer Connection	● Cap fitting	— Concrete Encasement	■ Headwall; Endwall	● Hydrant	● Insealer; Reducer	● Butterfly Valve	● Fire Pump	— Water Lateral
● Other Features	● Clean-out fitting	— Steel Sleeve	■ Rip-rap	● Other Water Fitting	● Tap Fitting	● Blow Off Valve	● Sample Station	■ Water Easement
■ Wet Well	● Chimney fitting	— DI Sleeve	● Drain Manholes	● Bend Fitting	● Tee Fitting	● Other Water Feature	● Water tank	— Easement Boundaries
■ Pump Station	● Reducer	■ Catch Basin	● Outfalls	● Cap Fitting	● Coupling	■ Thrust Protection	● Water Main	● Break Out Tanks
● Other Fittings	— Sewer Lateral	■ Undigitized Catch Basin	— Drain Line		● Other Water Valve		— Abandoned / Inactive Water Main	● LNG's
	— Gravity Sewage Main	▲ Other Drain Features	— Open Channel		● Gate Valve		— Proposed Water Main	— Pipelines
	— Forced Sewage Main		— Culvert		● Butterfly Valve			
					● Blow Off Valve			

The Town of East Longmeadow and its mapping contractors assume no legal responsibility for the information contained herein.

These data are not suitable for engineering applications or site work nor can the data be used to determine absolute delineation. Instead, the data should be used to portray zones of uncertainty and possible risks.

Map created by East Longmeadow Utilities Application
Orthophotography Copyright Google c/o MassGIS.



1 inch = 47 feet
3/2/2022