NOTES:

1. THE EXISTING 12" AC FORCE MAIN (FROM STA 49+00 TO STA 90+00) IS NOT BEING ABANDONED AS PART OF THIS CONTRACT. THE EXISTING 12" FORCEMAIN WILL BE ABANDONED AT A FUTURE DATE AS PART OF CONTRACT NO. 2, AND SHALL REMAIN FULLY OPERATIONAL AT ALL TIMES.
2. THE CONSTRUCTION OF THE 6" DRAIN (WITH DUCKBILL CHECKVALVE) FROM THE FORCE MAIN FLUSHING CONNECTION TO THE EXISTING MANHOLE SHALL BE ANCILLARY TO THE BID PRICE FOR THE "FORCE MAIN FLUSHING STRUCTURE".

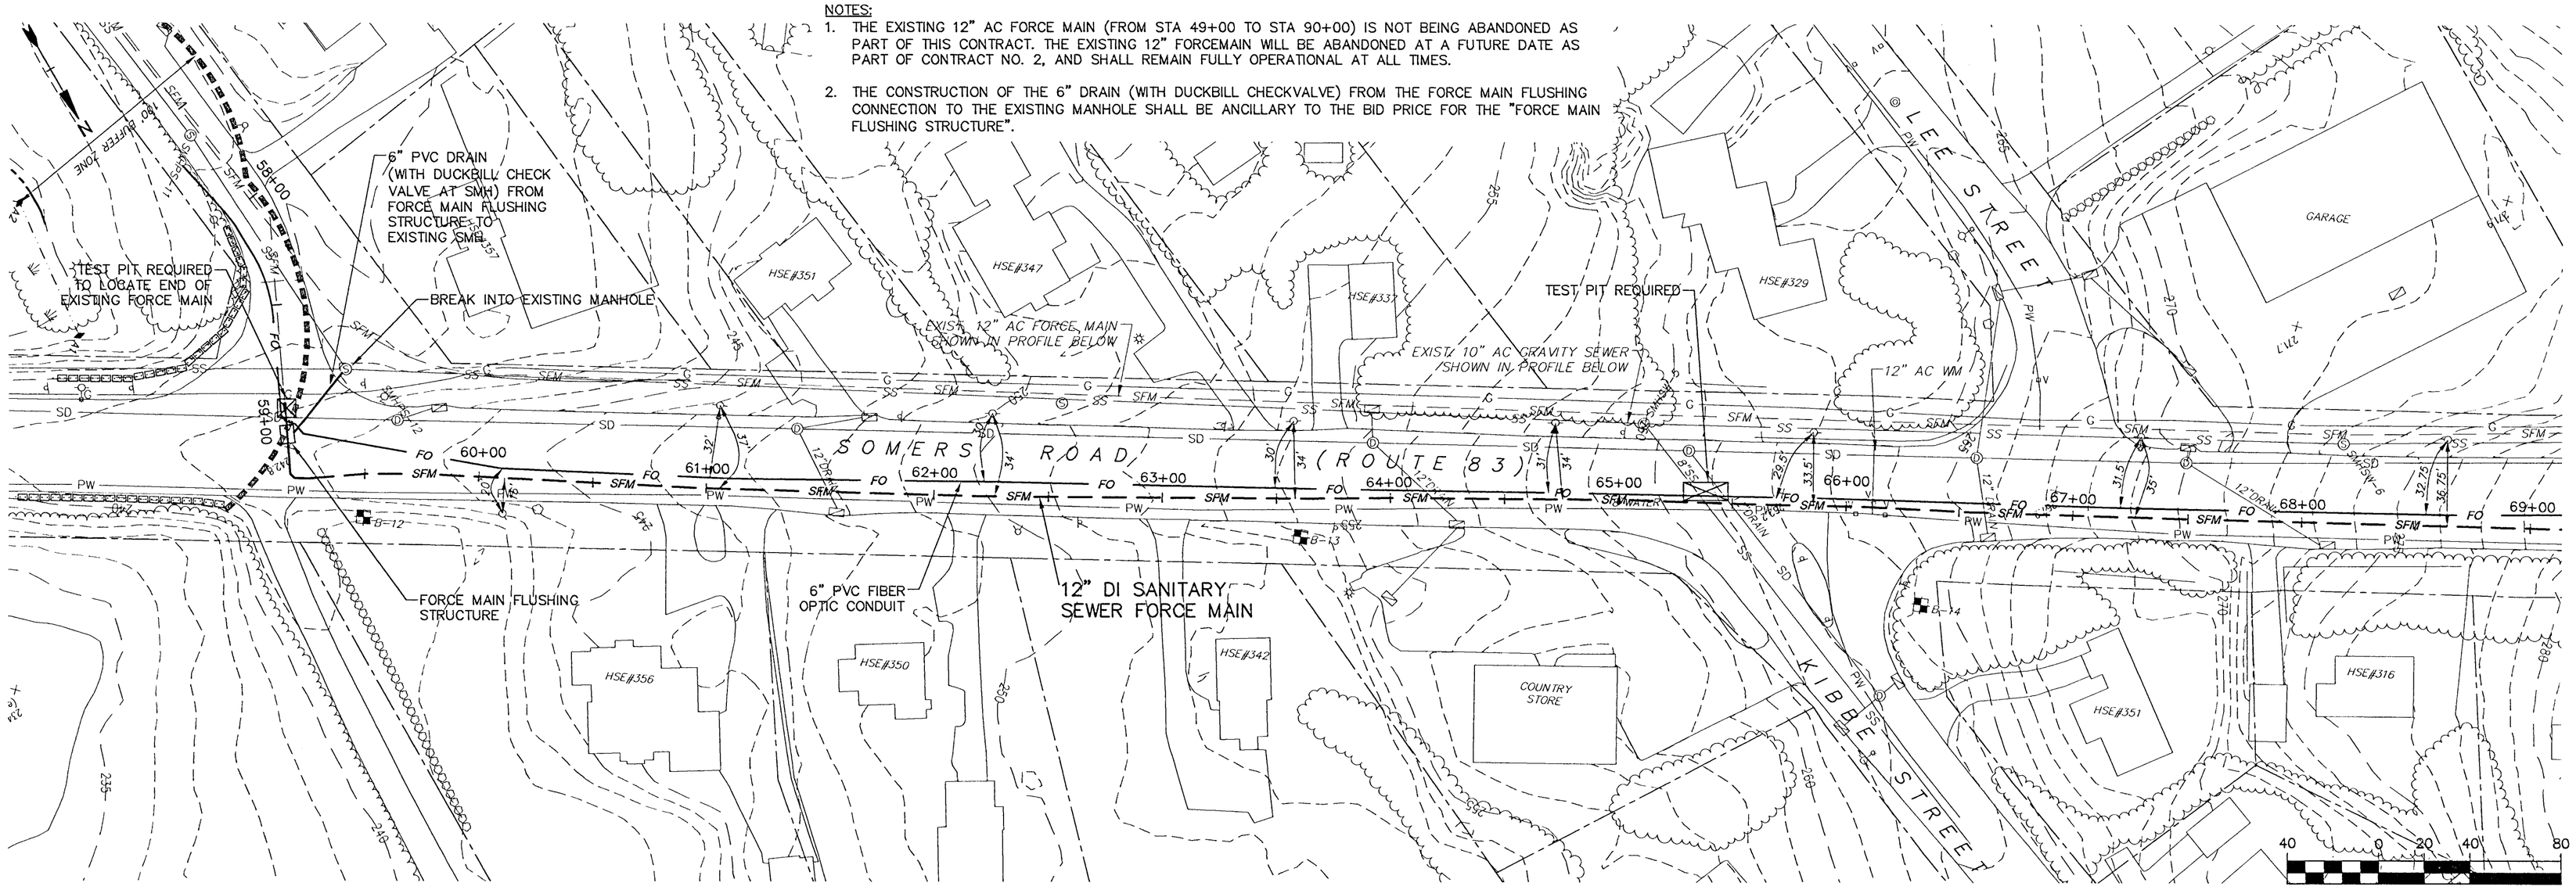

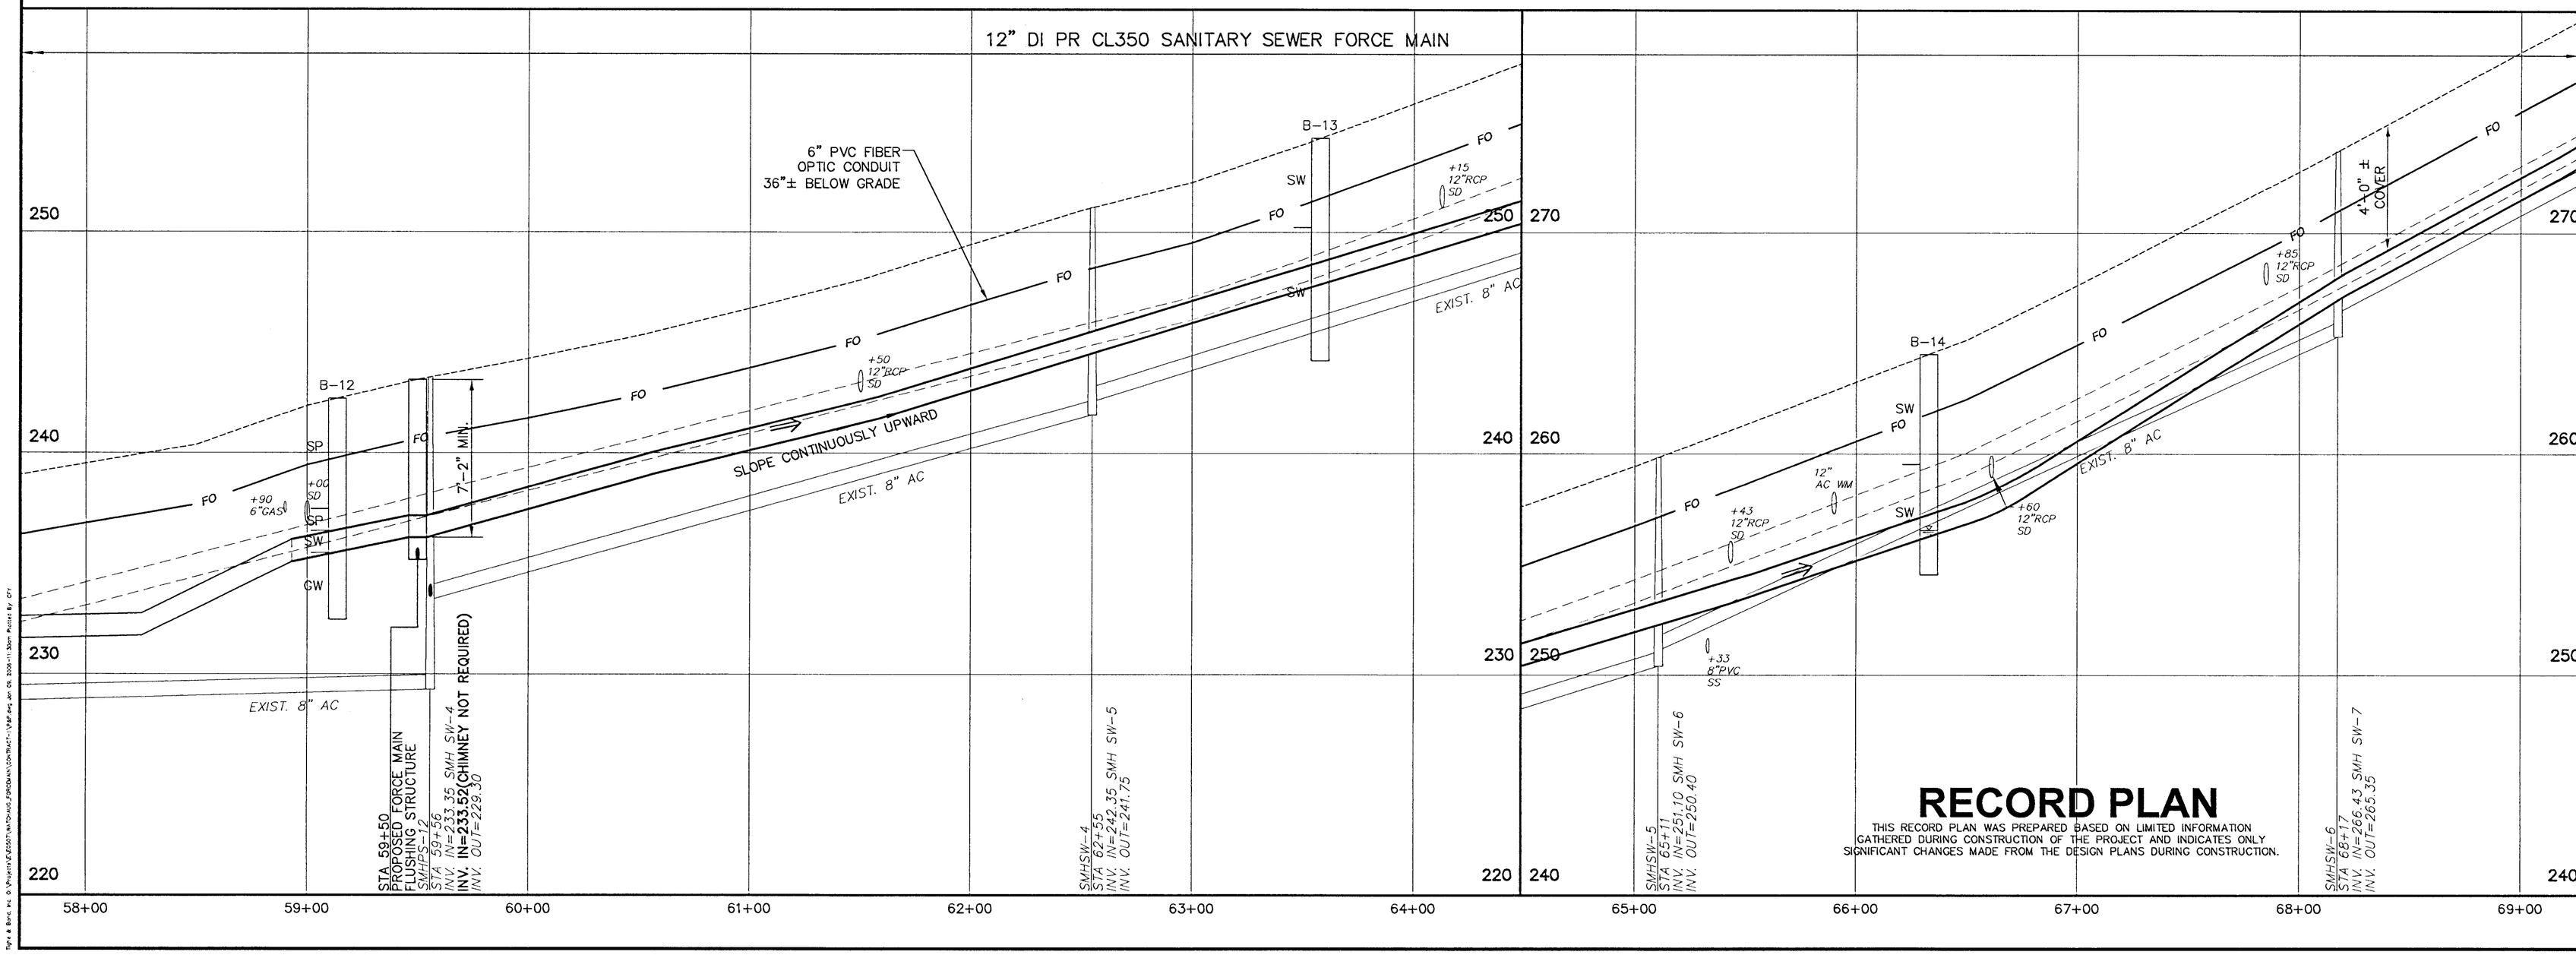

RECORD PLAN

THIS RECORD PLAN WAS PREPARED BASED ON LIMITED INFORMATION GATHERED DURING CONSTRUCTION OF THE PROJECT AND INDICATES ONLY SIGNIFICANT CHANGES MADE FROM THE DESIGN PLANS DURING CONSTRUCTION.

Tighe&Bond
Consulting Engineers
53 Southampton Road
Westfield, Massachusetts
(413) 562-1600
www.tighebond.com

COMMONWEALTH OF MASSACHUSETTS ROBERT PEIRENT CIVIL 36038 REGISTERED PROFESSIONAL ENGINEER 7/22/05

COMMONWEALTH OF MASSACHUSETTS DAVID R. PRICKETT CIVIL No. 46312 REGISTERED PROFESSIONAL ENGINEER 07/22/05

East Longmeadow Board of Public Works

Watchaug Force Main Replacement Contract No. 1

East Longmeadow, Massachusetts

Mark	Date	Description
2	1/06	Record Plan
1	08/10/05	Revised for Bidding
0	07/25/05	Issued for Permit Approval

PROJECT NO:	E-0507
FILE:\CONTRACT-1\	P&P.dwg/Layout7
DRAWN BY:	ARG
CHECKED:	DRP
APPROVED BY:	RP, MRP

PLAN & PROFILE
STA 61+00 TO STA 72+00

SCALE: 1"=40'H;1"=4'V

SHEET 5

1/9/06