NOTE:
THE EXISTING 12" AC FORCE MAIN (FROM STA 49+00 TO STA 90+00) IS NOT BEING ABANDONED AS PART OF THIS CONTRACT. THE EXISTING 12" FORCEMAIN WILL BE ABANDONED AT A FUTURE DATE AS PART OF CONTRACT NO. 2, AND SHALL REMAIN FULLY OPERATIONAL AT ALL TIMES.

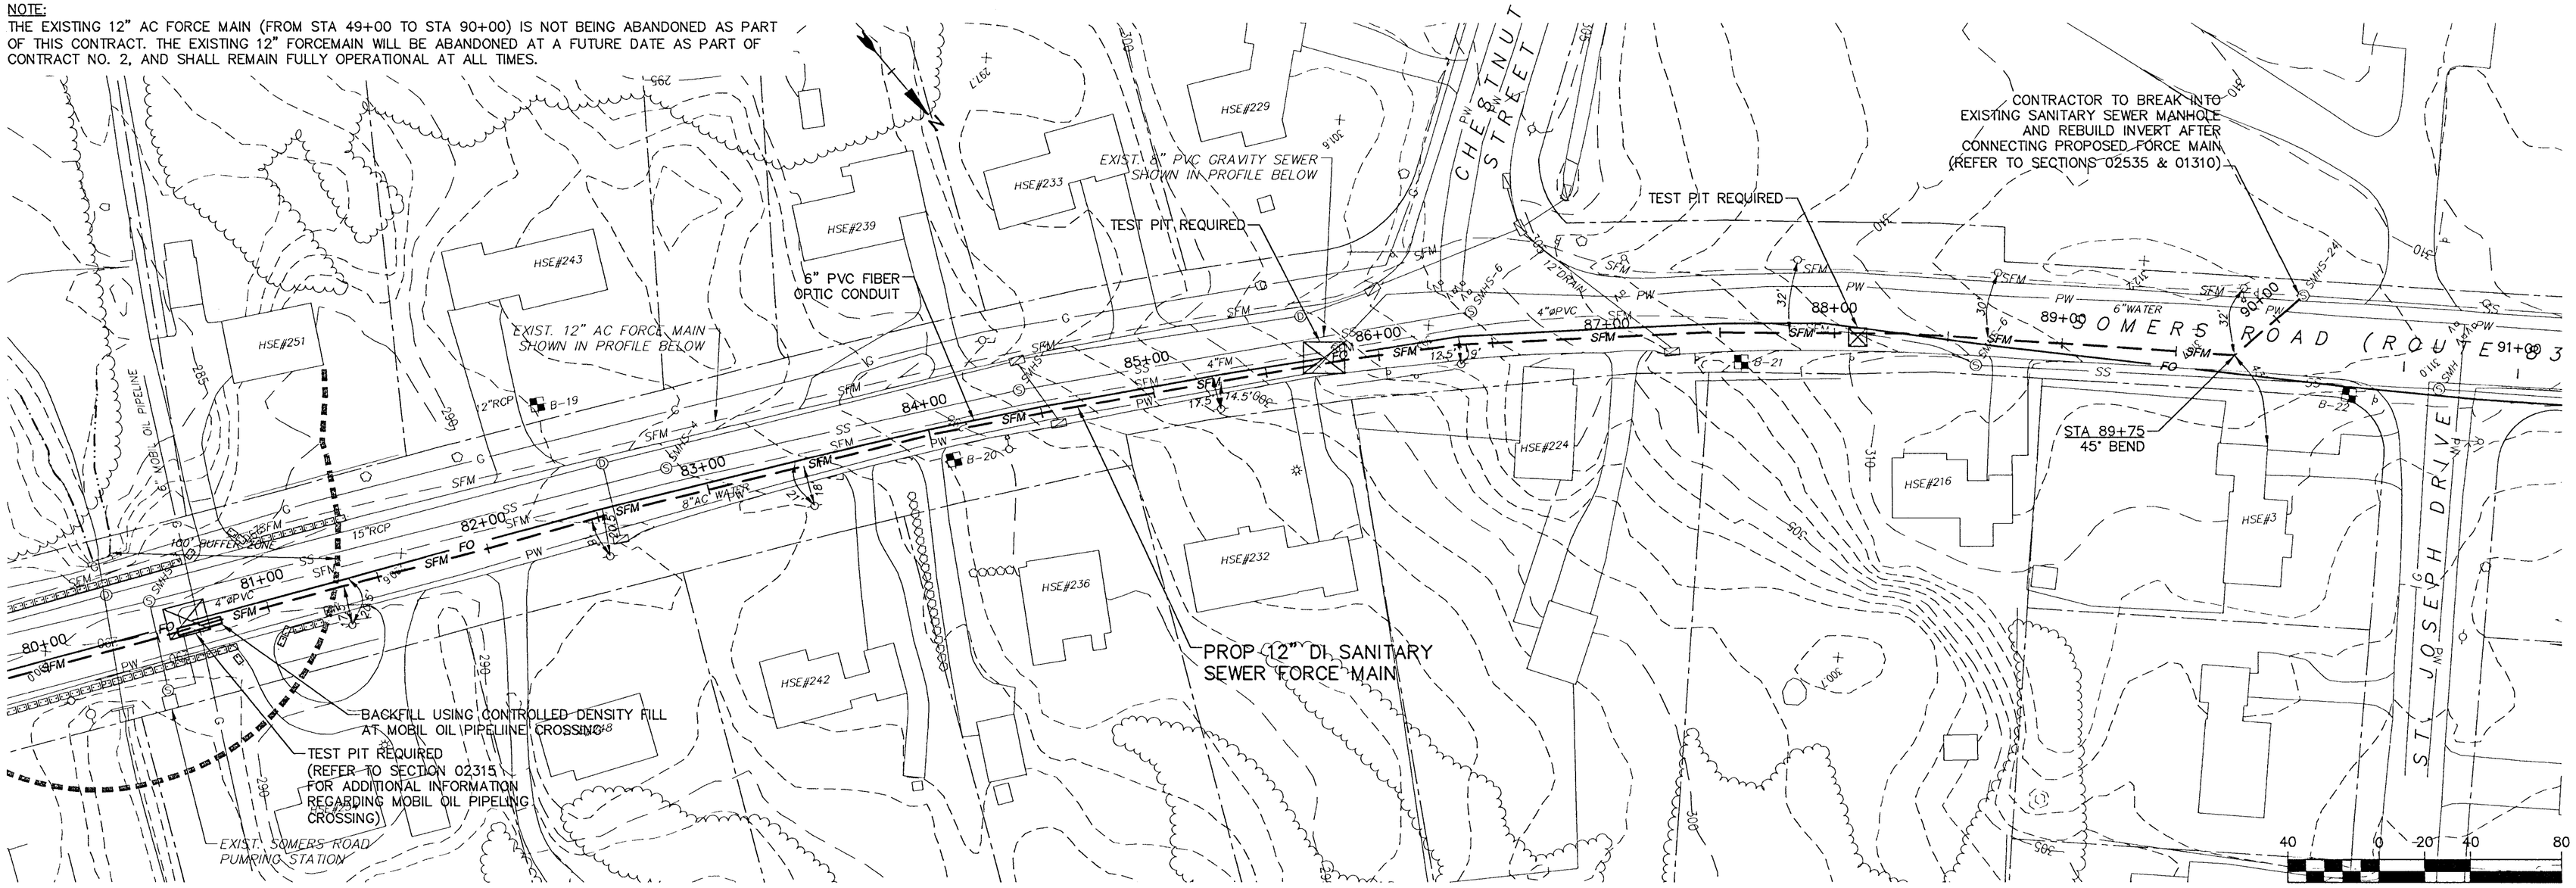

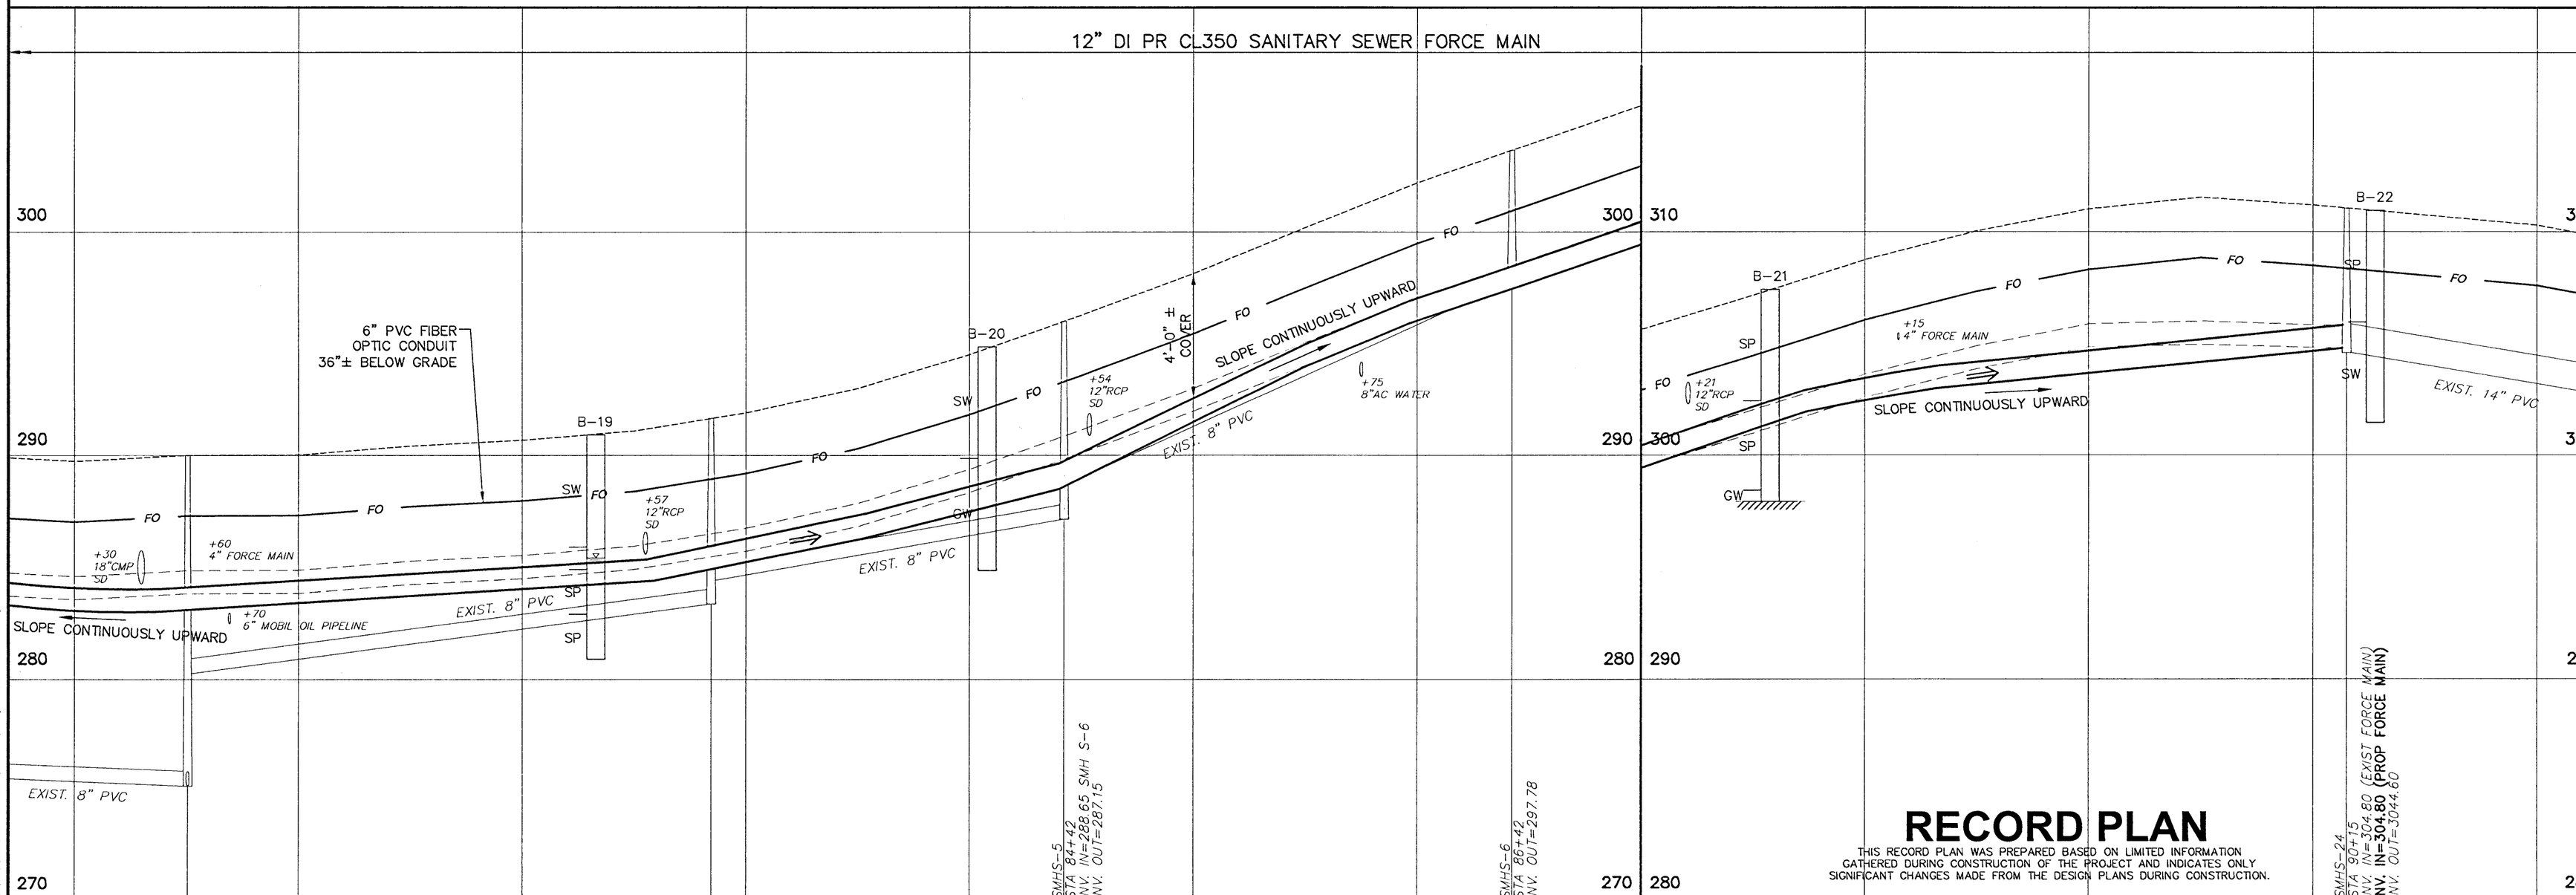

Tighe&Bond
Consulting Engineers
53 Southampton Road
Westfield, Massachusetts
(413) 562-1600
www.tighebond.com

COMMONWEALTH OF MASSACHUSETTS ROBERT PEIRENT CIVIL 36038 REGISTERED PROFESSIONAL ENGINEER 7/22/05

COMMONWEALTH OF MASSACHUSETTS DAVID R. PRICKETT CIVIL No. 46312 REGISTERED PROFESSIONAL ENGINEER 07/22/05

East Longmeadow Board of Public Works

Watchaug Force Main Replacement Contract No. 1

East Longmeadow, Massachusetts

Mark	Date	Description
2	1/06	Record Plan
1	08/10/05	Revised for Bidding
0	07/25/05	Issued for Permit Approval

PROJECT NO:	E-0507
FILE:	\CONTRACT-1\ P&P.dwg/Layout9
DRAWN BY:	ARG
CHECKED:	DRP
APPROVED BY:	RP, MRP

PLAN & PROFILE
STA 83+00 TO STA 94+00

SCALE: 1"=40'H;1"=4'V

SHEET 7

1/6/06