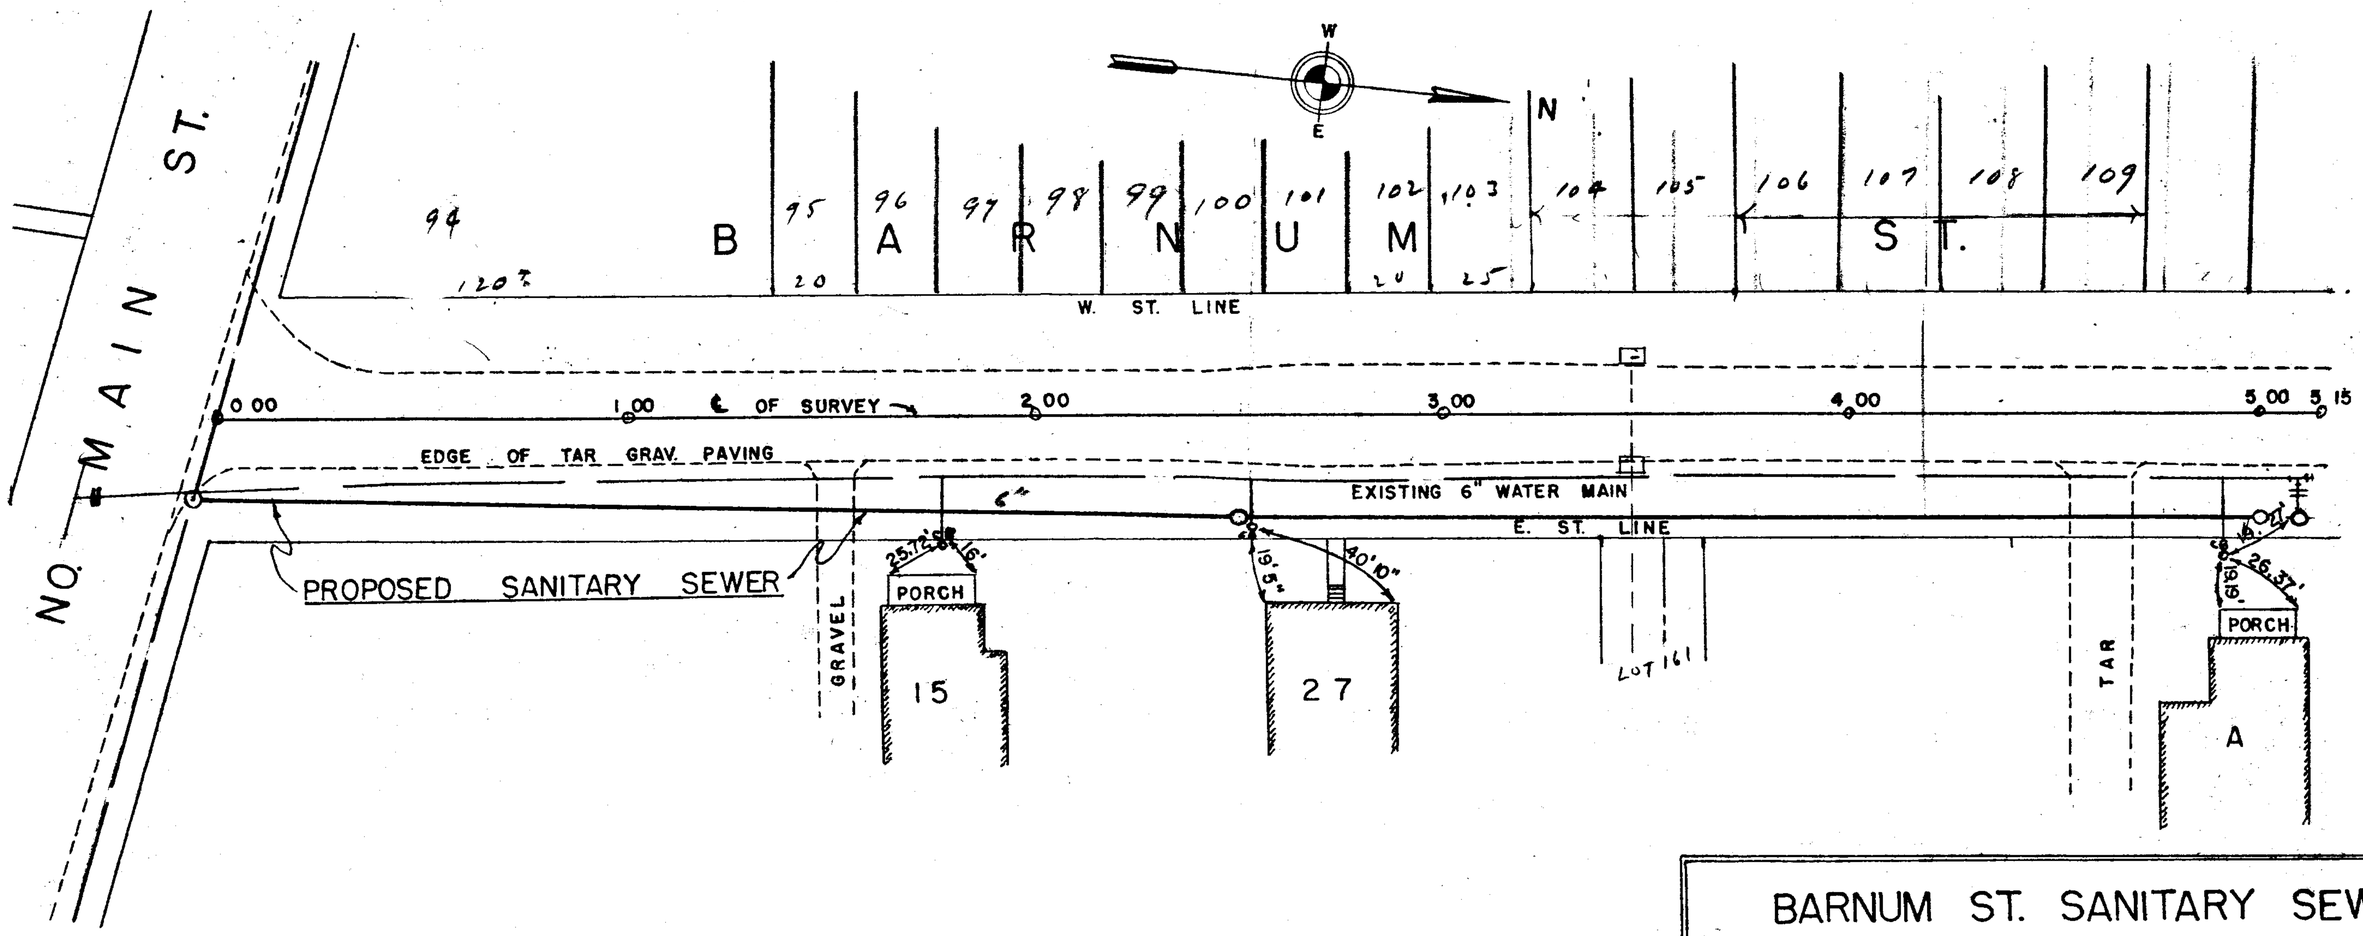

BARNUM ST. SANITARY SEWER

BOARD OF SELECTMEN

TOWN OF EAST LONGMEADOW, MASS

TIGHE & BOND, CONSULTING ENGINEERS,
HOLYOKE, MASS.

SCALE: HORZ. 1" = 40'
VERT. 1" = 4'
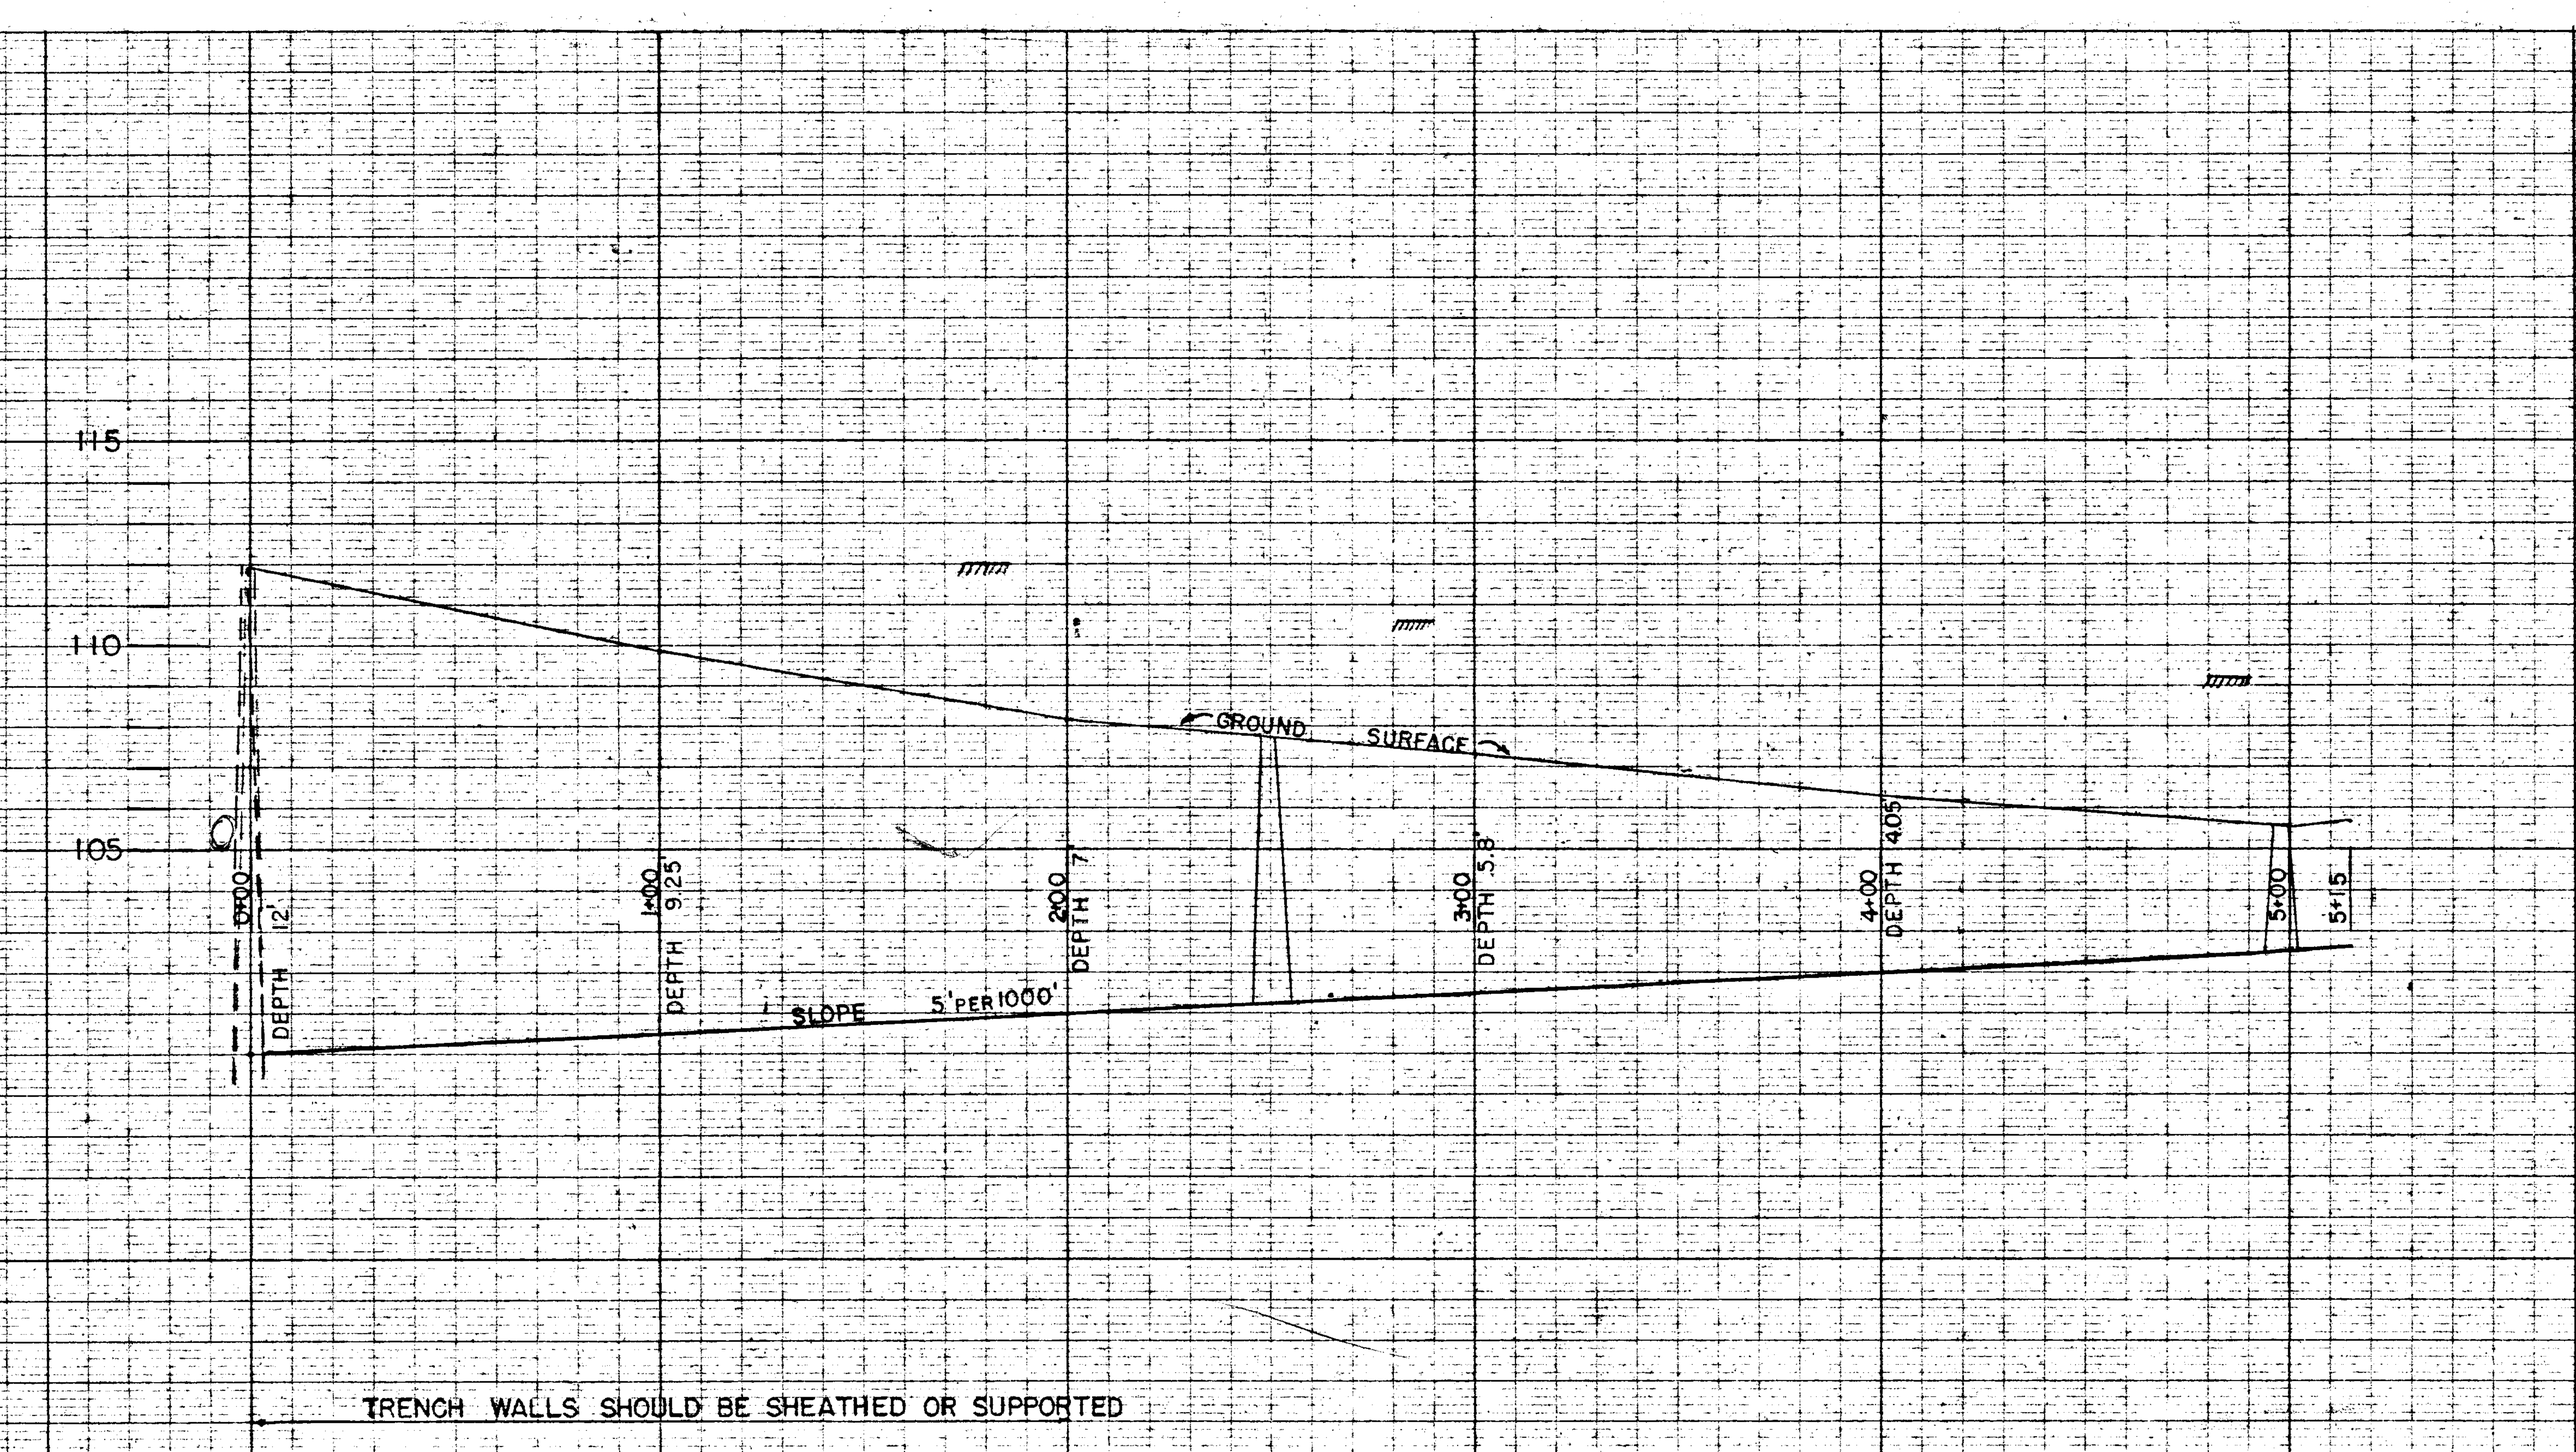
MARCH, 1953