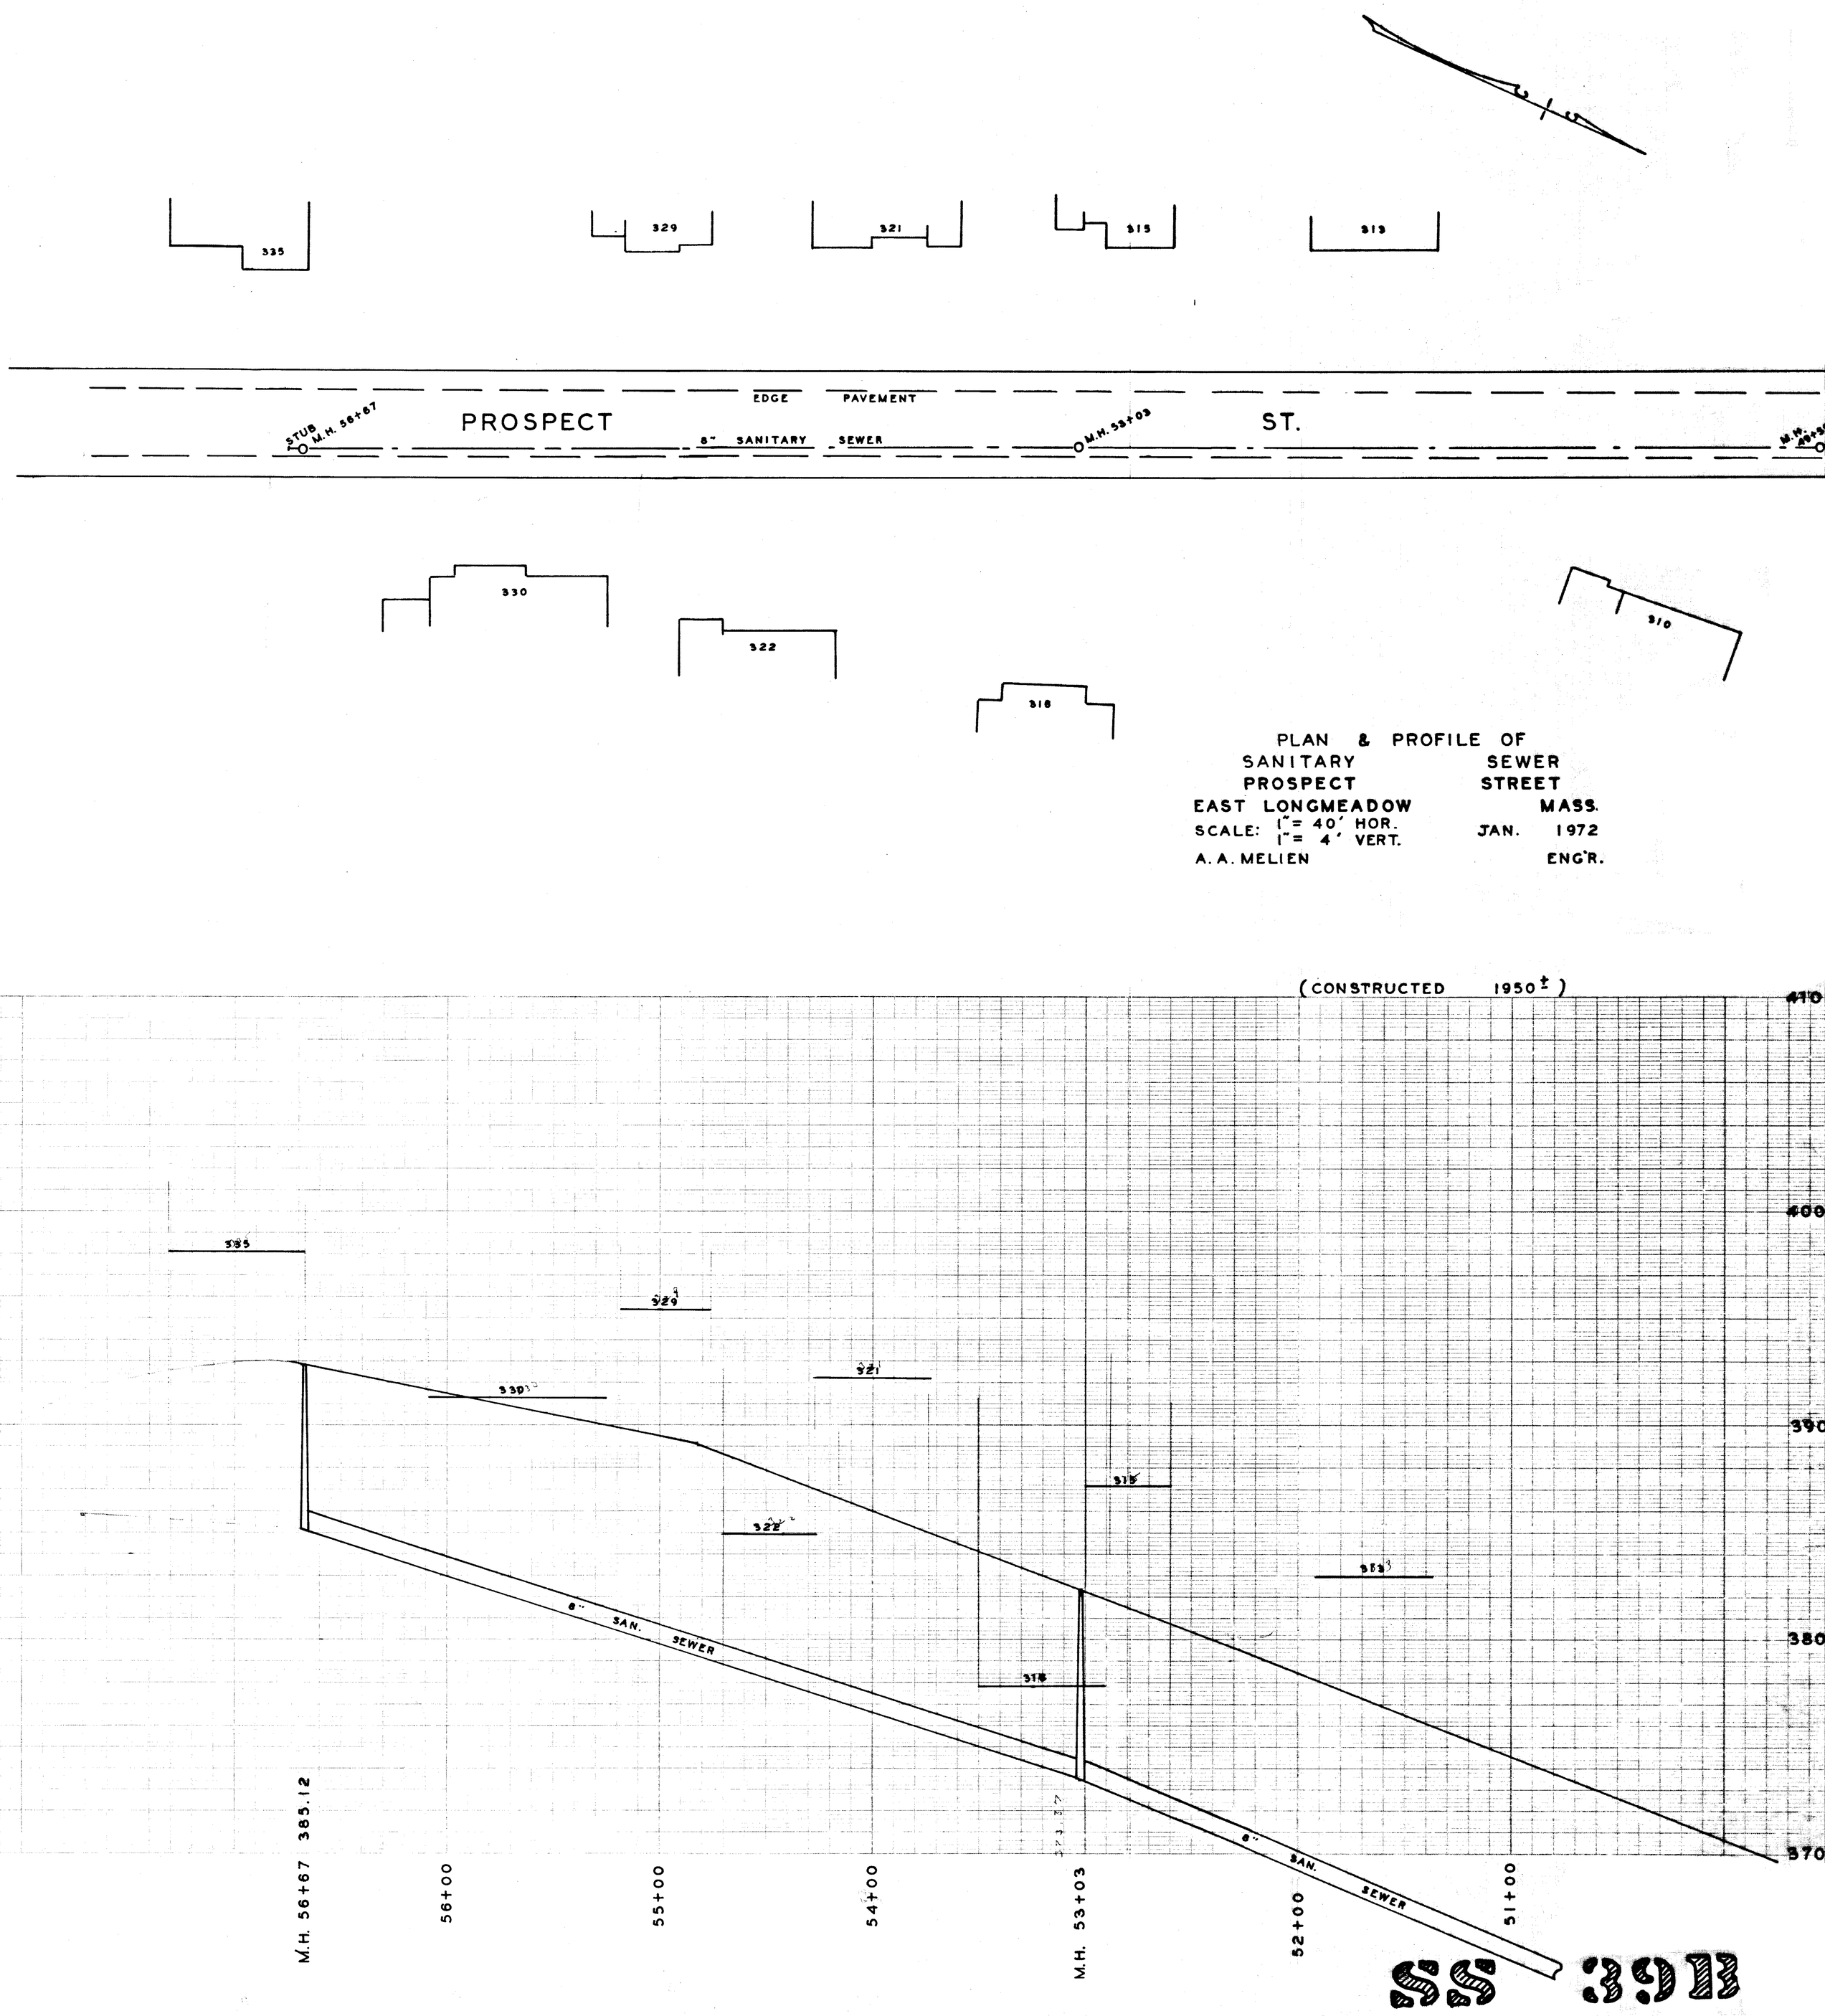
335
329
321
315
313
EDGE PAVEMENT
STUB
M.H. 56+67
PROSPECT
8" SANITARY SEWER
M.H. 53+03
ST.
330
322
318
310
PLAN & PROFILE OF
SANITARY SEWER
PROSPECT STREET
EAST LONGMEADOW MASS.
SCALE: 1" = 40' HOR.
1" = 4' VERT.
JAN. 1972
A. A. MELIEN ENG'R.
(CONSTRUCTED 1950±)
410
400
390
380
370
8" SAN. SEWER
M.H. 56+67 385.12
56+00
55+00
54+00
M.H. 53+03
52+00
51+00