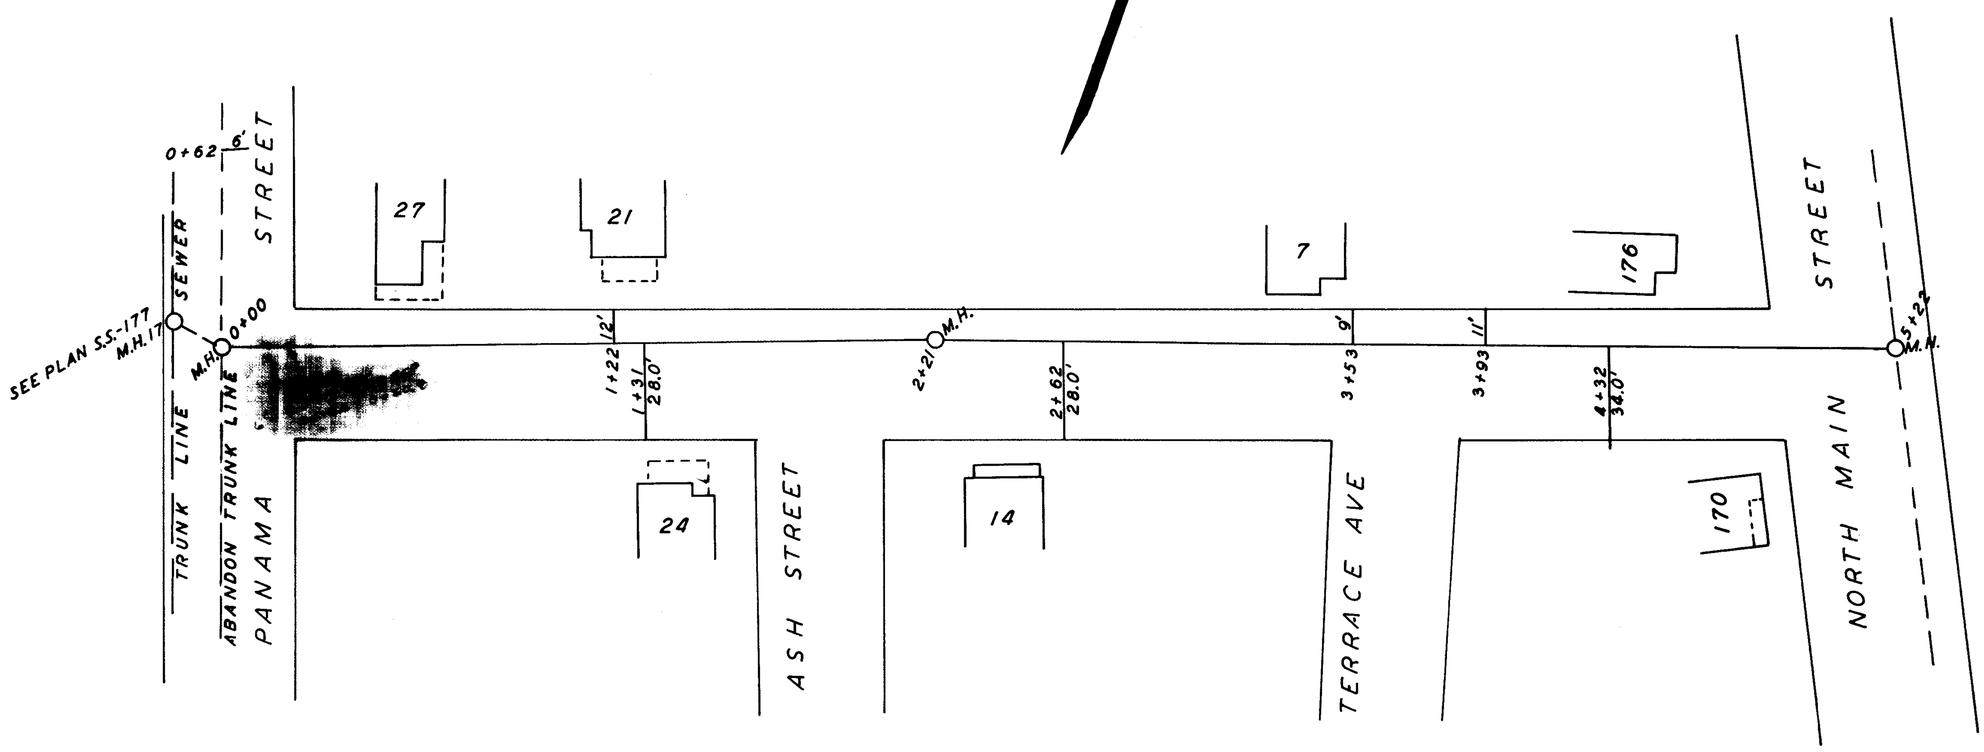

PLAN SHOWING SANITARY SEWER

DEWEY AVENUE

TOWN OF EAST LONGMEADOW, MASSACHUSETTS

TIGHE & BOND CONS. ENG'RS.

HOLYOKE, MASS.

SCALE: HOR: 1" = 40'
VER: 1" = 4'

APRIL, 1940

COPY BY D. P. W. - - - - JAN, 1965 J.P.M.

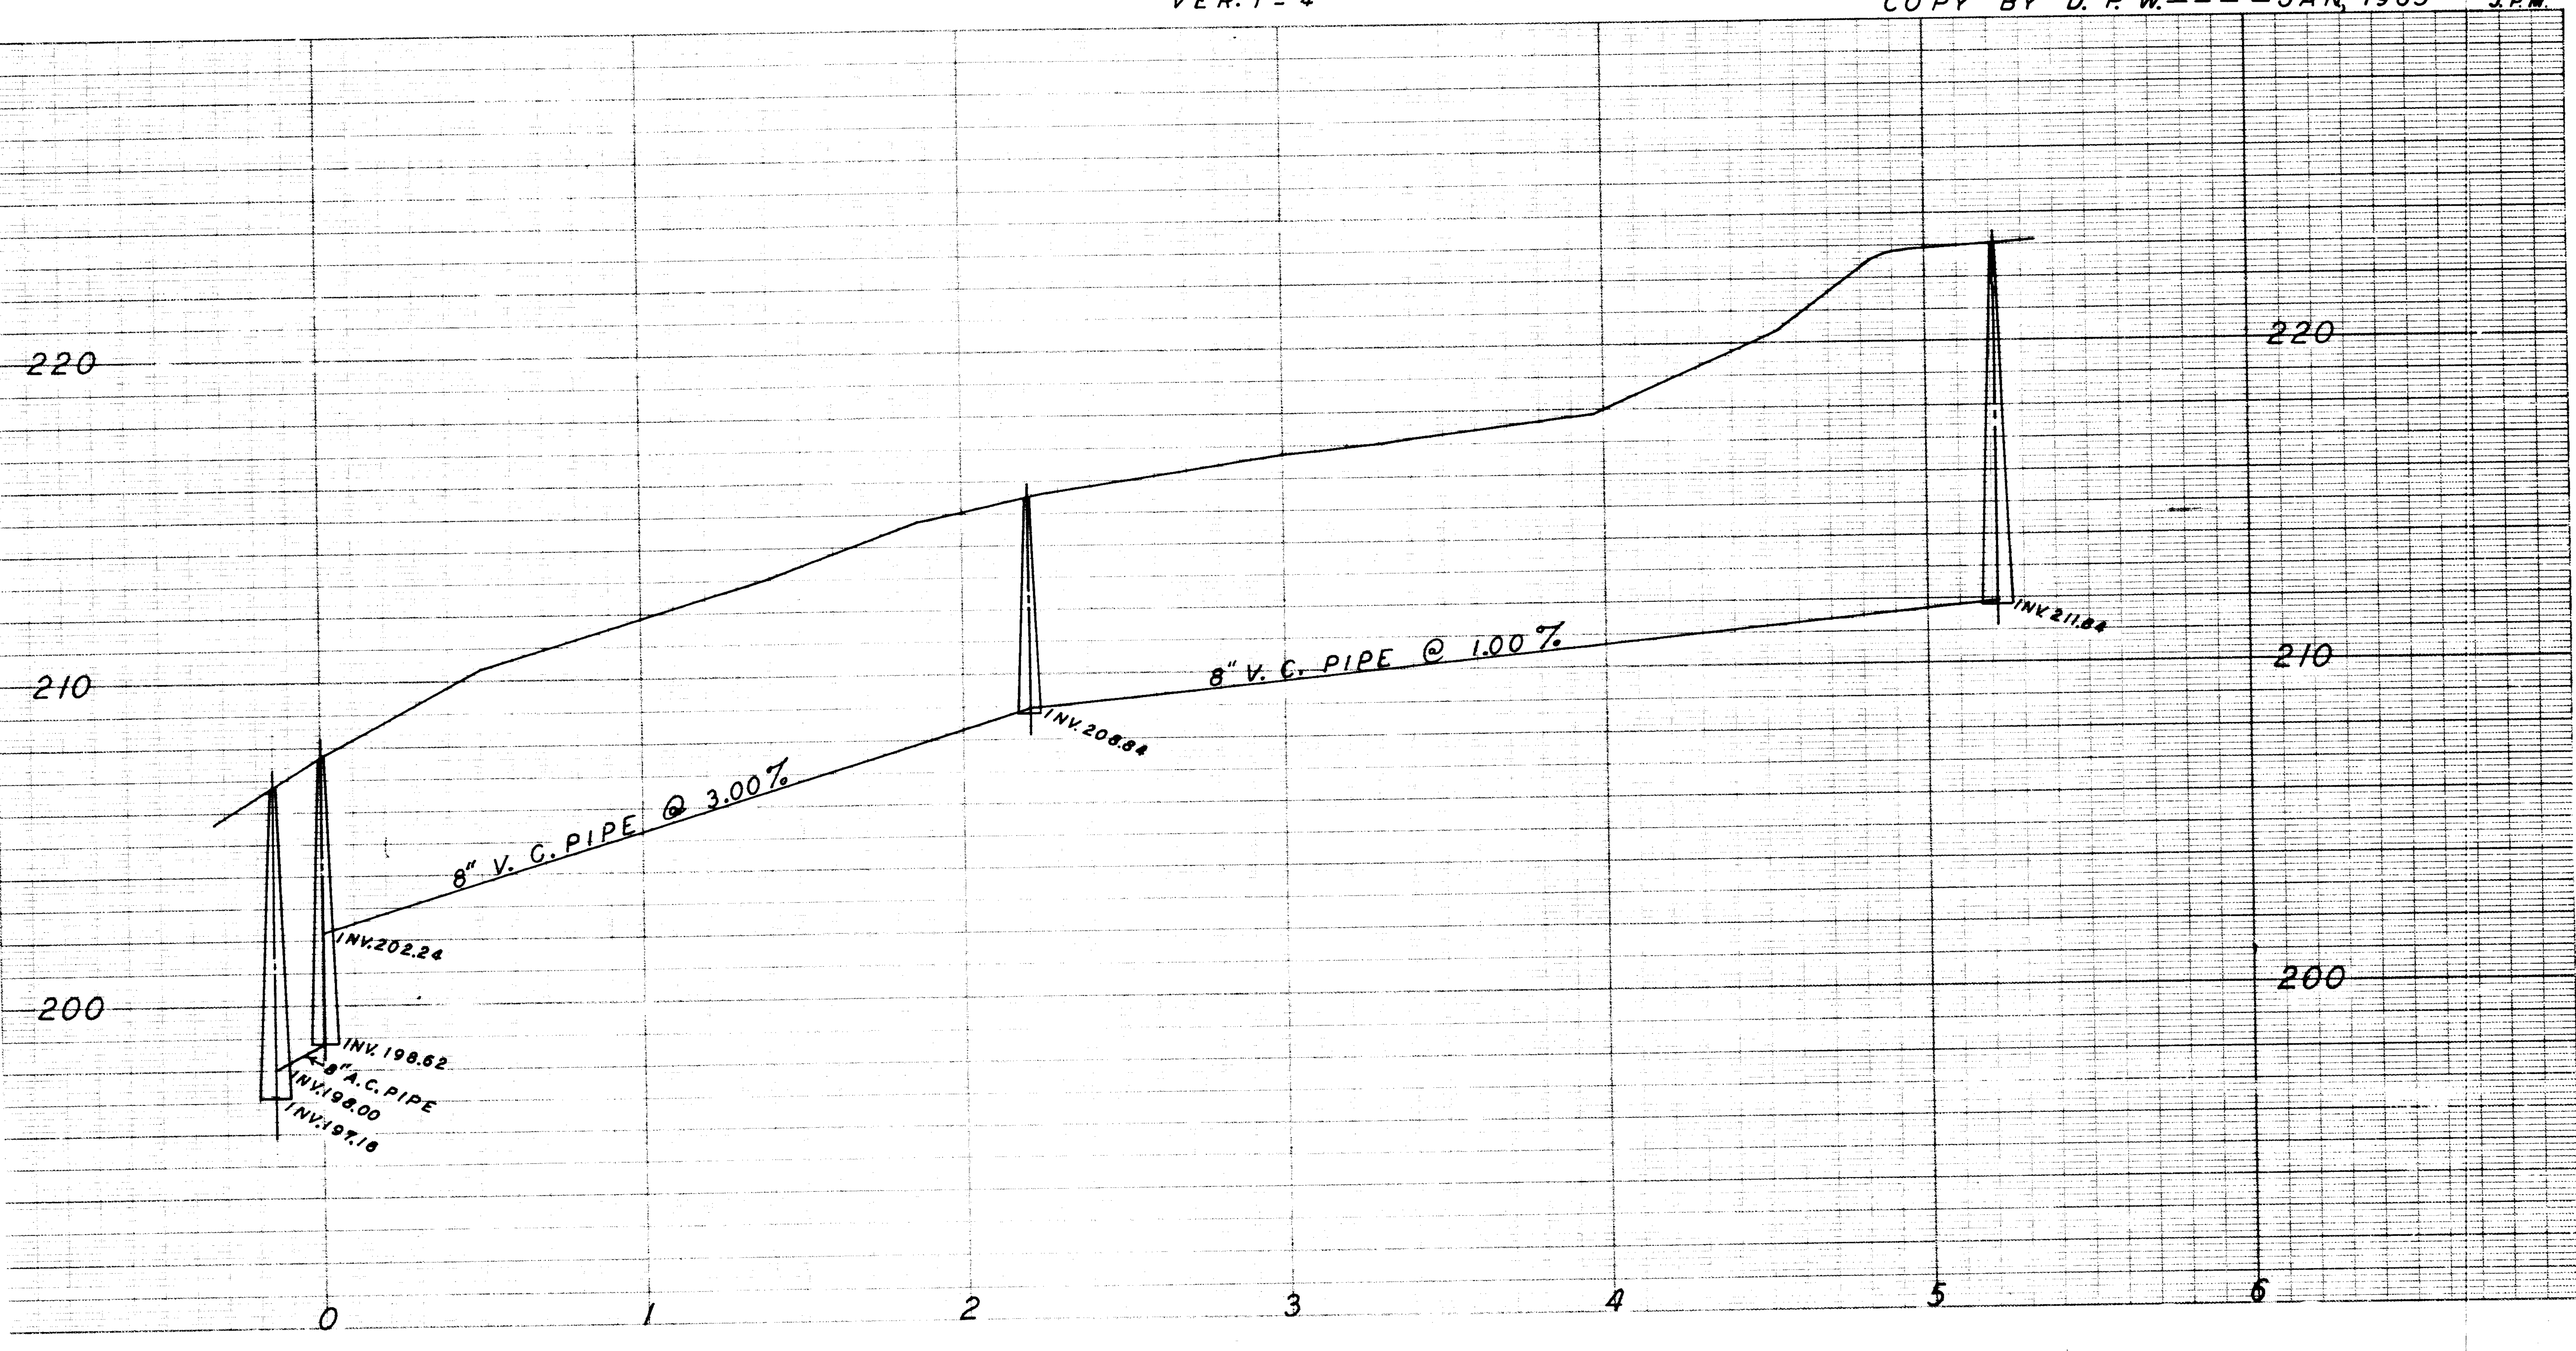

DEWEY AVENUE

S S-69