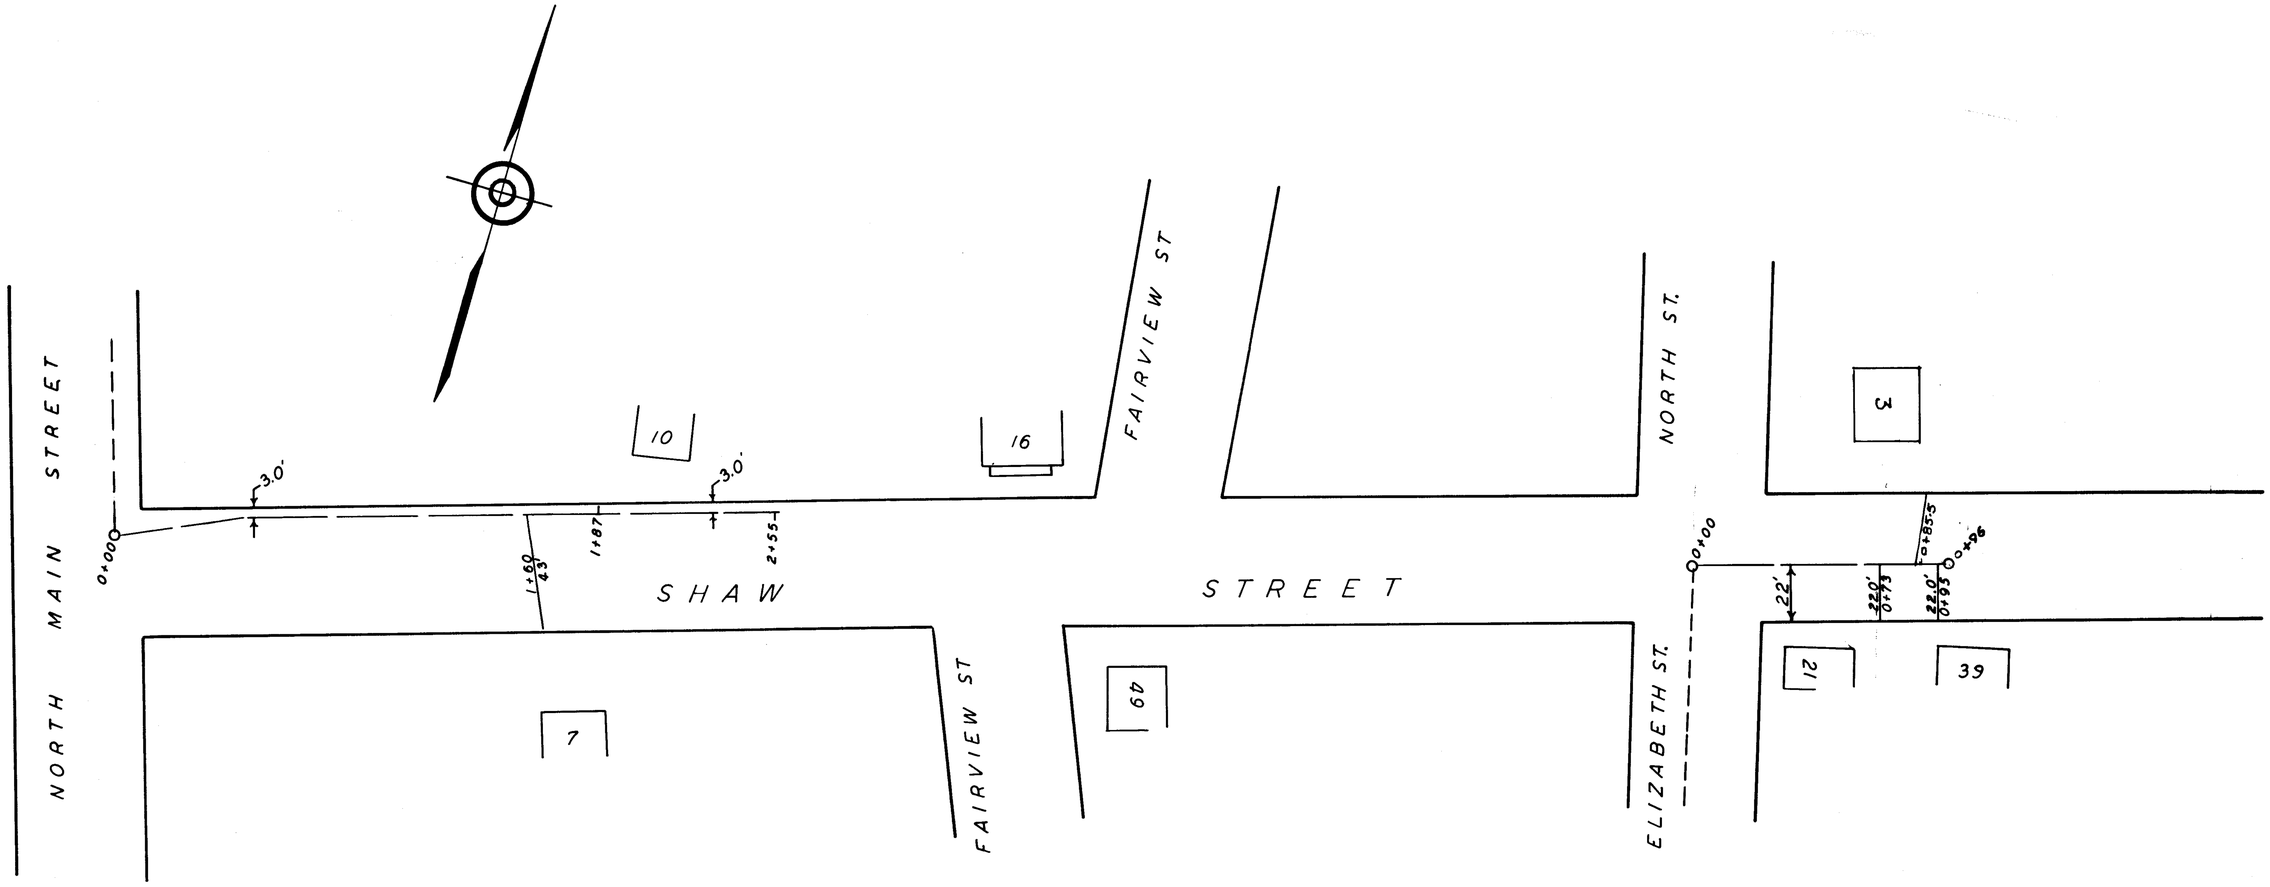

PLAN SHOWING SANITARY SEWER
SHAW STREET
TOWN OF EAST LONGMEADOW, MASSACHUSETTS
TIGHE & BOND CONSTRUCTION ENG'RS.
HOLYOKE, MASS.

SCALE: HOR: 1"= 40'
VER: 1"= 8'

COPY BY D. P. W. ----- JAN. 1965

J. P. M.

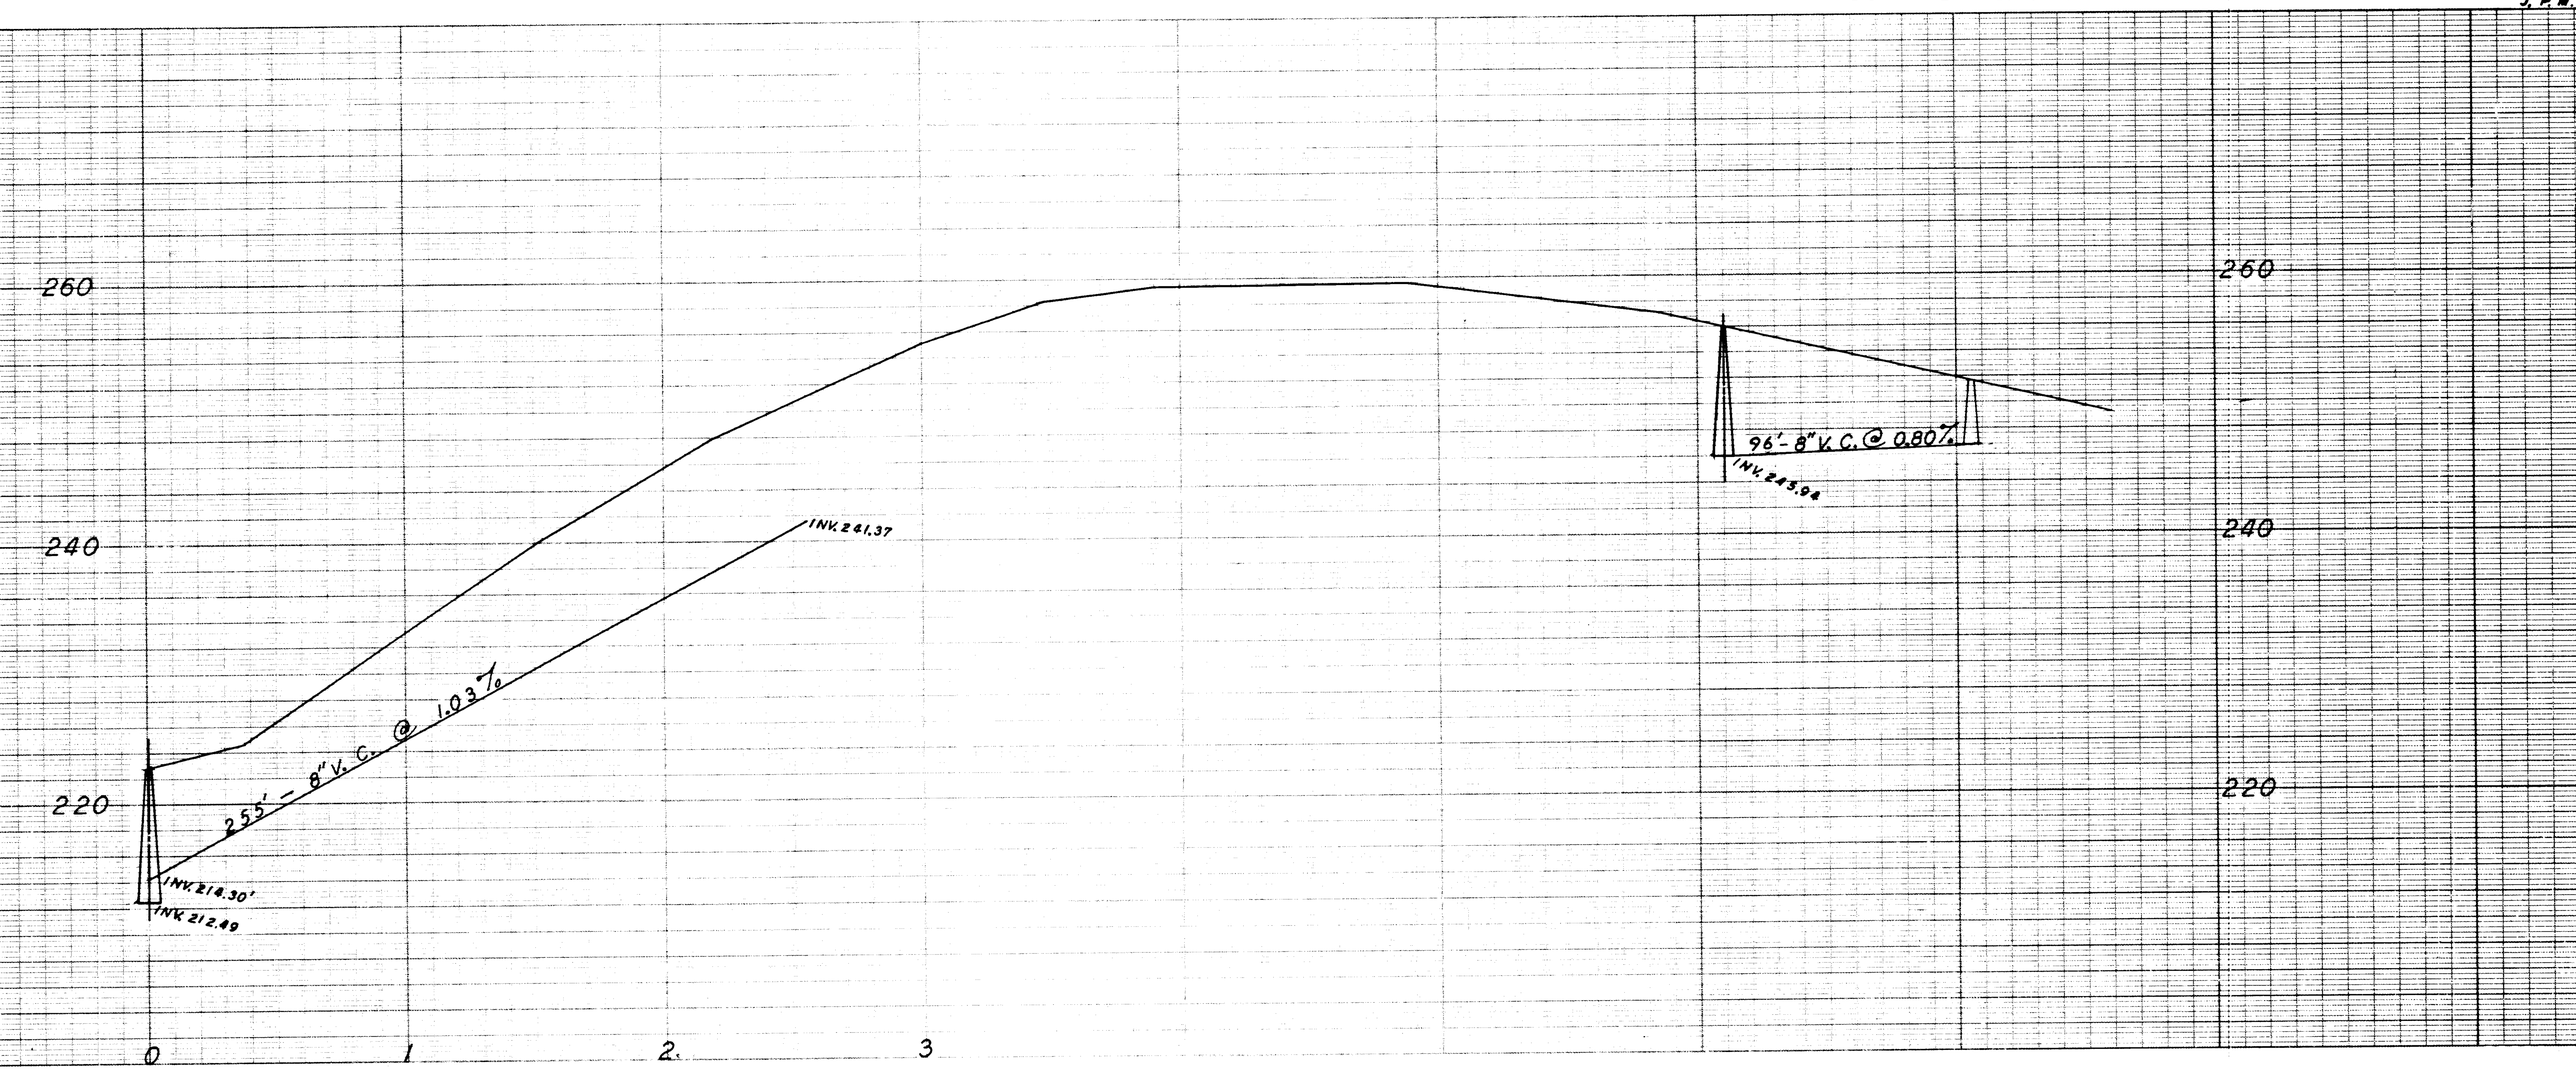

SS-73