SANITARY SEWER
TOWN OF EAST LONGMEADOW, MASS
HARKNESS AVE. TRUNK SEWER

TIGHE & BOND, CONS. ENG'RS
HOLYOKE, MASS.,

SCALE: HOR. 1" = 40'
VER. 1" = 4' SEPT. 194

COPY BY D.P.W. APRIL 958

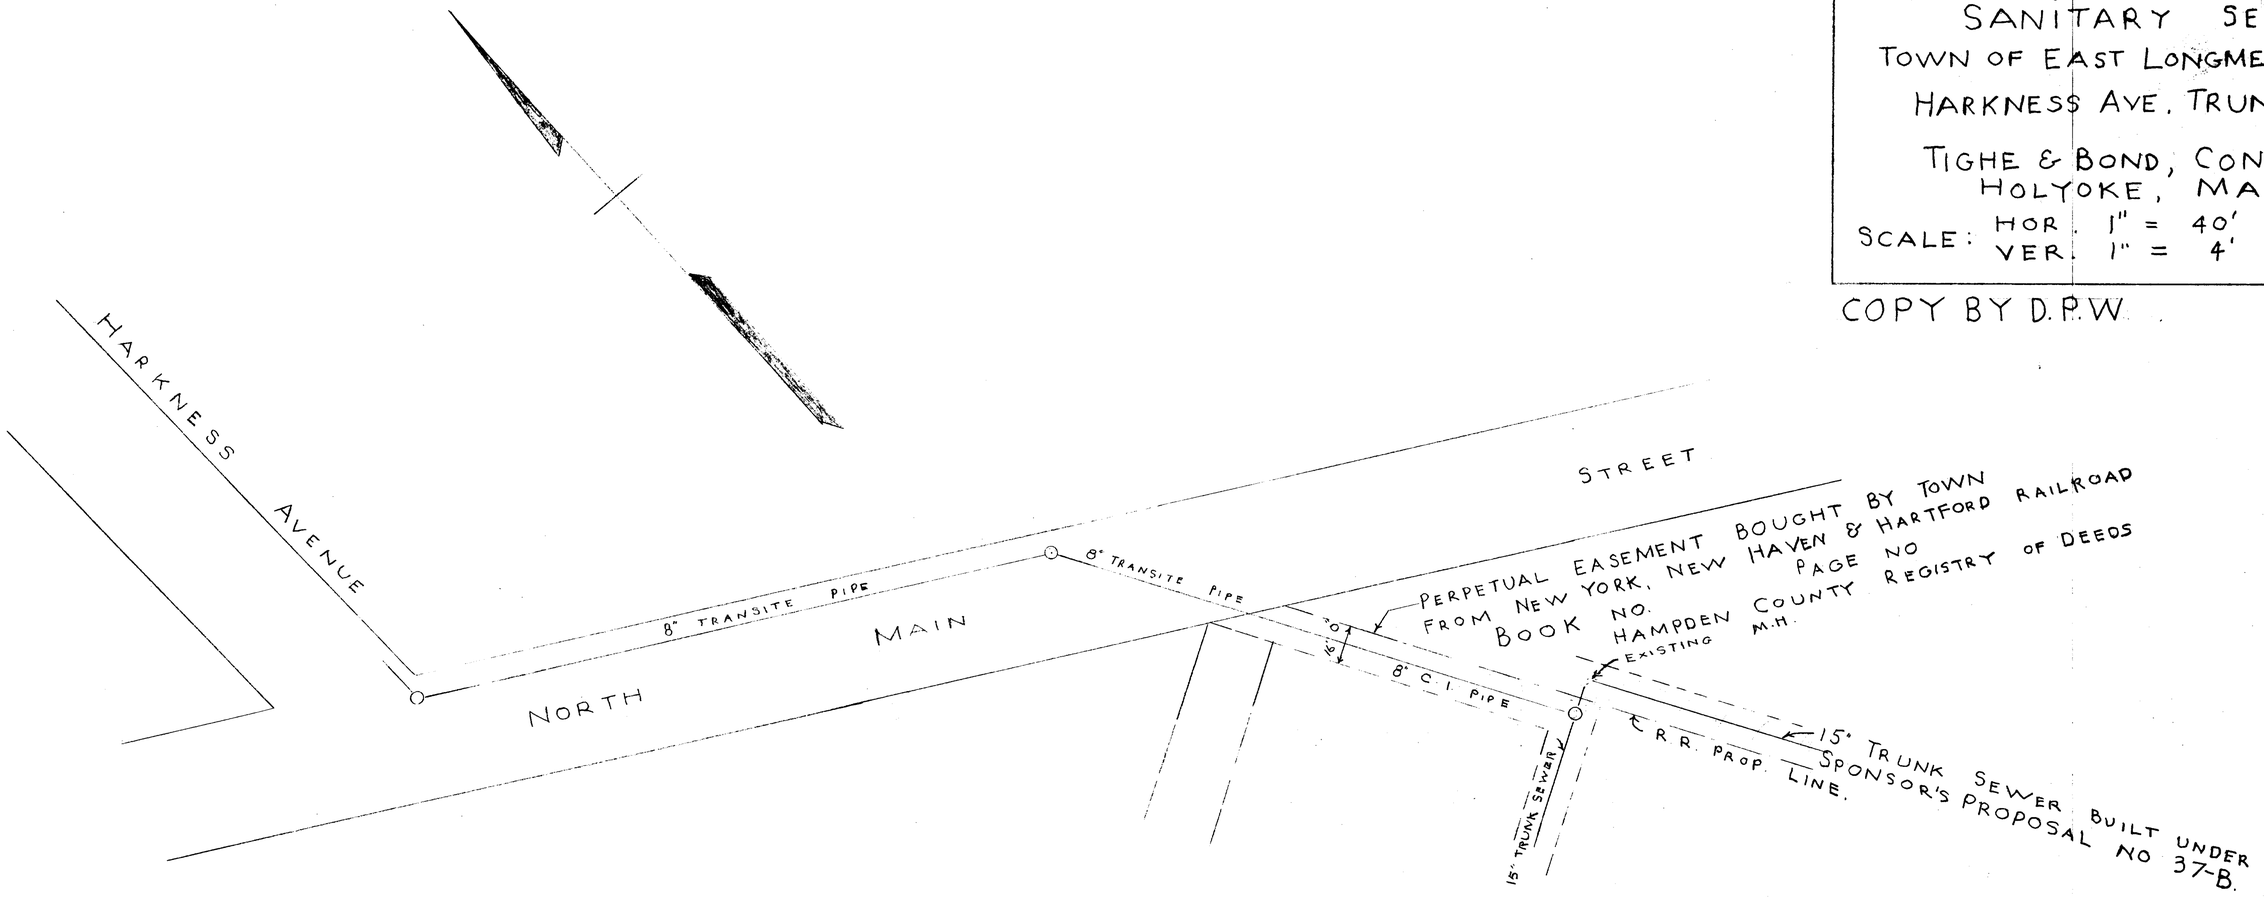

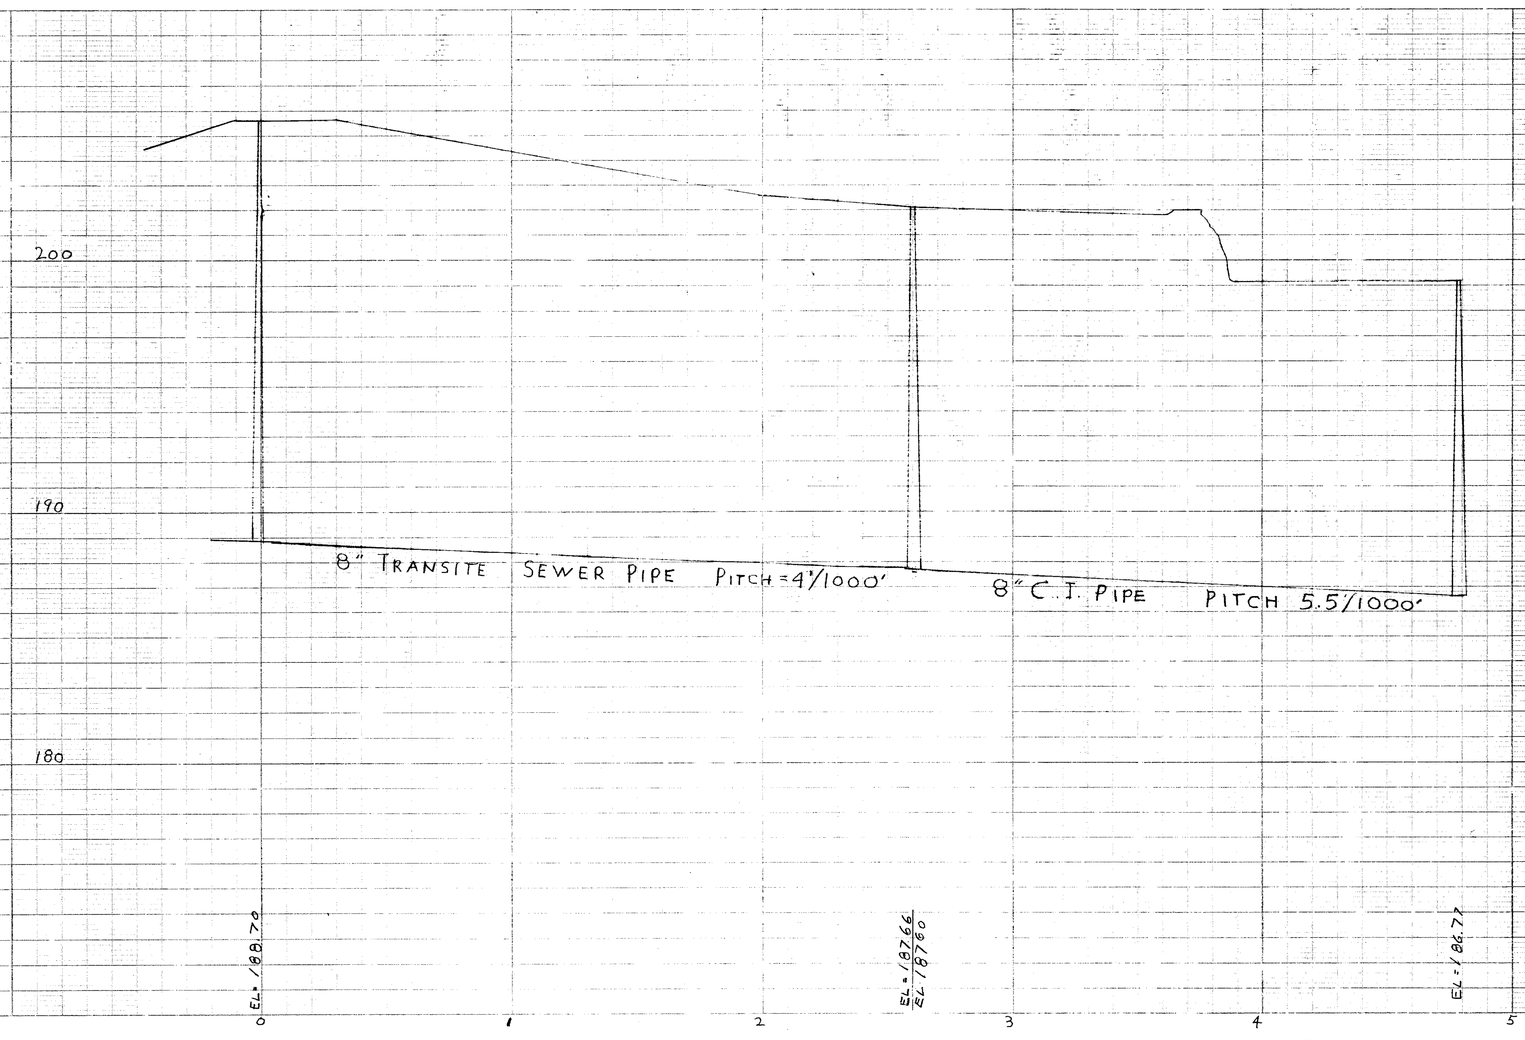

HARKNESS AVE TRUNK SEWER