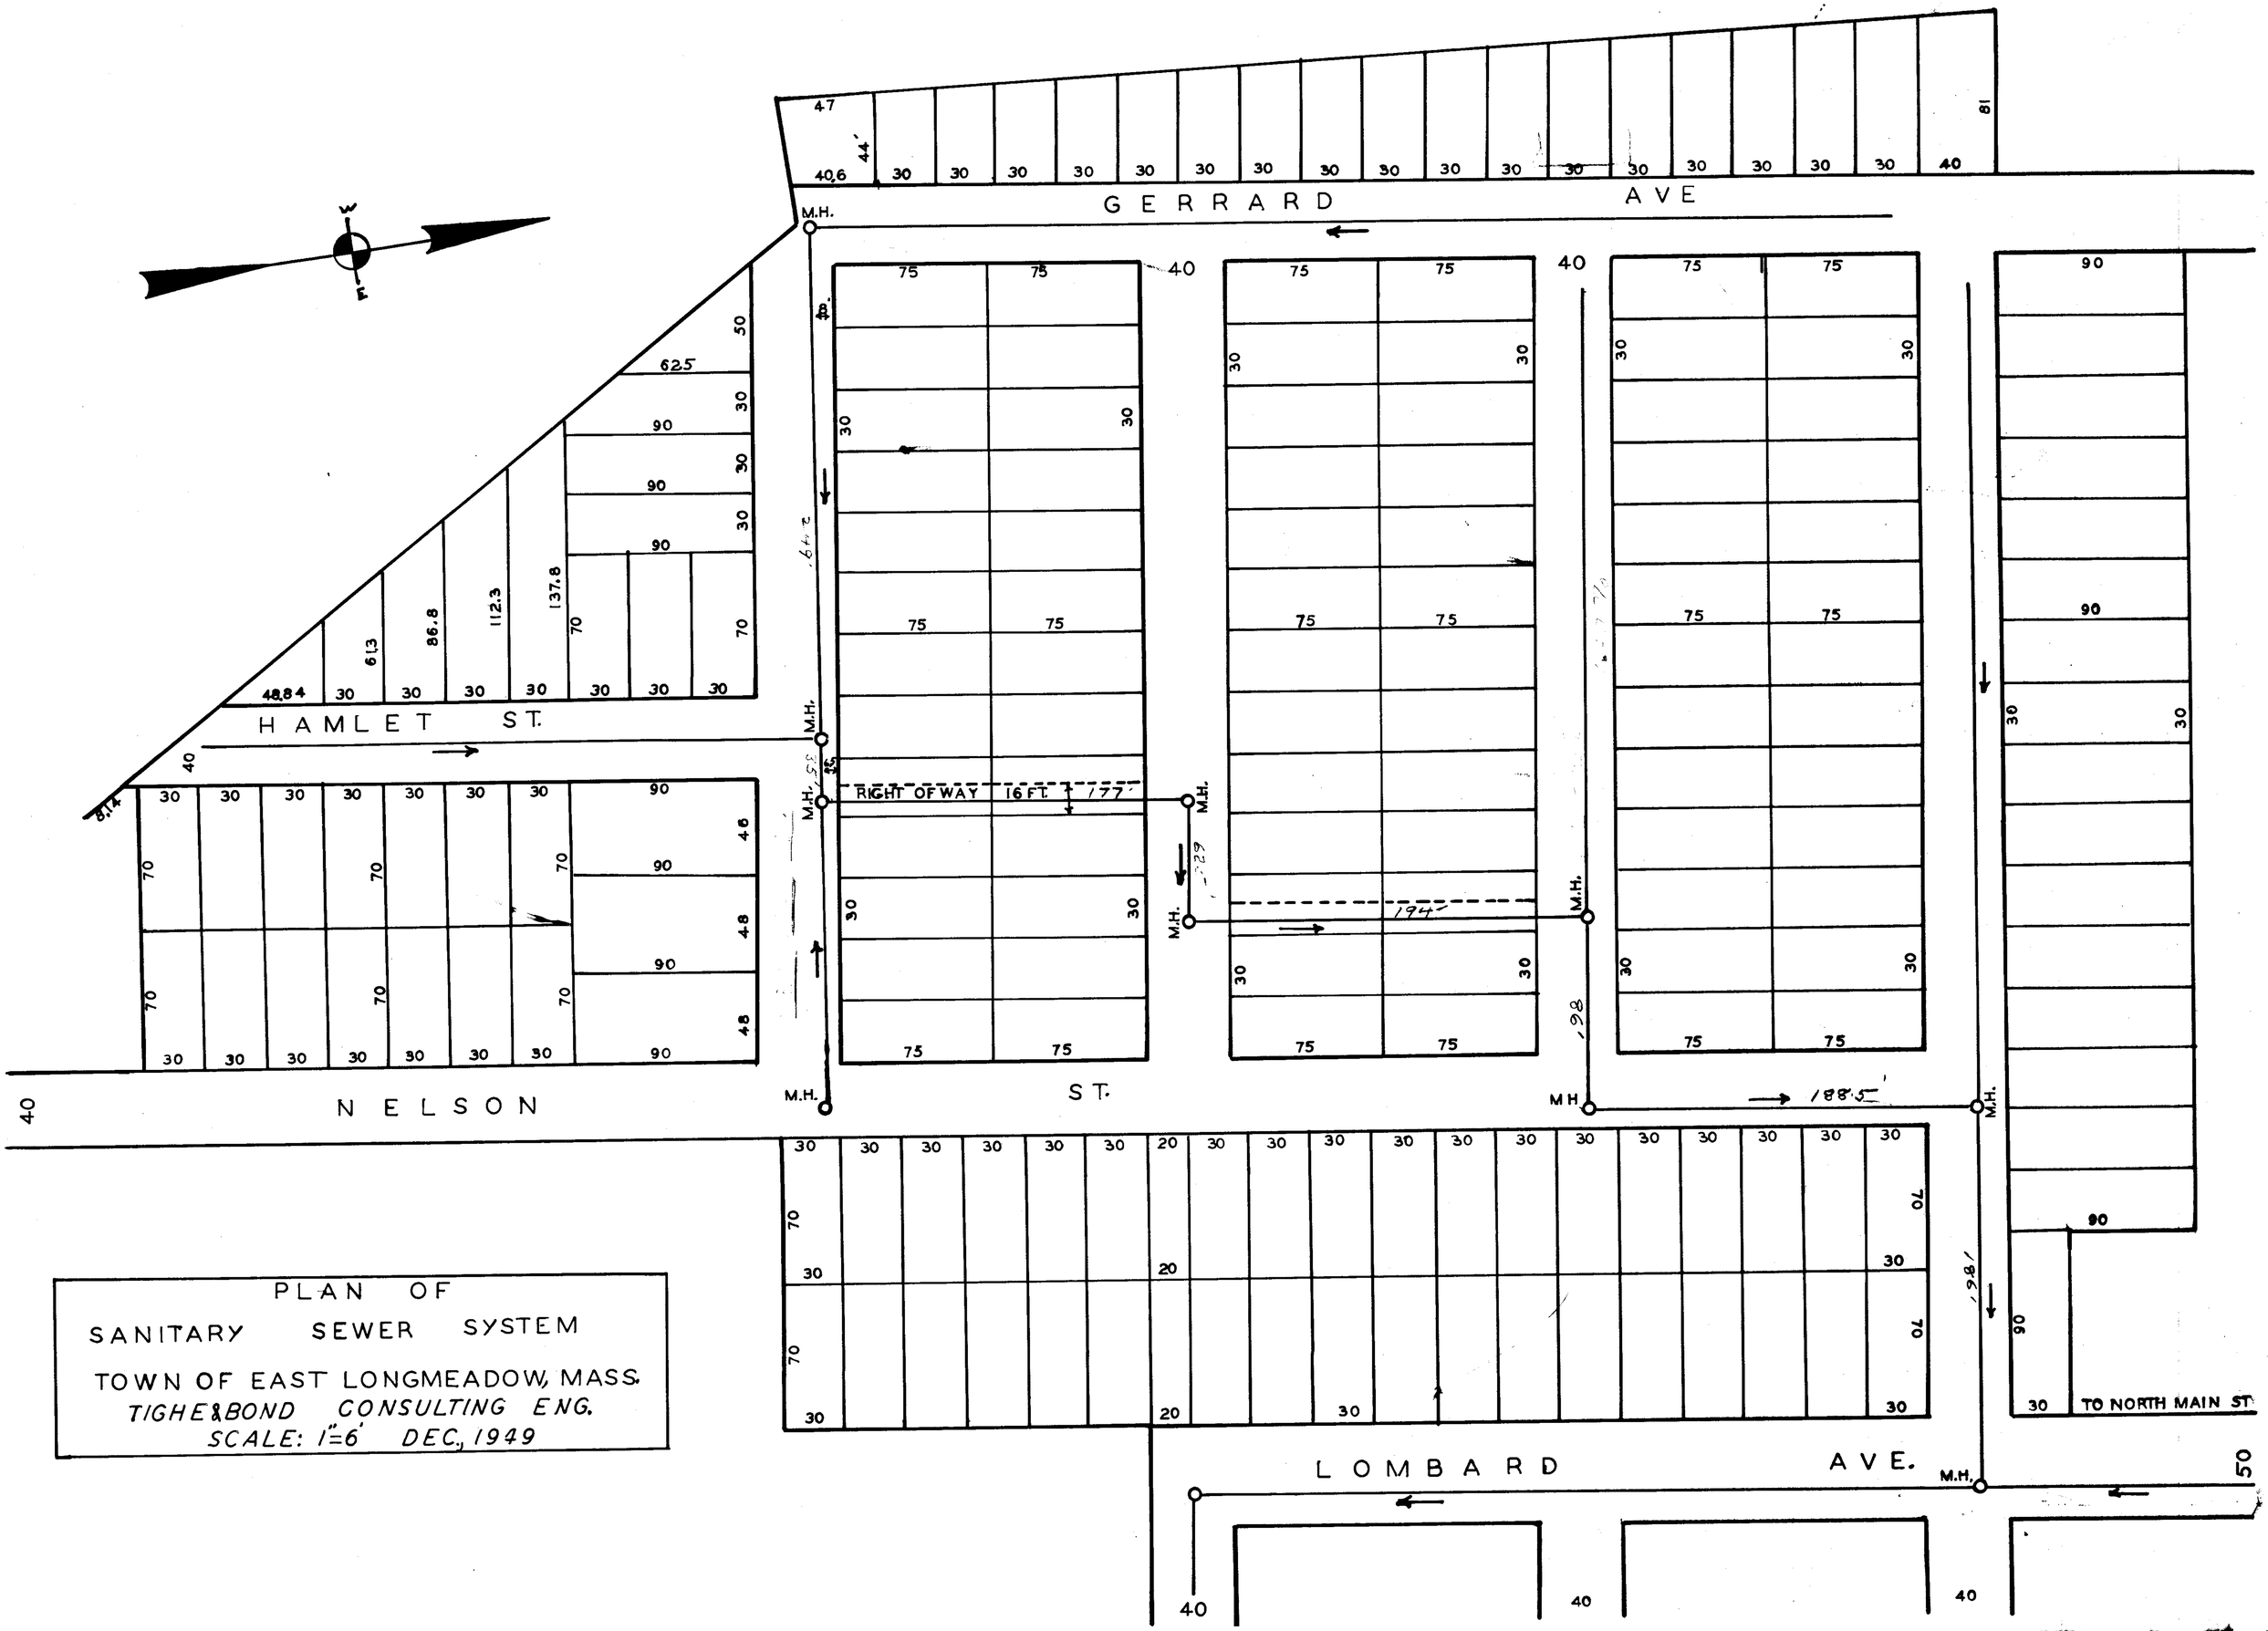
GERRARD AVE
HAMLET ST.
NELSON ST.
LOMBARD AVE.
TO NORTH MAIN ST.
RIGHT OF WAY 16 FT.
M.H.
PLAN OF
SANITARY SEWER SYSTEM
TOWN OF EAST LONGMEADOW, MASS.
TIGHE & BOND CONSULTING ENG.
SCALE: 1"=6' DEC., 1949

SS-123