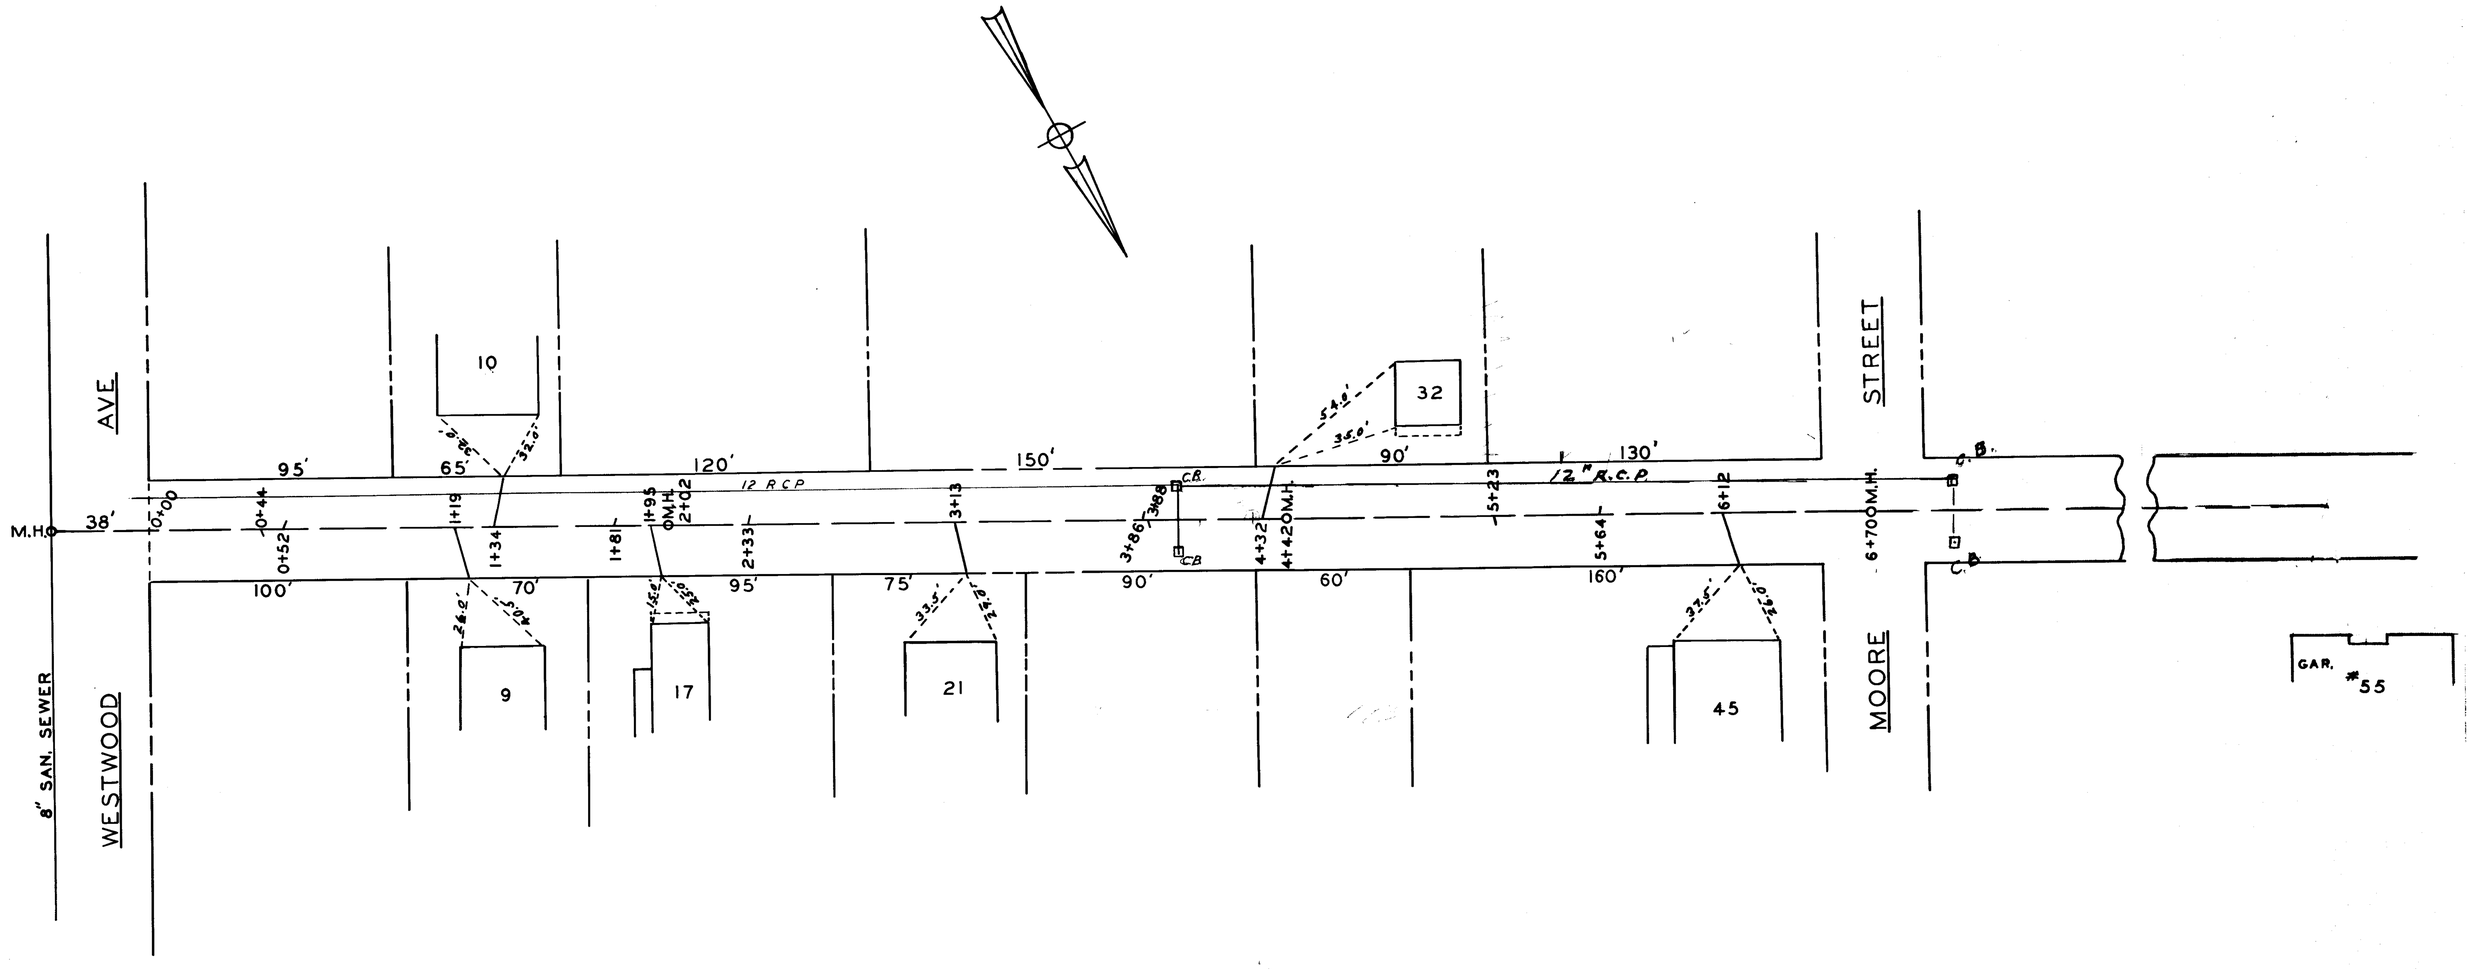

BENCH: TOP OF HYD.-BETWEEN MAPLEHURST & HIGHLANDVIEW- ELEV. 200.00 (ASSUMED)

FRONT COR. OF BOTTOM STEP HOUSE #21 ——— ELEV. 204.25

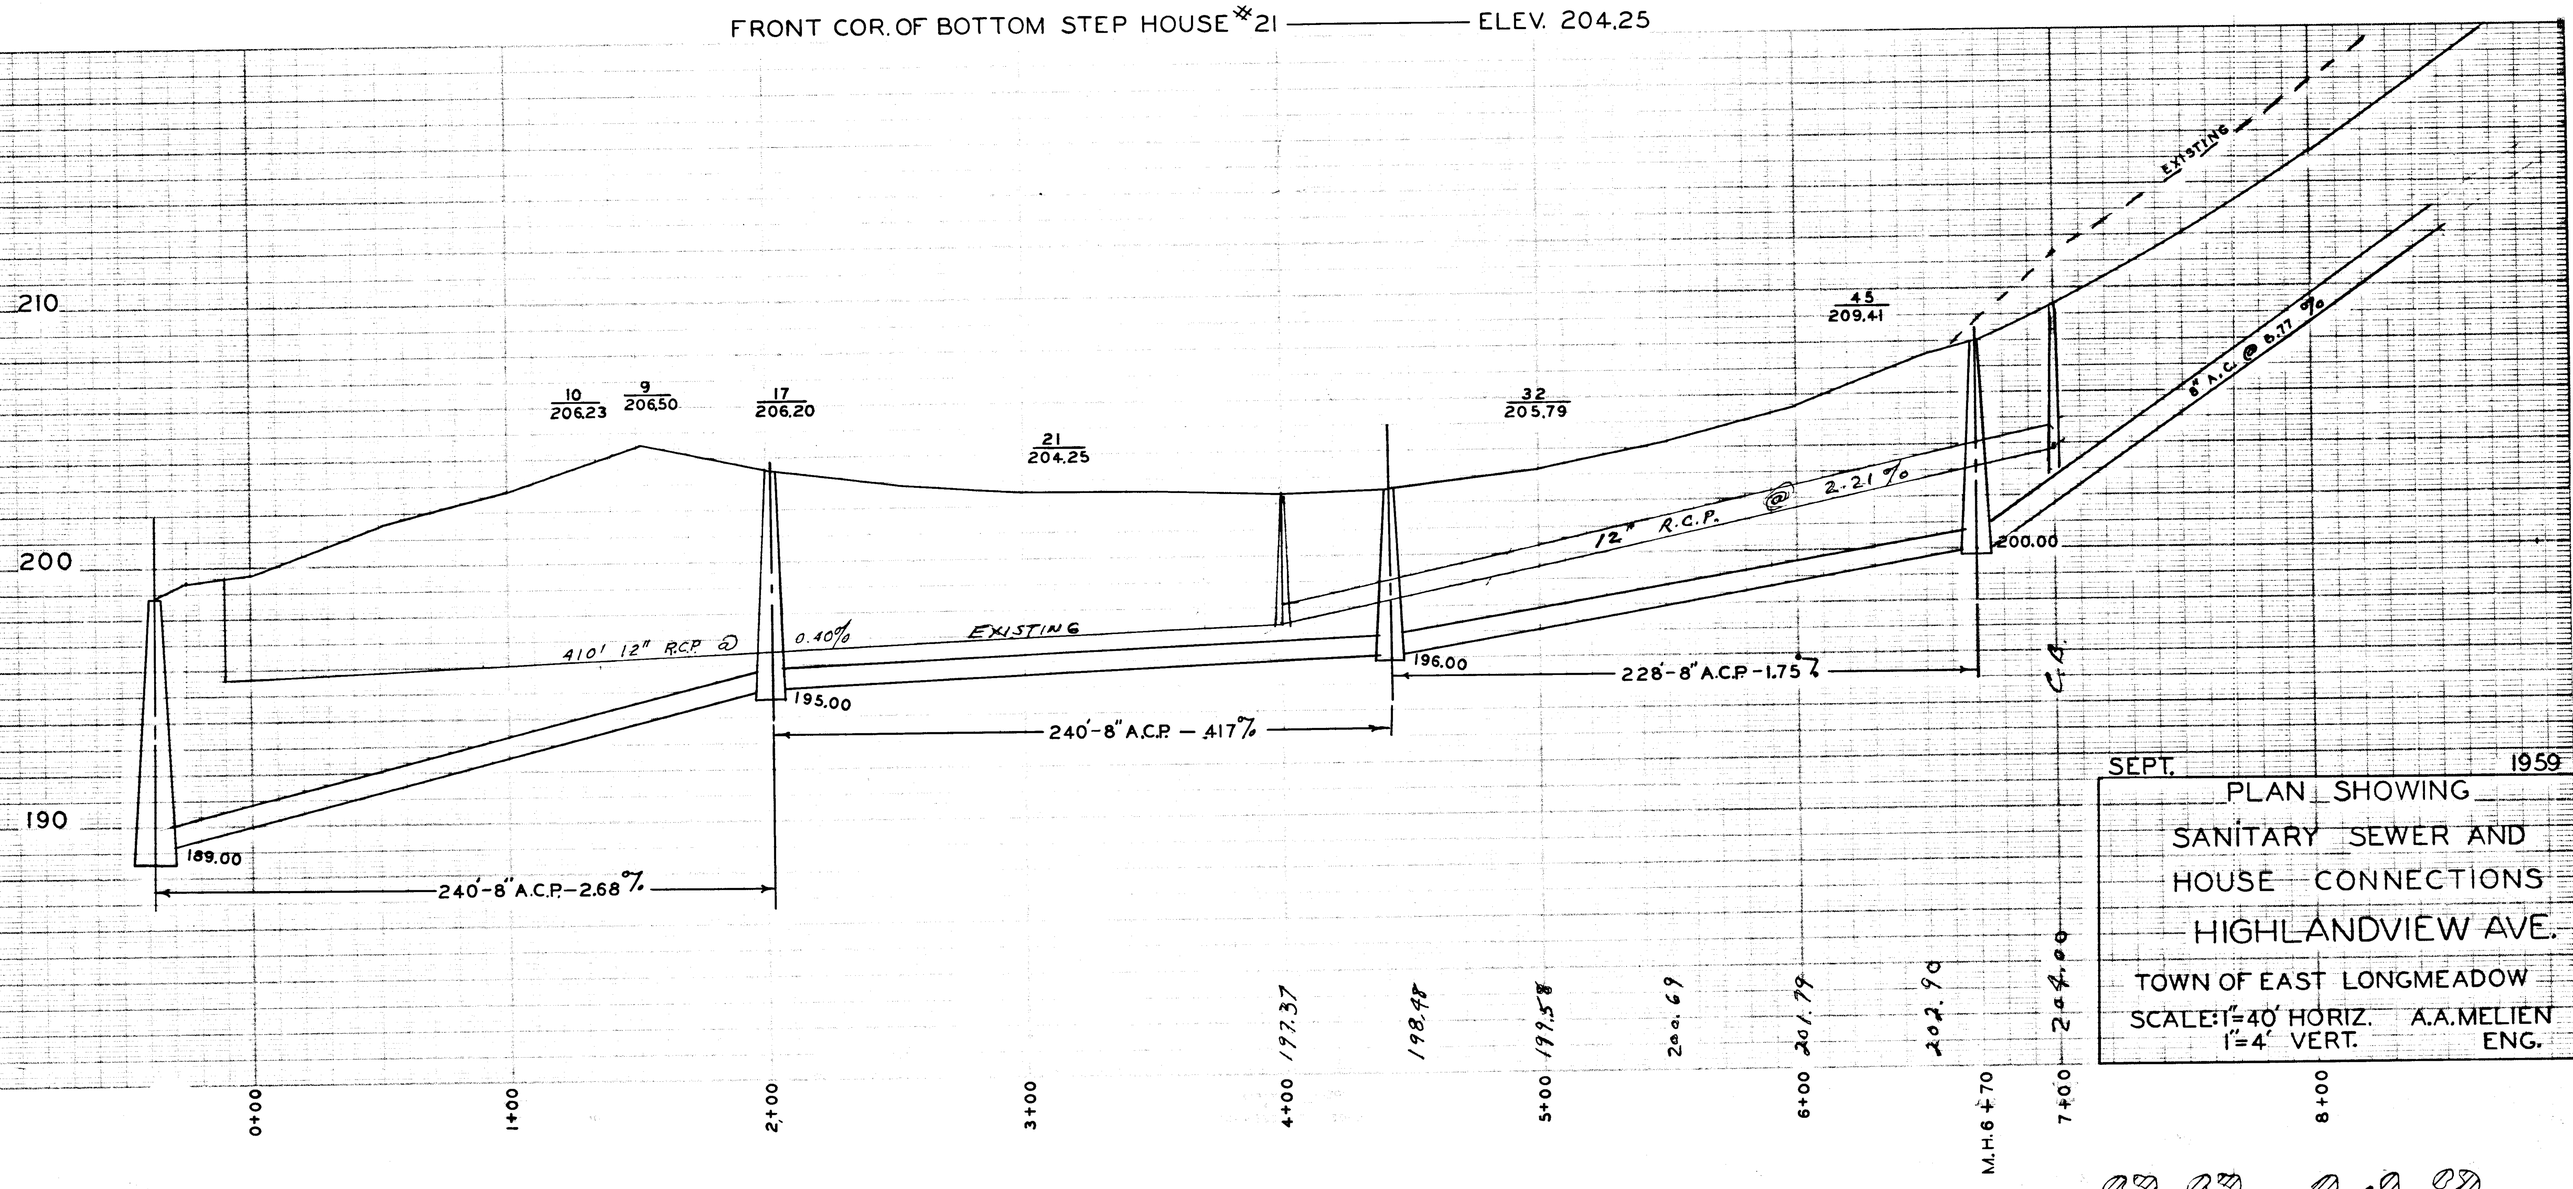

SEPT. 1959

PLAN SHOWING
SANITARY SEWER AND
HOUSE CONNECTIONS
HIGHLANDVIEW AVE.
TOWN OF EAST LONGMEADOW
SCALE: 1"=40' HORIZ. 1"=4' VERT.
A.A. MELIEN ENG.

SS-142