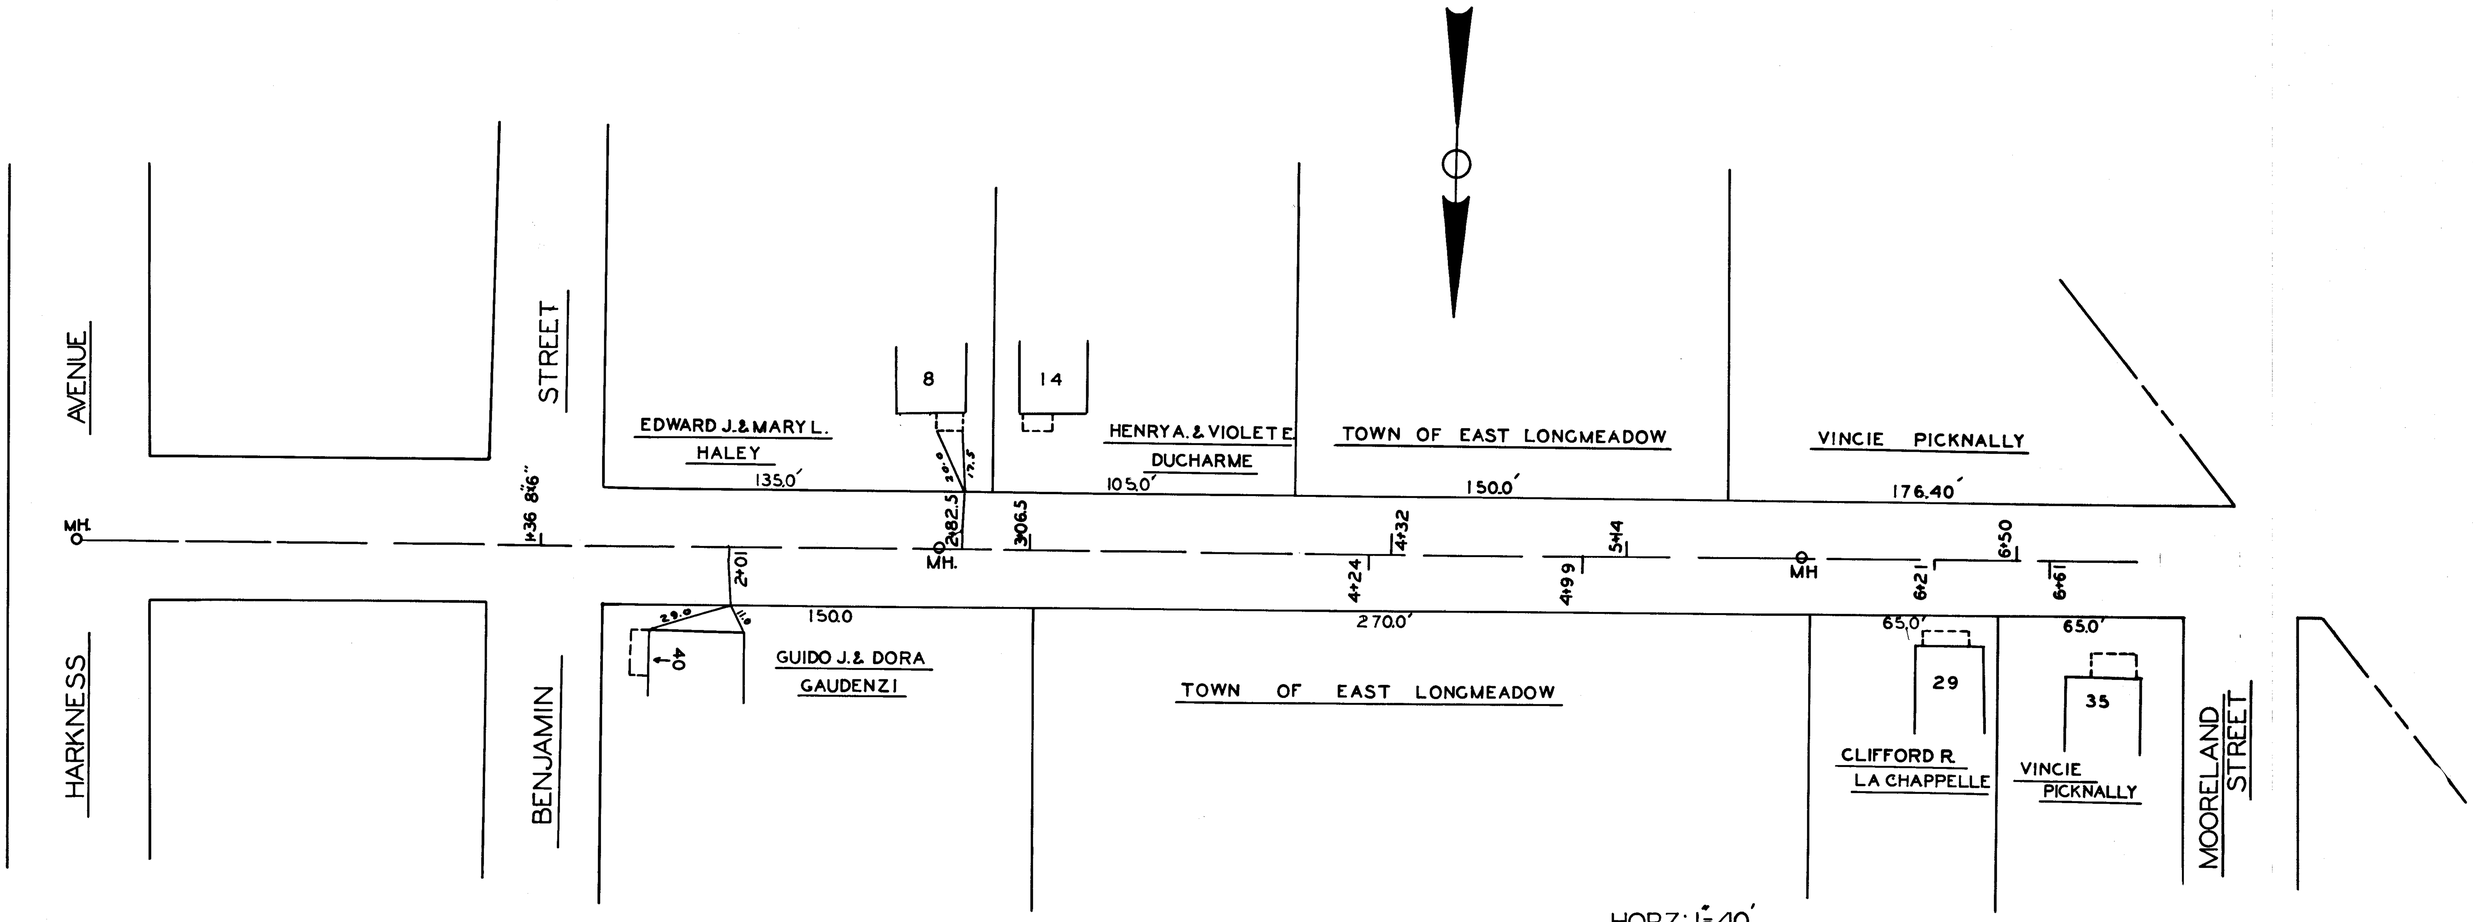


MELVIN AVENUE SANITARY SEWER SCALE: HORZ: 1"=40' VERT: 1"=4'

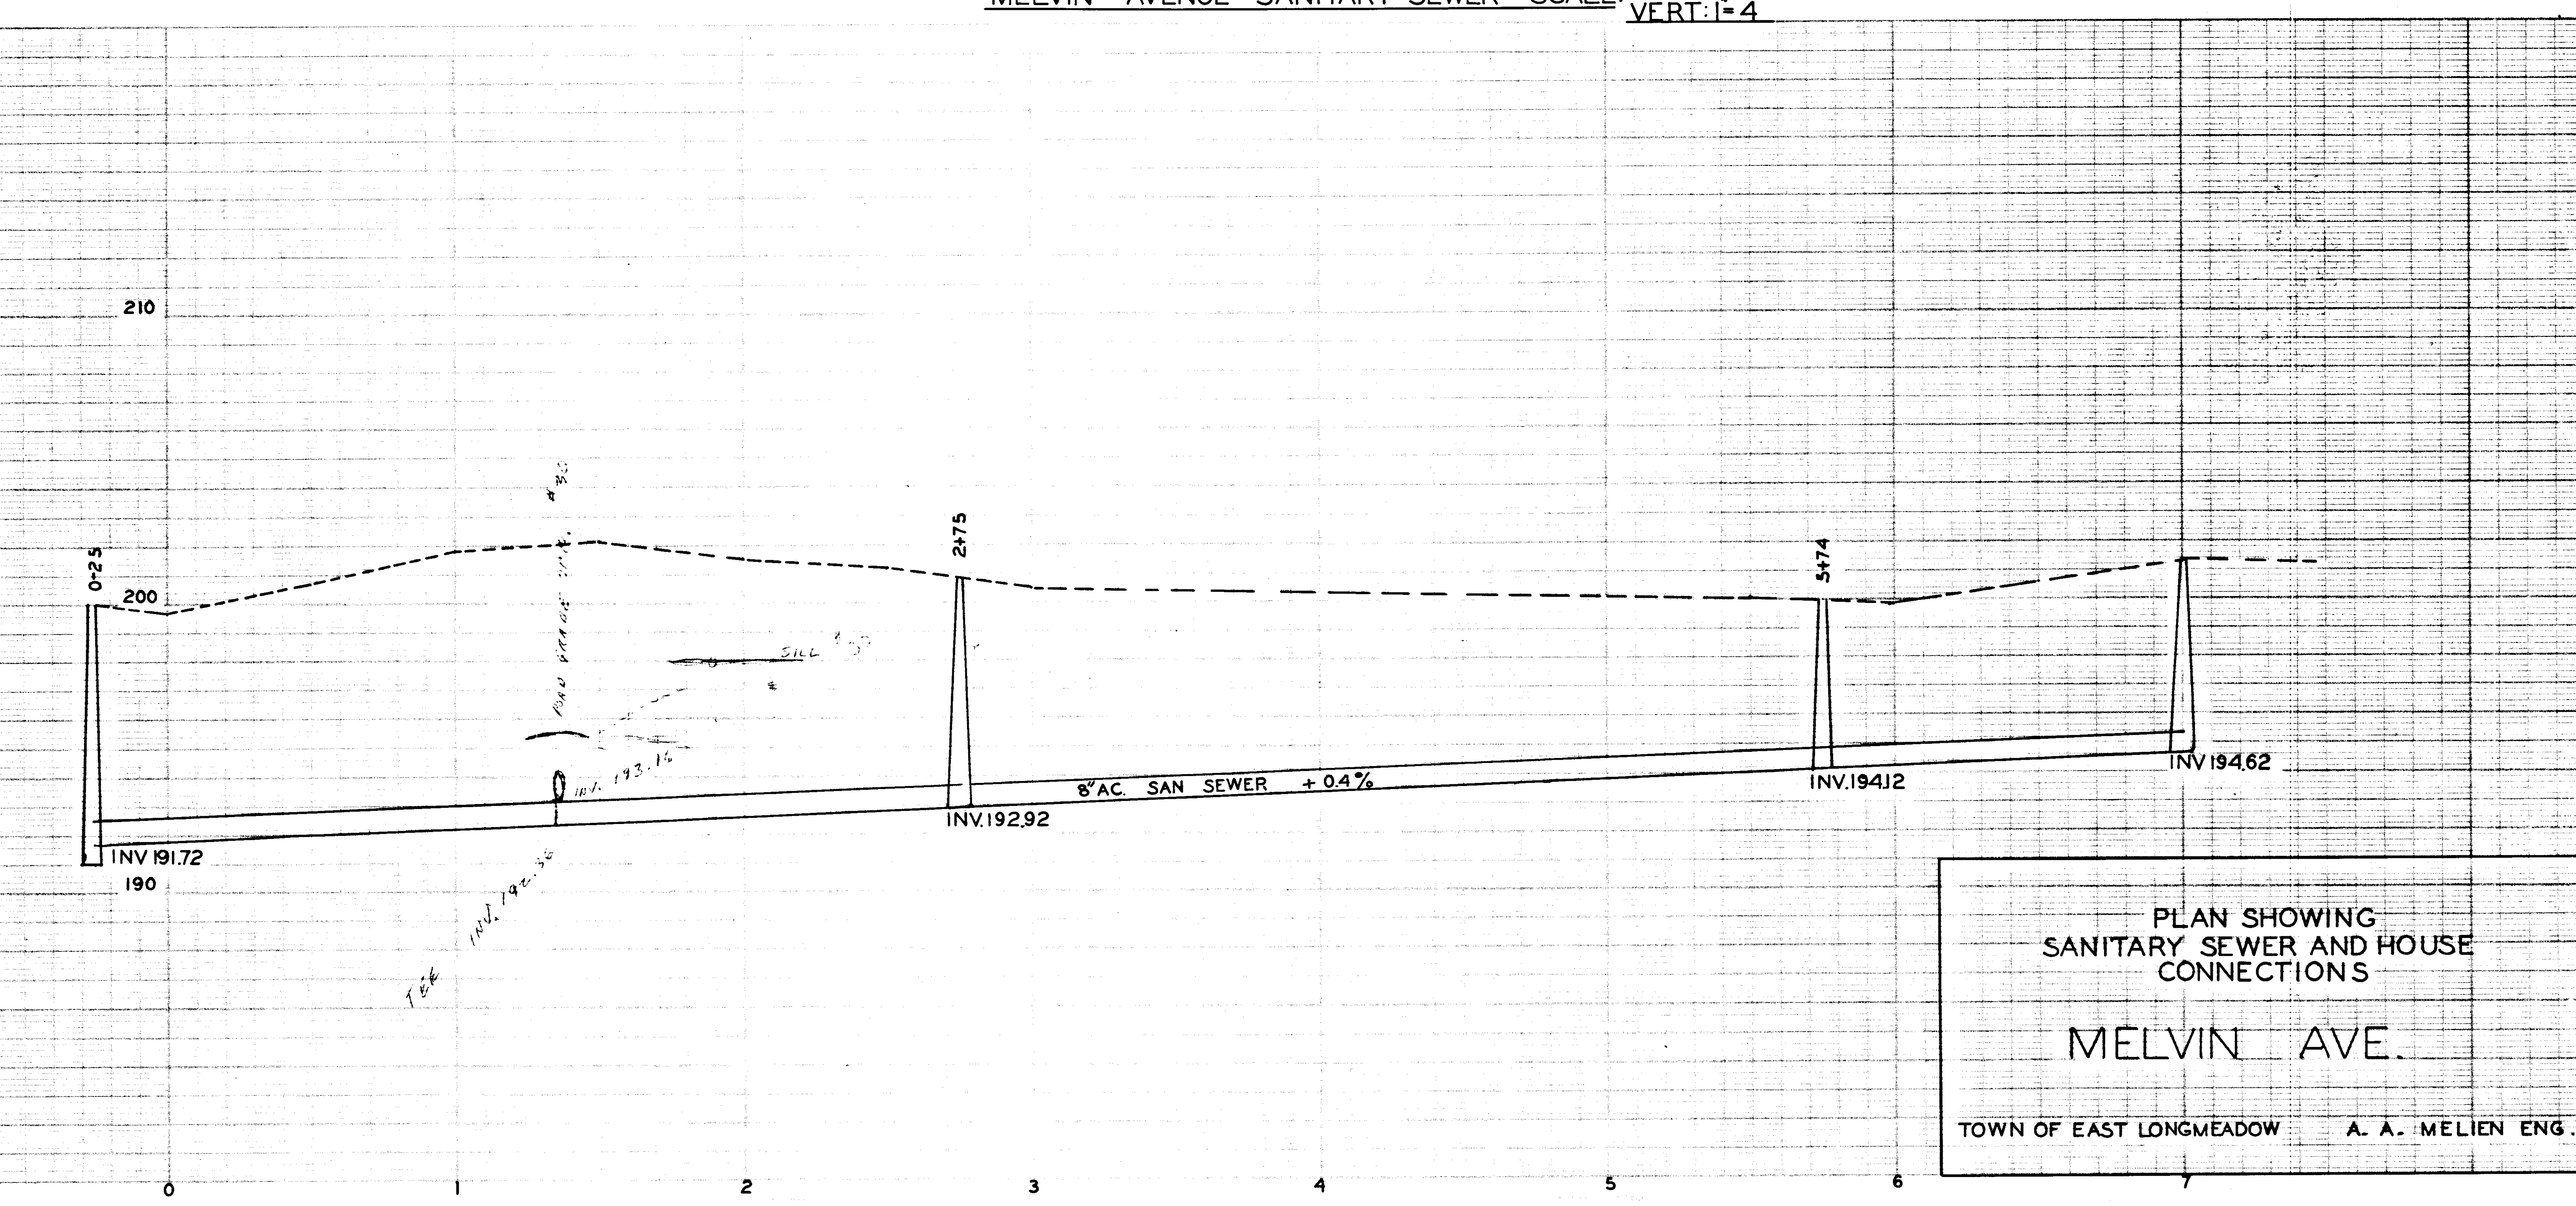


PLAN SHOWING
SANITARY SEWER AND HOUSE CONNECTIONS

MELVIN AVE.

TOWN OF EAST LONGMEADOW A. A. MELIEN ENG.