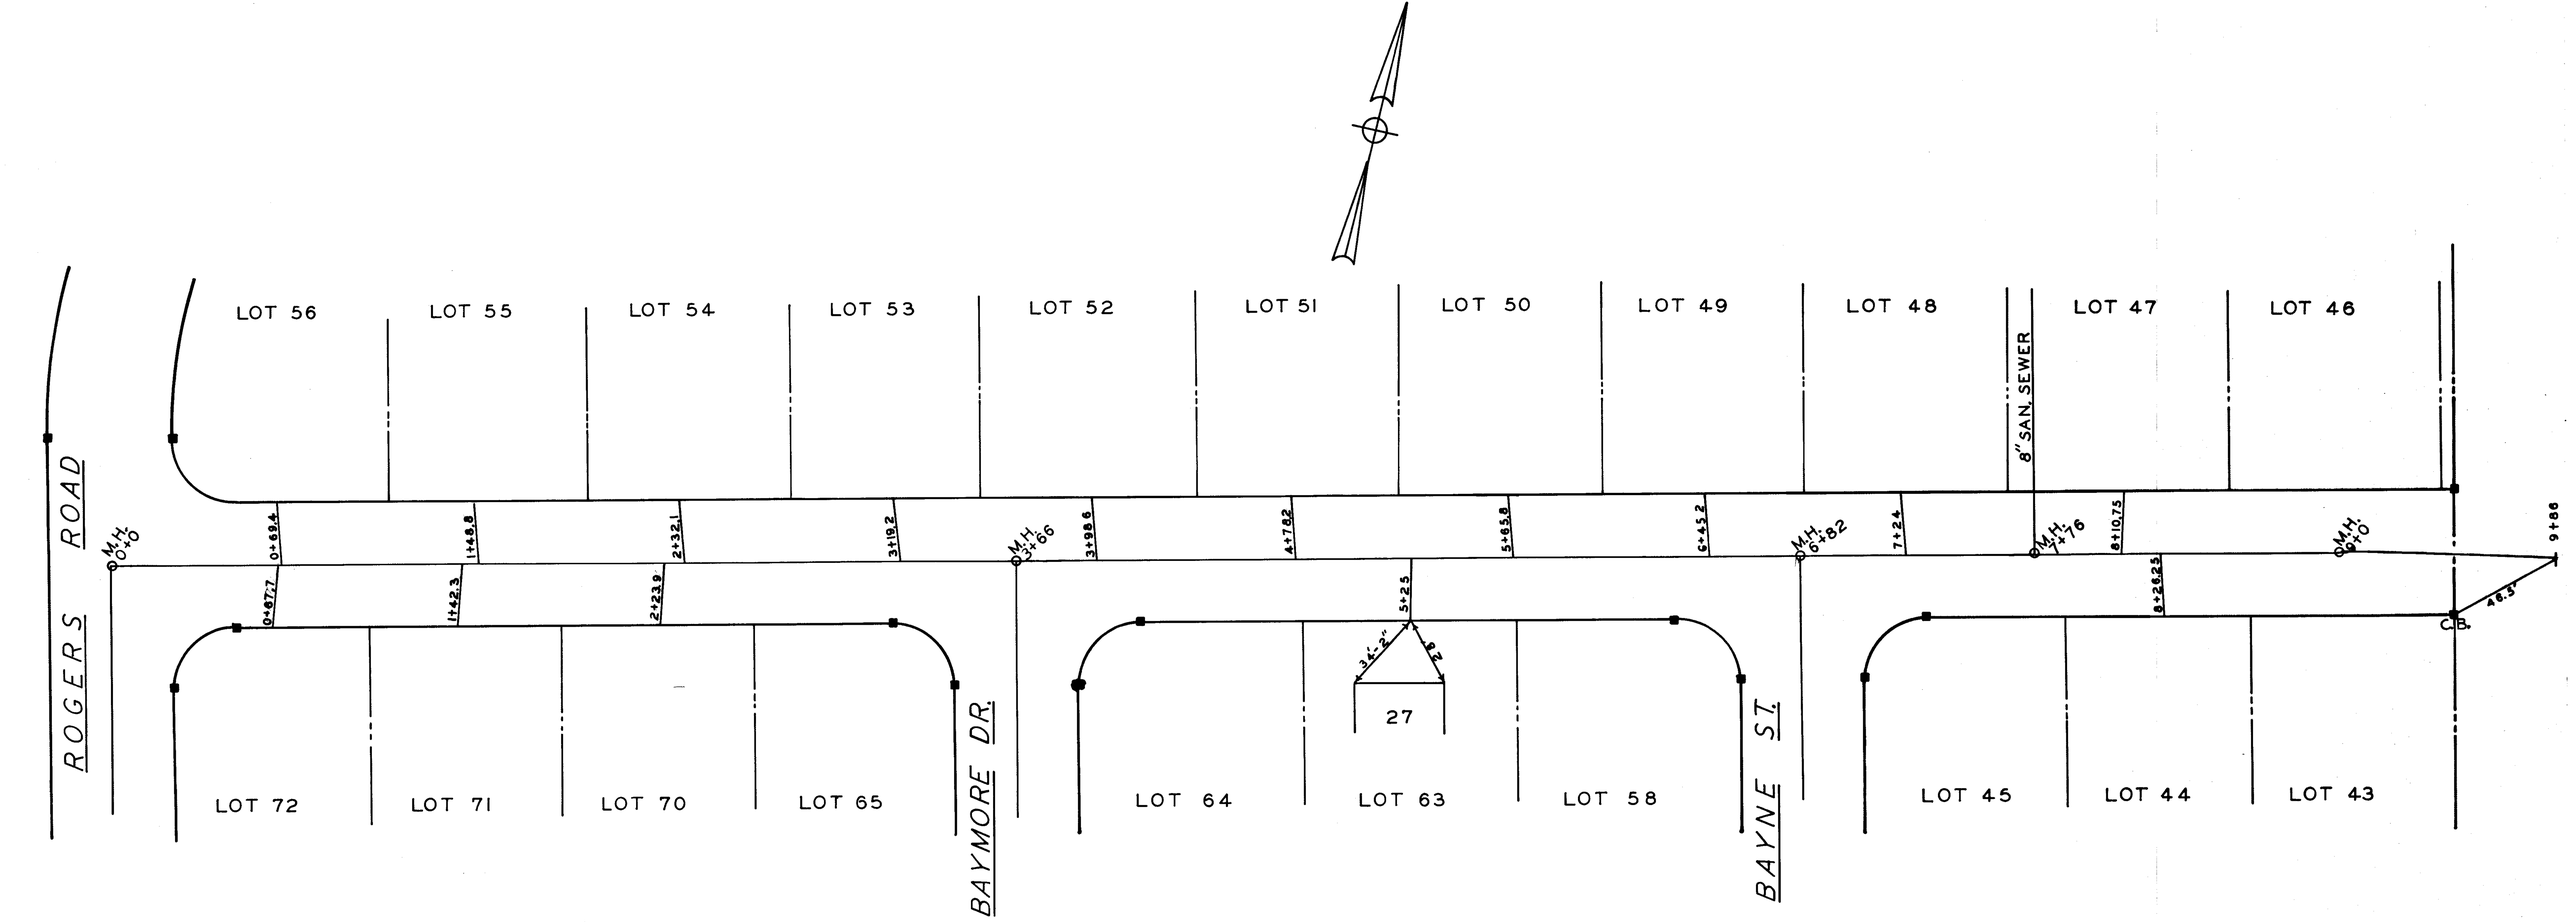

PLAN SHOWING SANITARY SEWER

CEDAR HILL ROAD

DEPT. OF PUBLIC WORKS — A. A. MELIEN, ENG.

TOWN OF EAST LONGMEADOW, MASSACHUSETTS

SCALE: 1"=40' HORIZ., 1"=4' VERT. — FEB., 1964

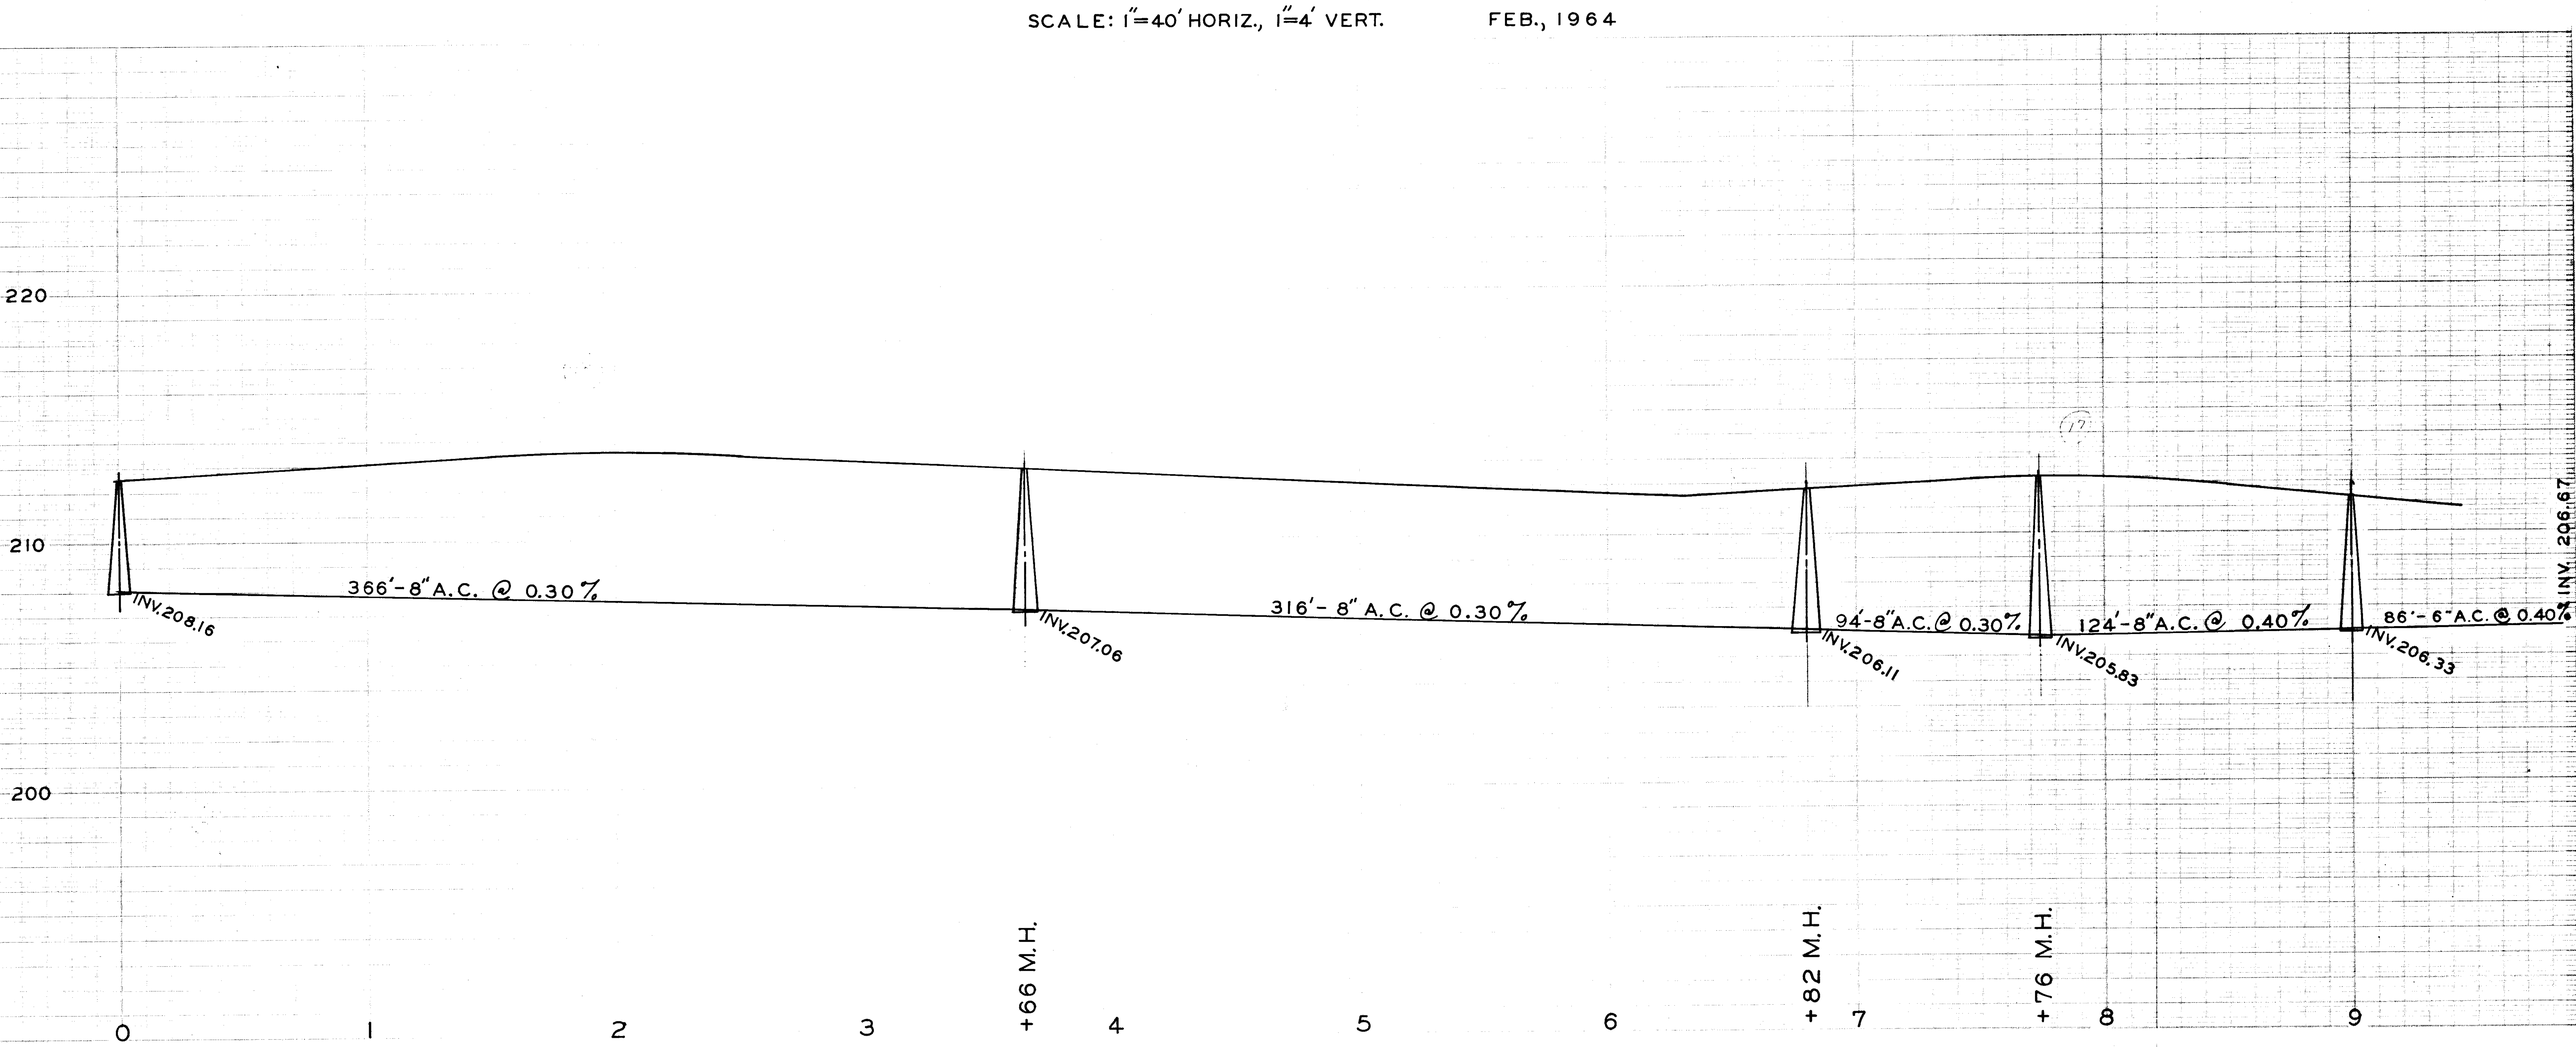

S.S.– 155