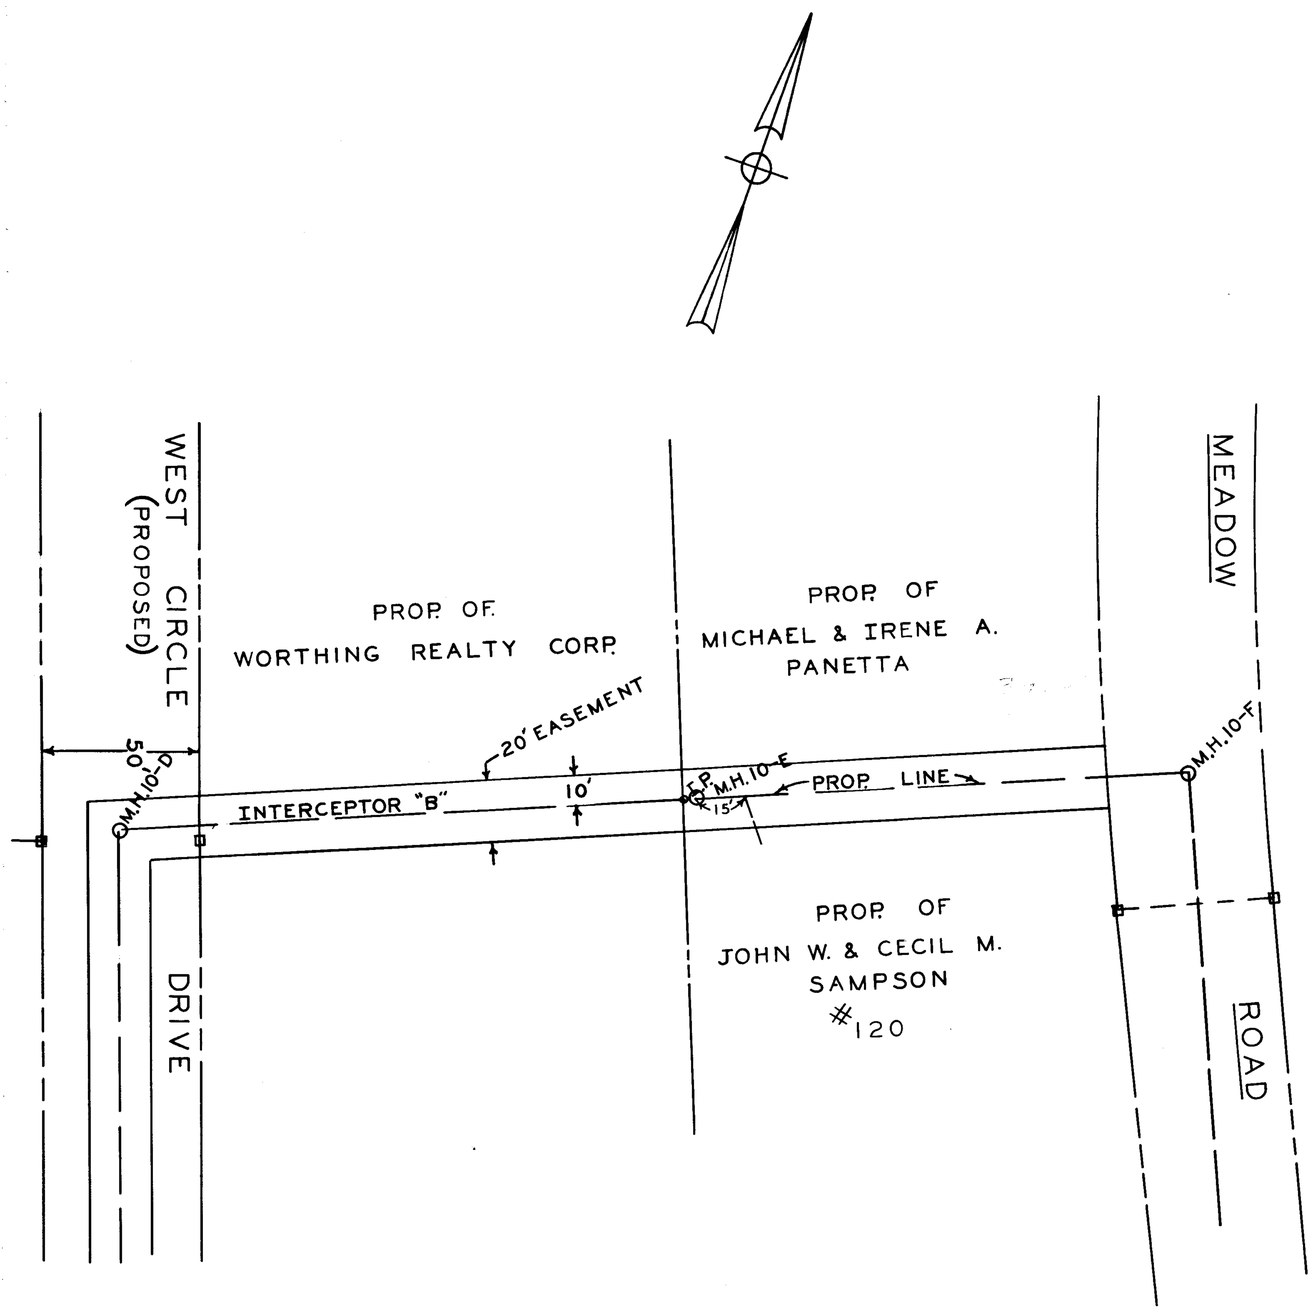

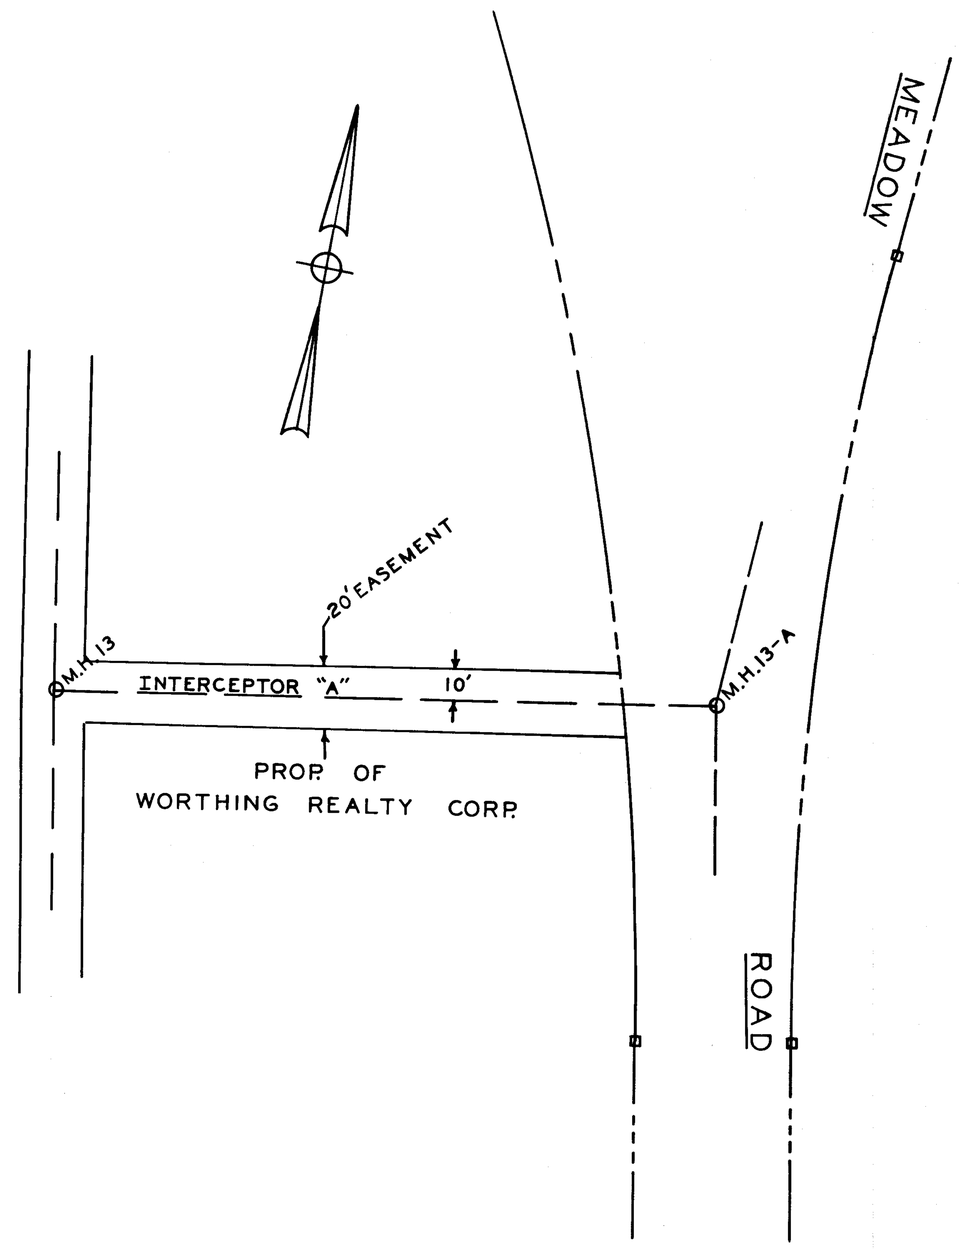

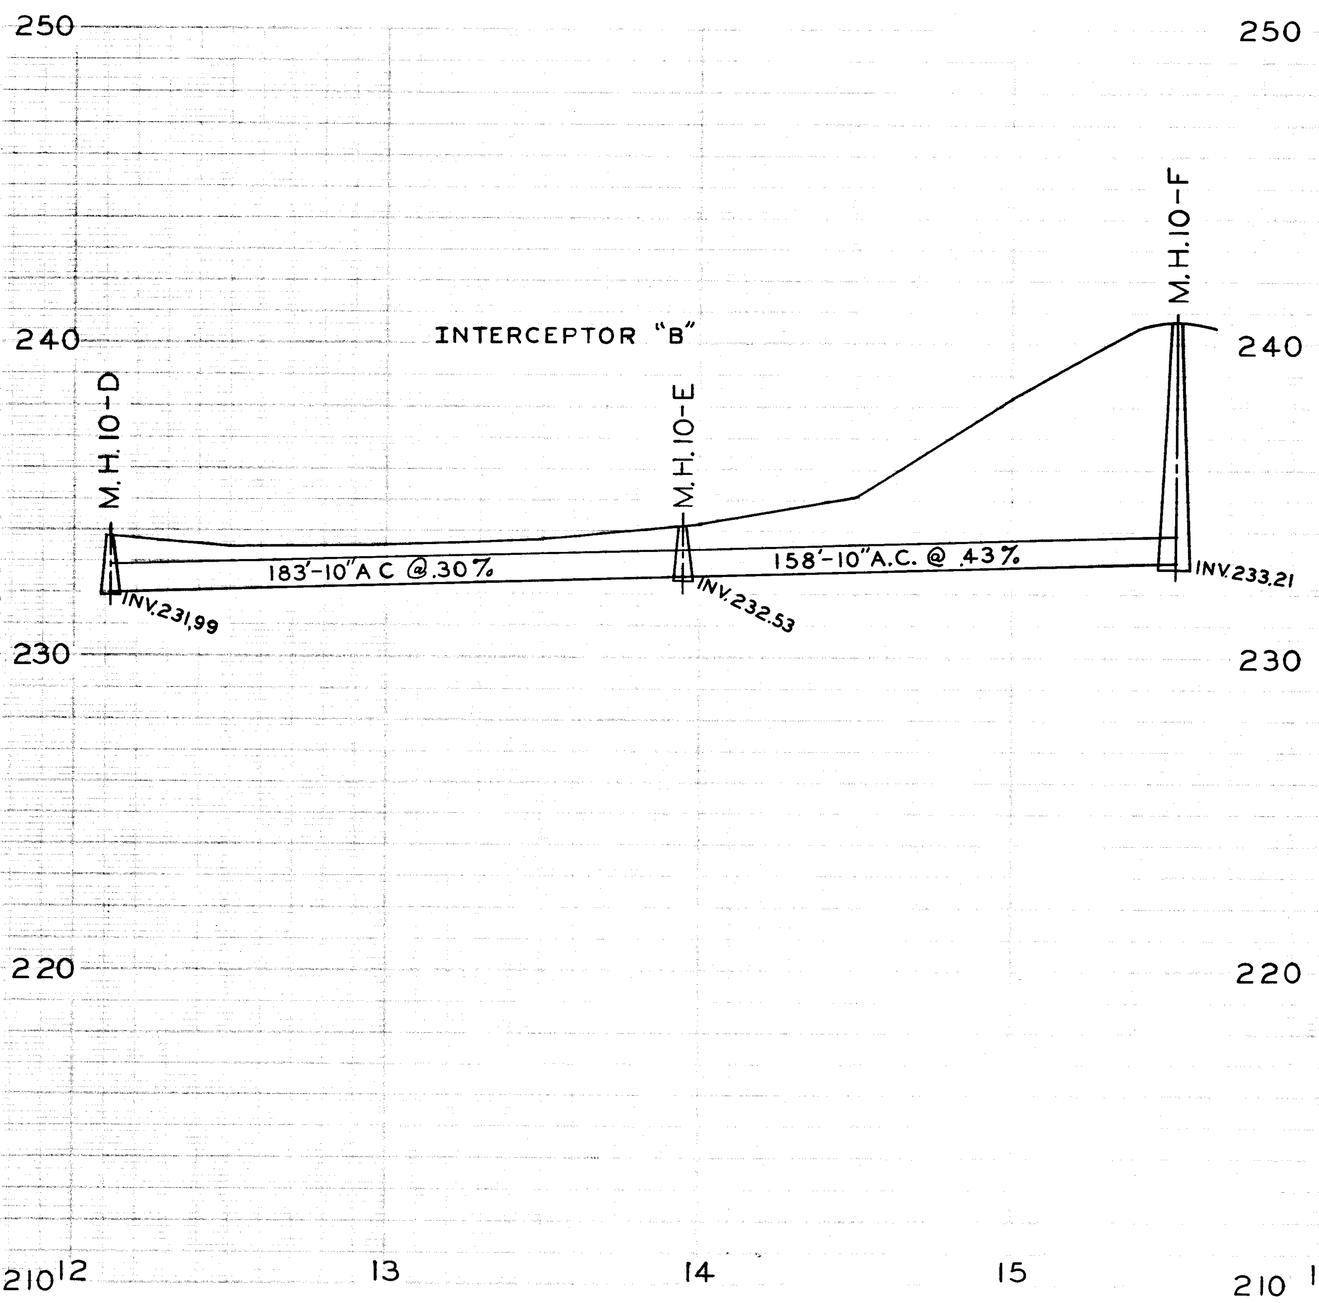

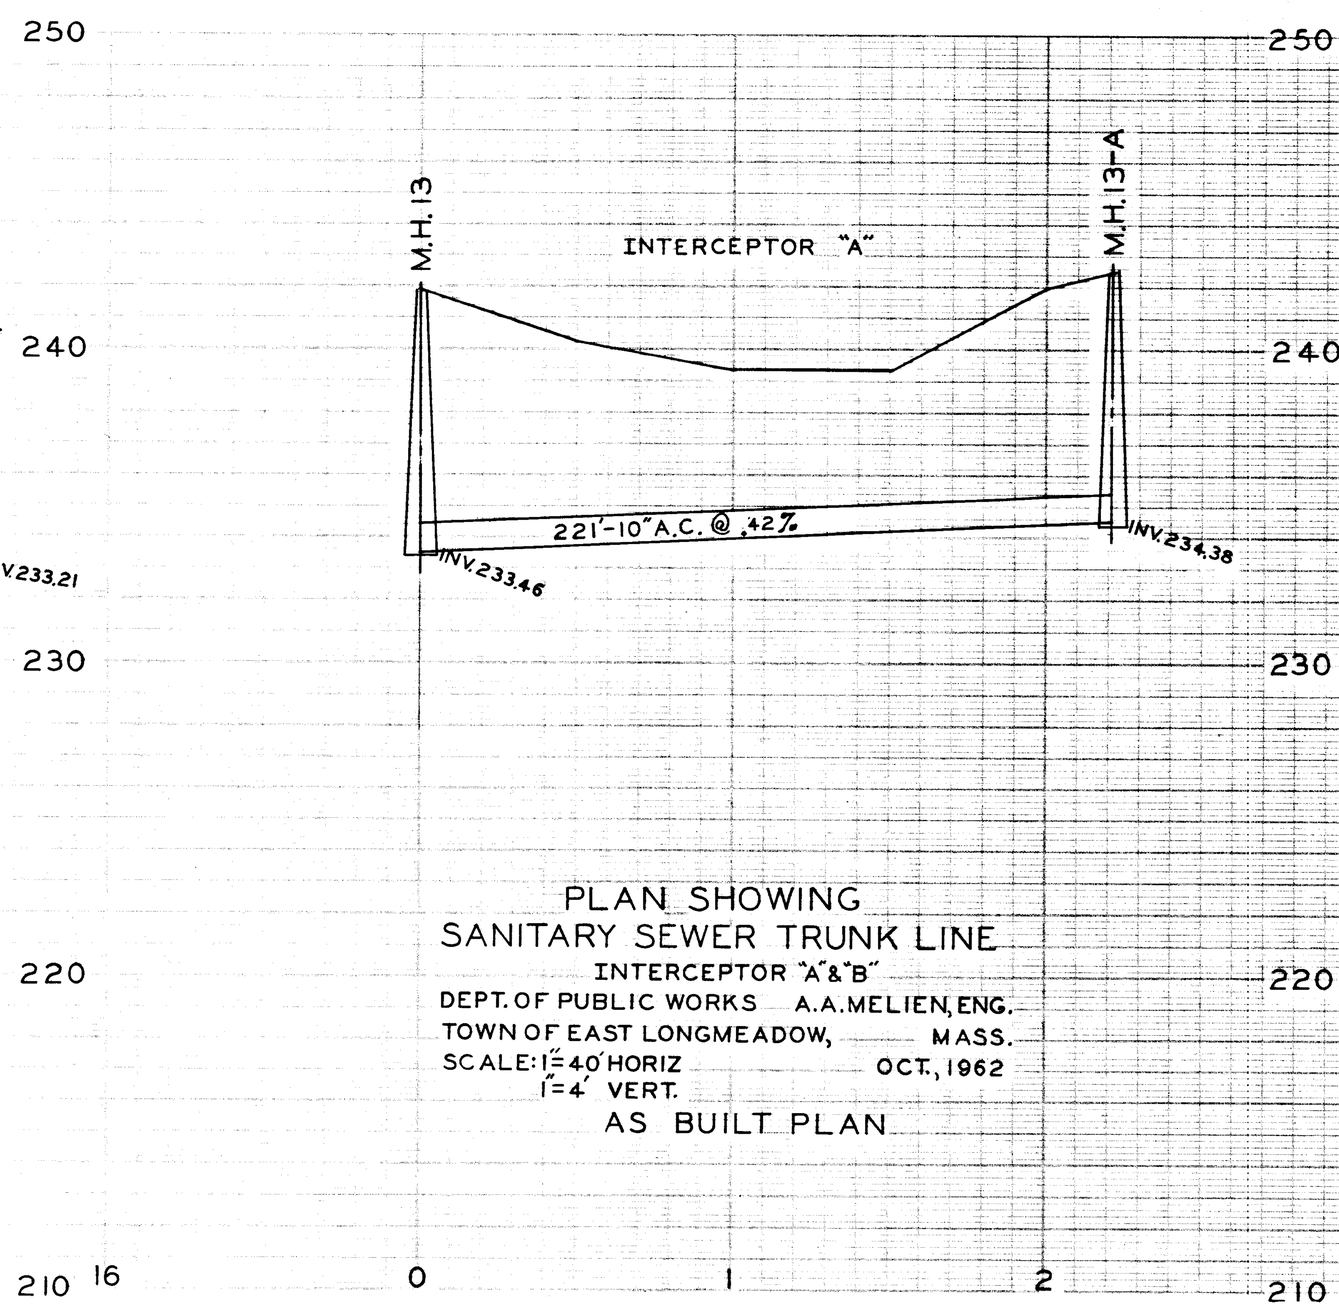

PLAN SHOWING
SANITARY SEWER TRUNK LINE
INTERCEPTOR "A" & "B"
DEPT. OF PUBLIC WORKS A.A. MELIEN, ENG.
TOWN OF EAST LONGMEADOW, MASS.
SCALE: 1" = 40' HORIZ OCT., 1962
1" = 4' VERT.
AS BUILT PLAN

S.S. 161