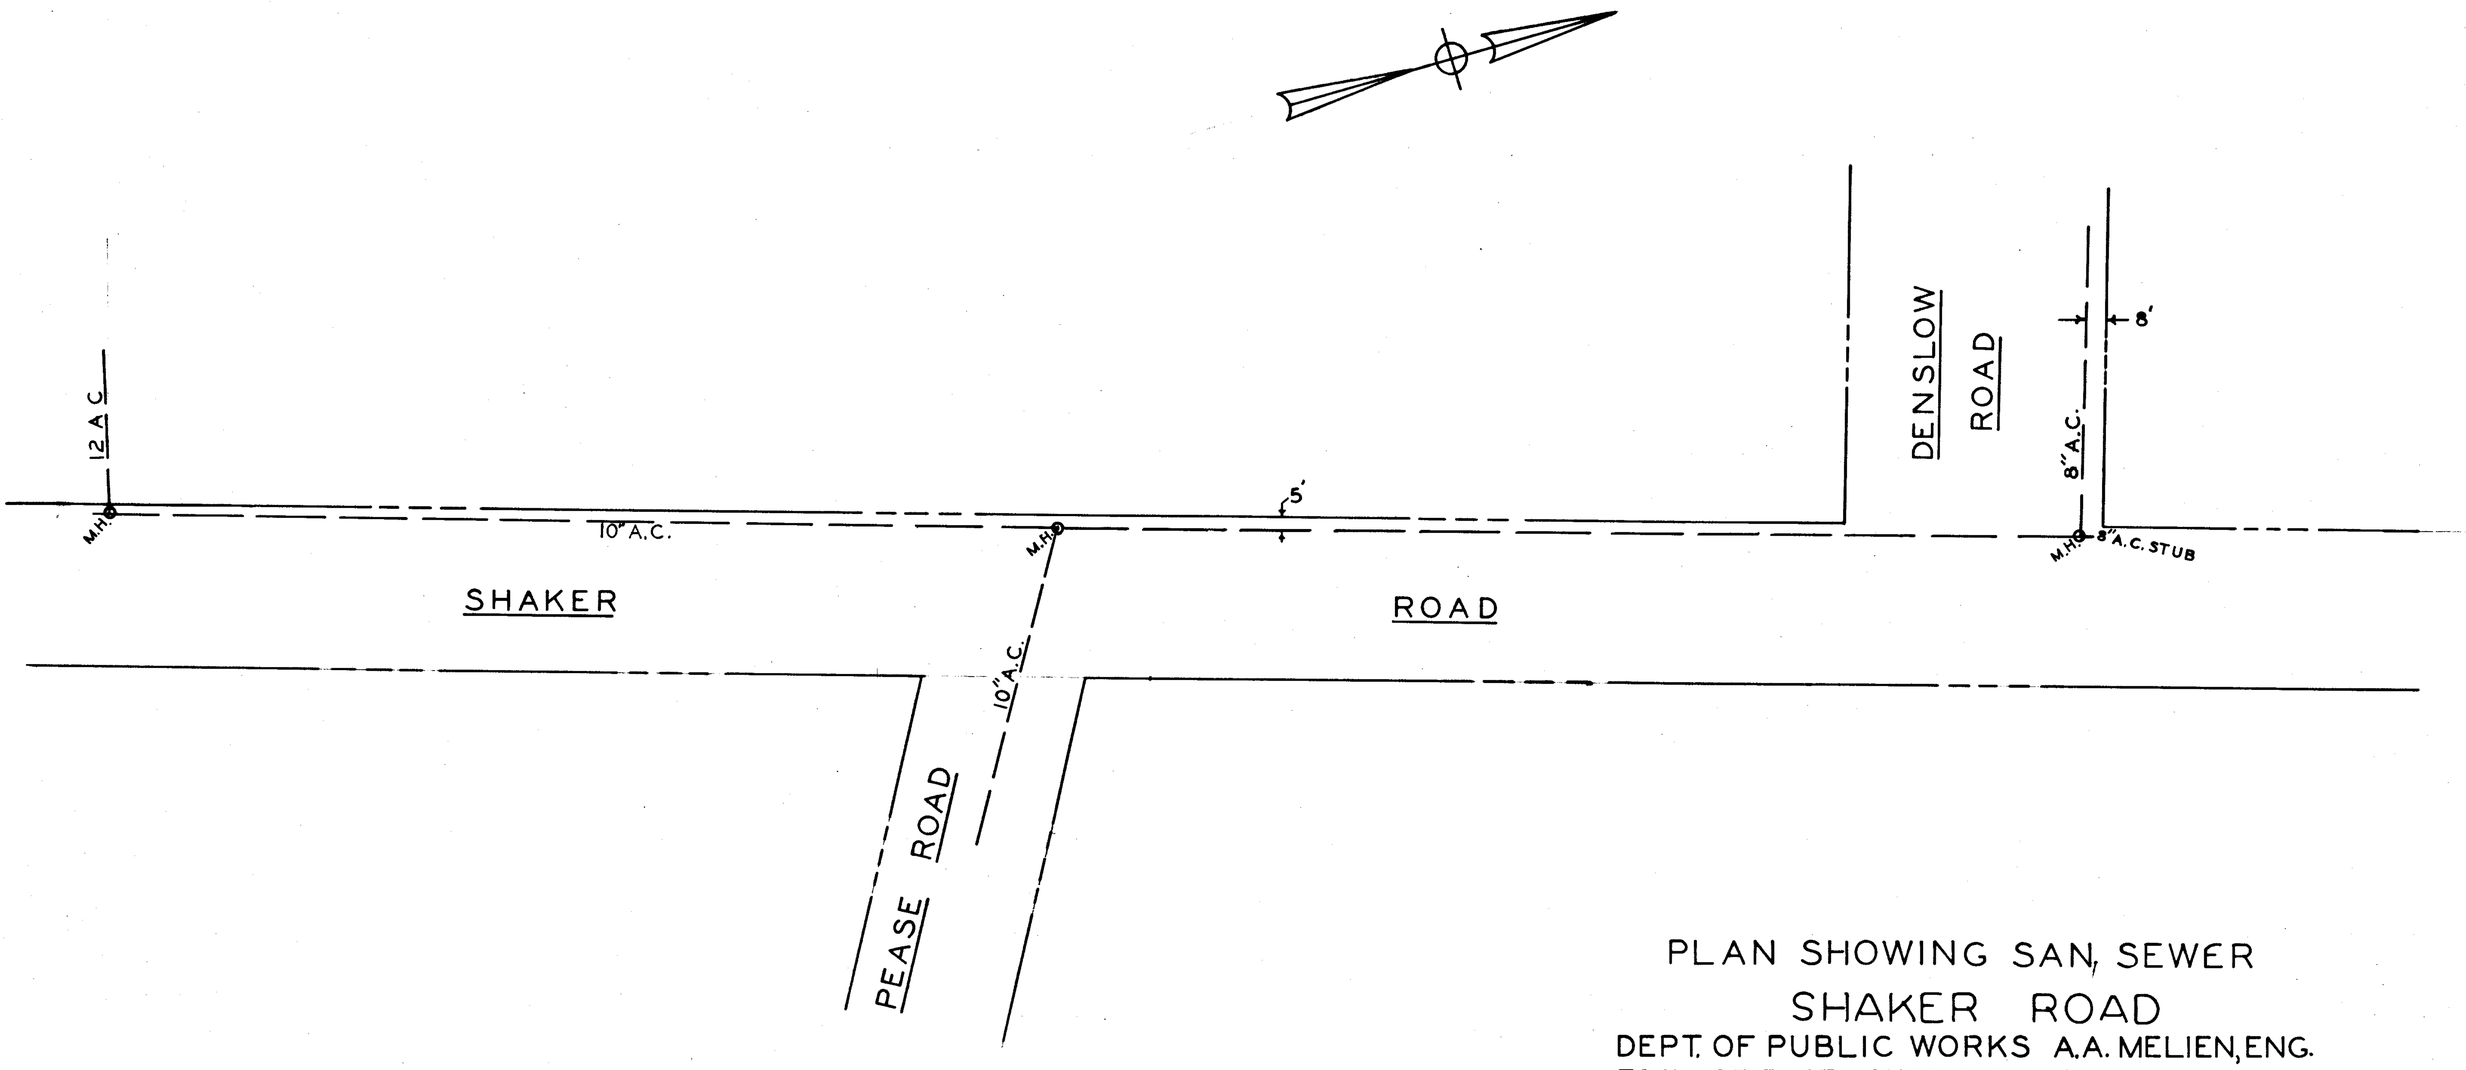
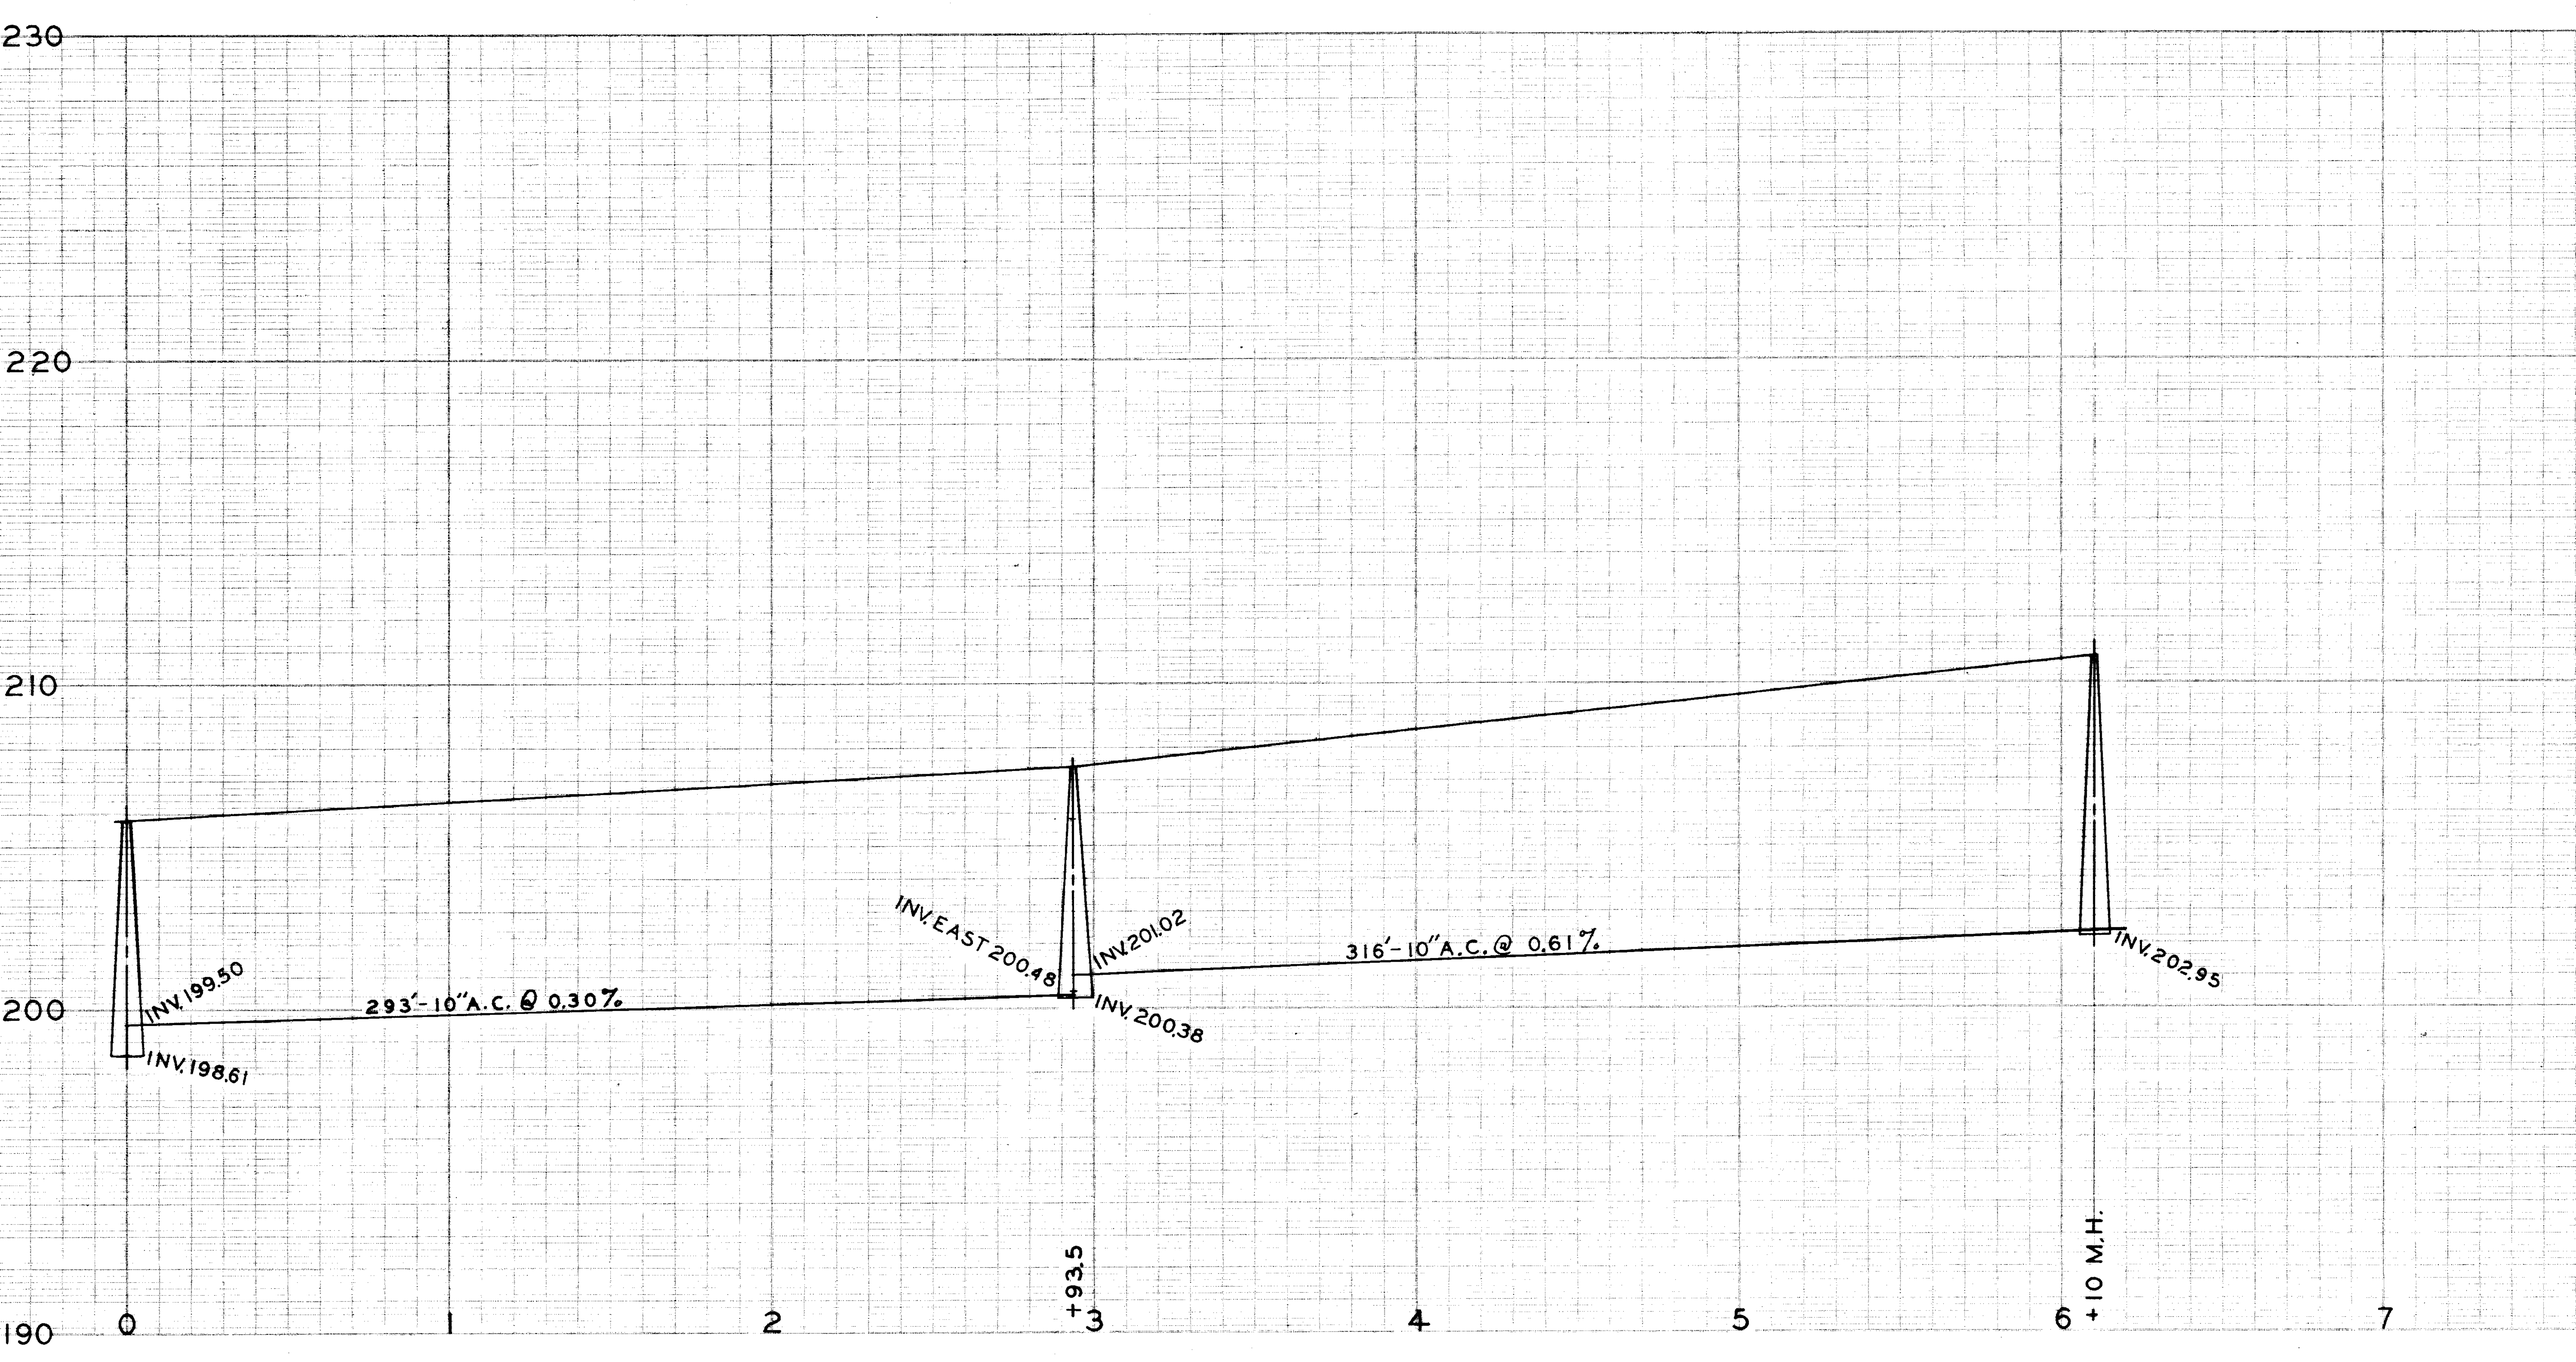
PLAN SHOWING SAN, SEWER
SHAKER ROAD
DEPT. OF PUBLIC WORKS A.A. MELIEN, ENG.
TOWN OF EAST LONGMEADOW, MASS.
SCALE: 1" = 40' HORIZ., 1" = 4' VERT. FEB. 1963