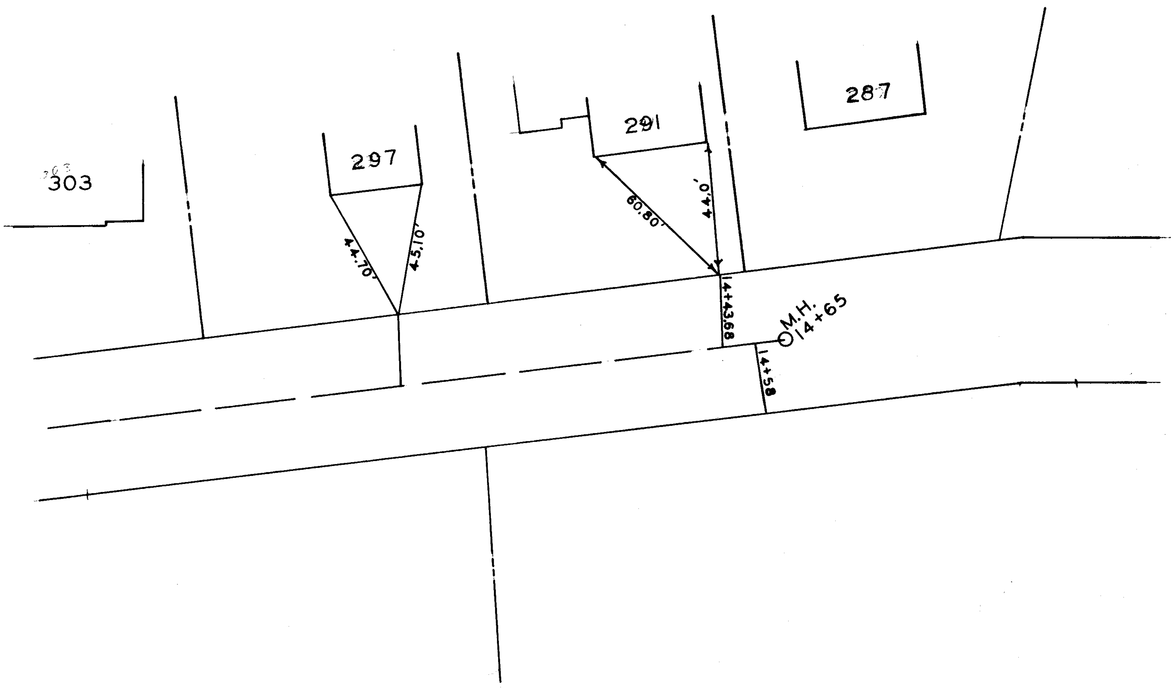
303
297
291
287
44.70'
45.10'
60.50'
44.0'
14+43.68
M.H.
14+65
14+58

KIBBE ROAD
SCALE: 1" = 40' HORIZ.
1" = 4' VERT.
SHEET II OF II
310
300
290
280
270
297#
291#
287#
SILL
303'-8" A.C. @ 0.40%
INV. 288.17
12
13
14
15

SS 203