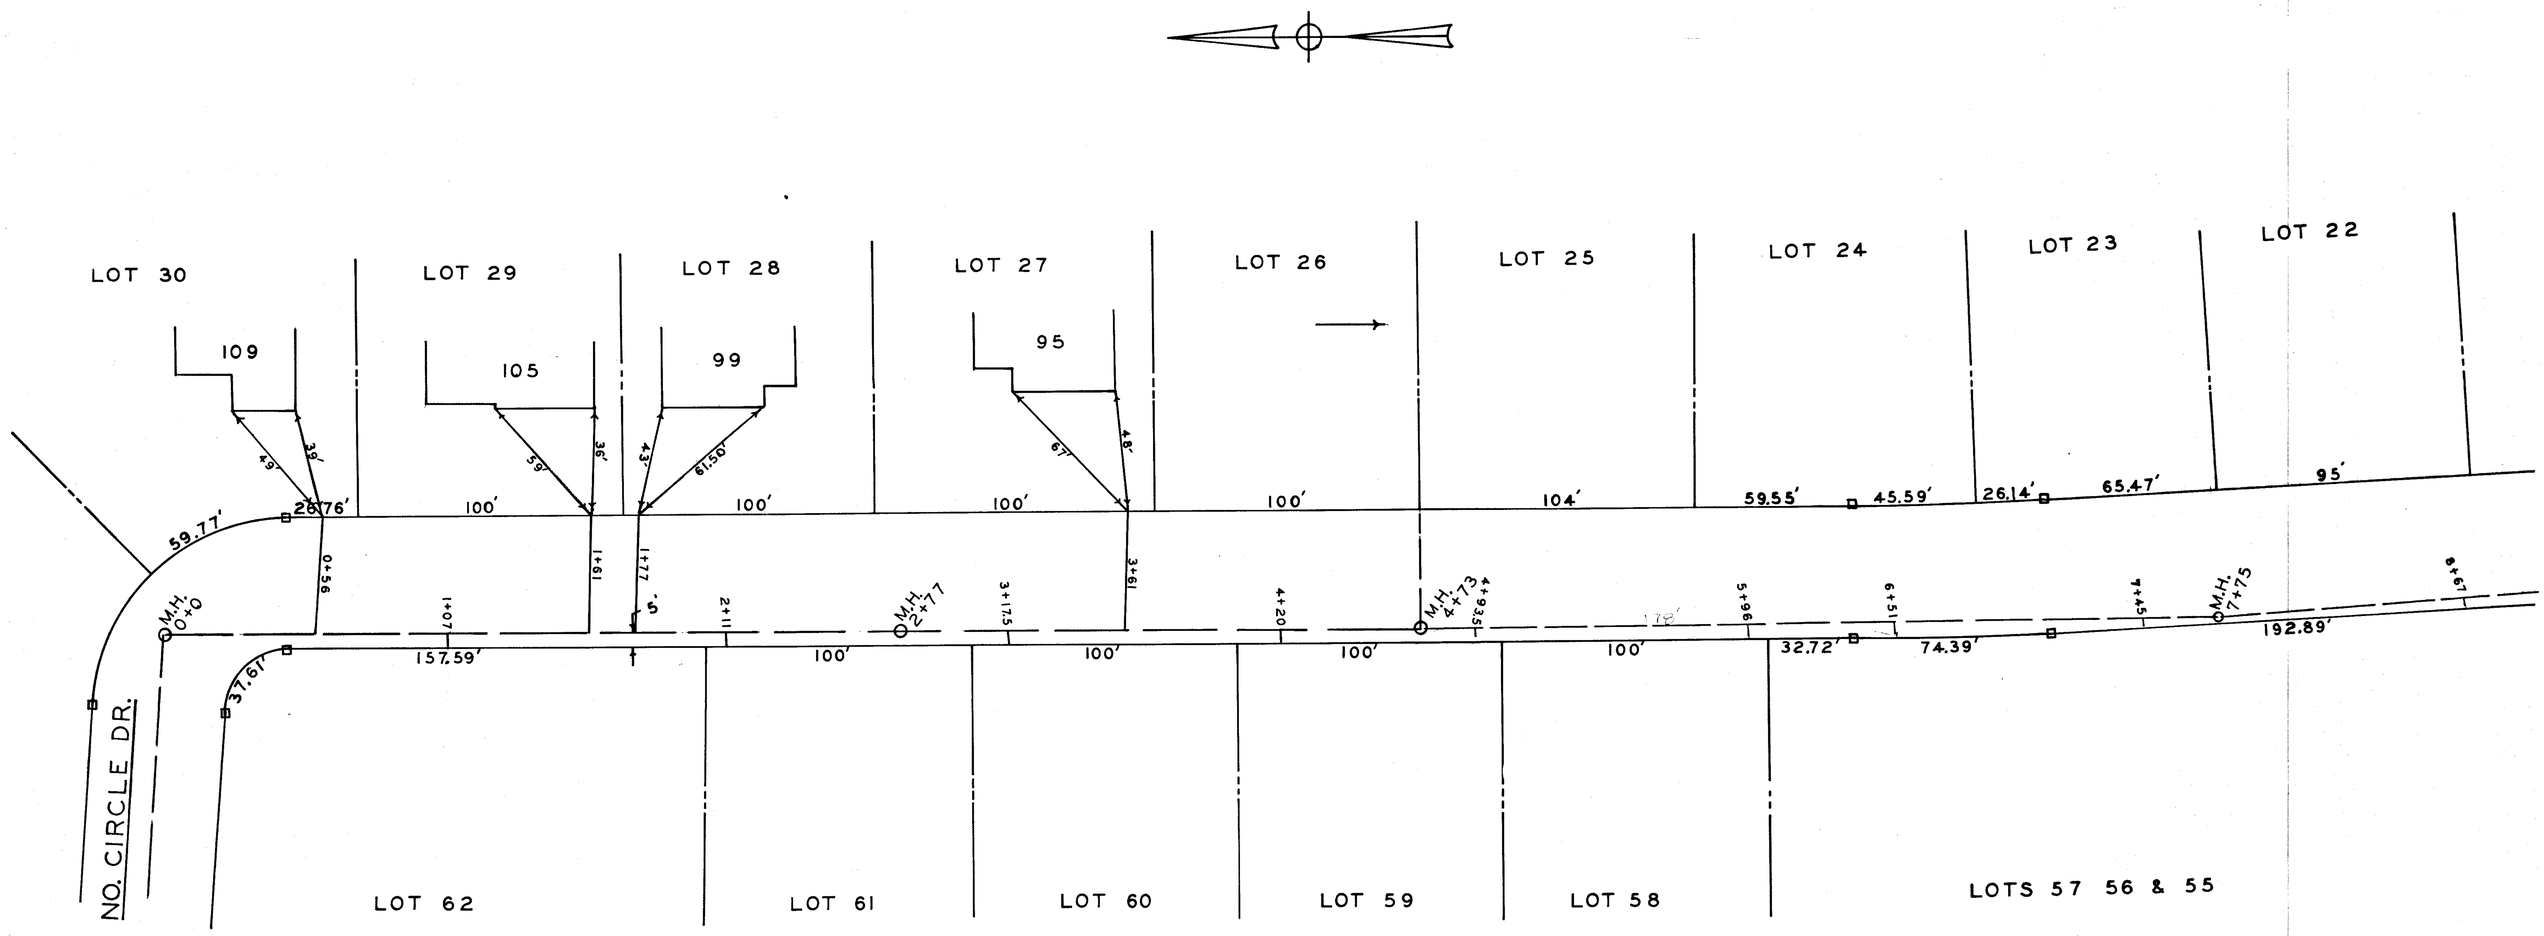

PLAN SHOWING SANITARY SEWER

EAST CIRCLE DRIVE (TREE BELT)

DEPT. OF PUBLIC WORKS — A. A. MELIEN, ENG.

TOWN OF EAST LONGMEADOW, MASSACHUSETTS

SCALE: 1"=40' HORIZ., 1"=4' VERT. — SEPT, 1963

SHEET I OF II

SCALE: 1"=40' HORIZ., 1"=4' VERT. SEPT, 1963 SHEET I OF II

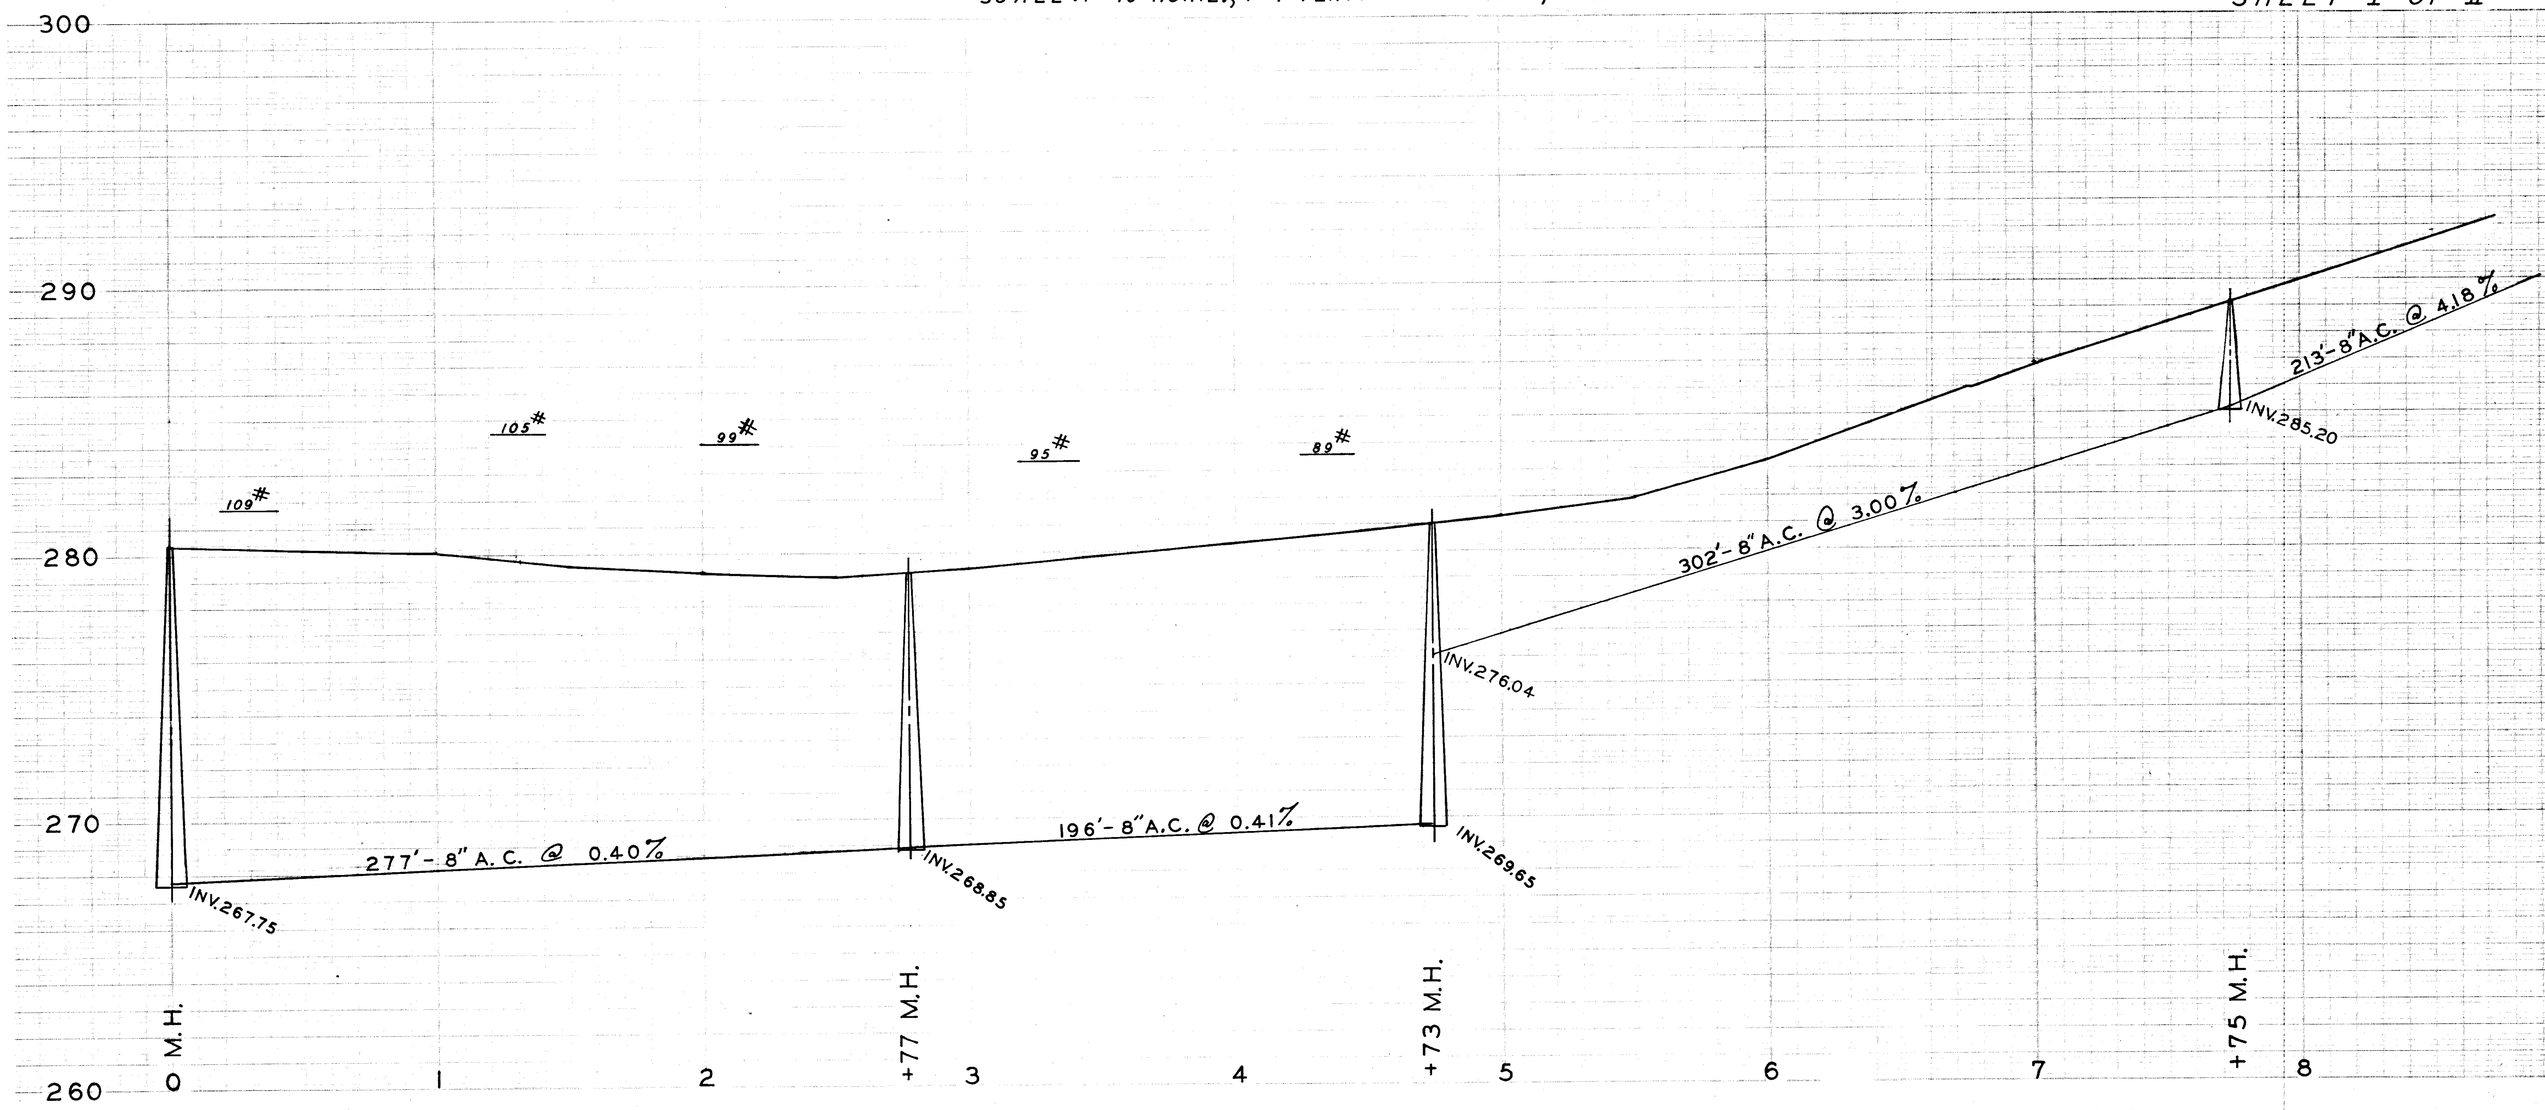

S.S. 207