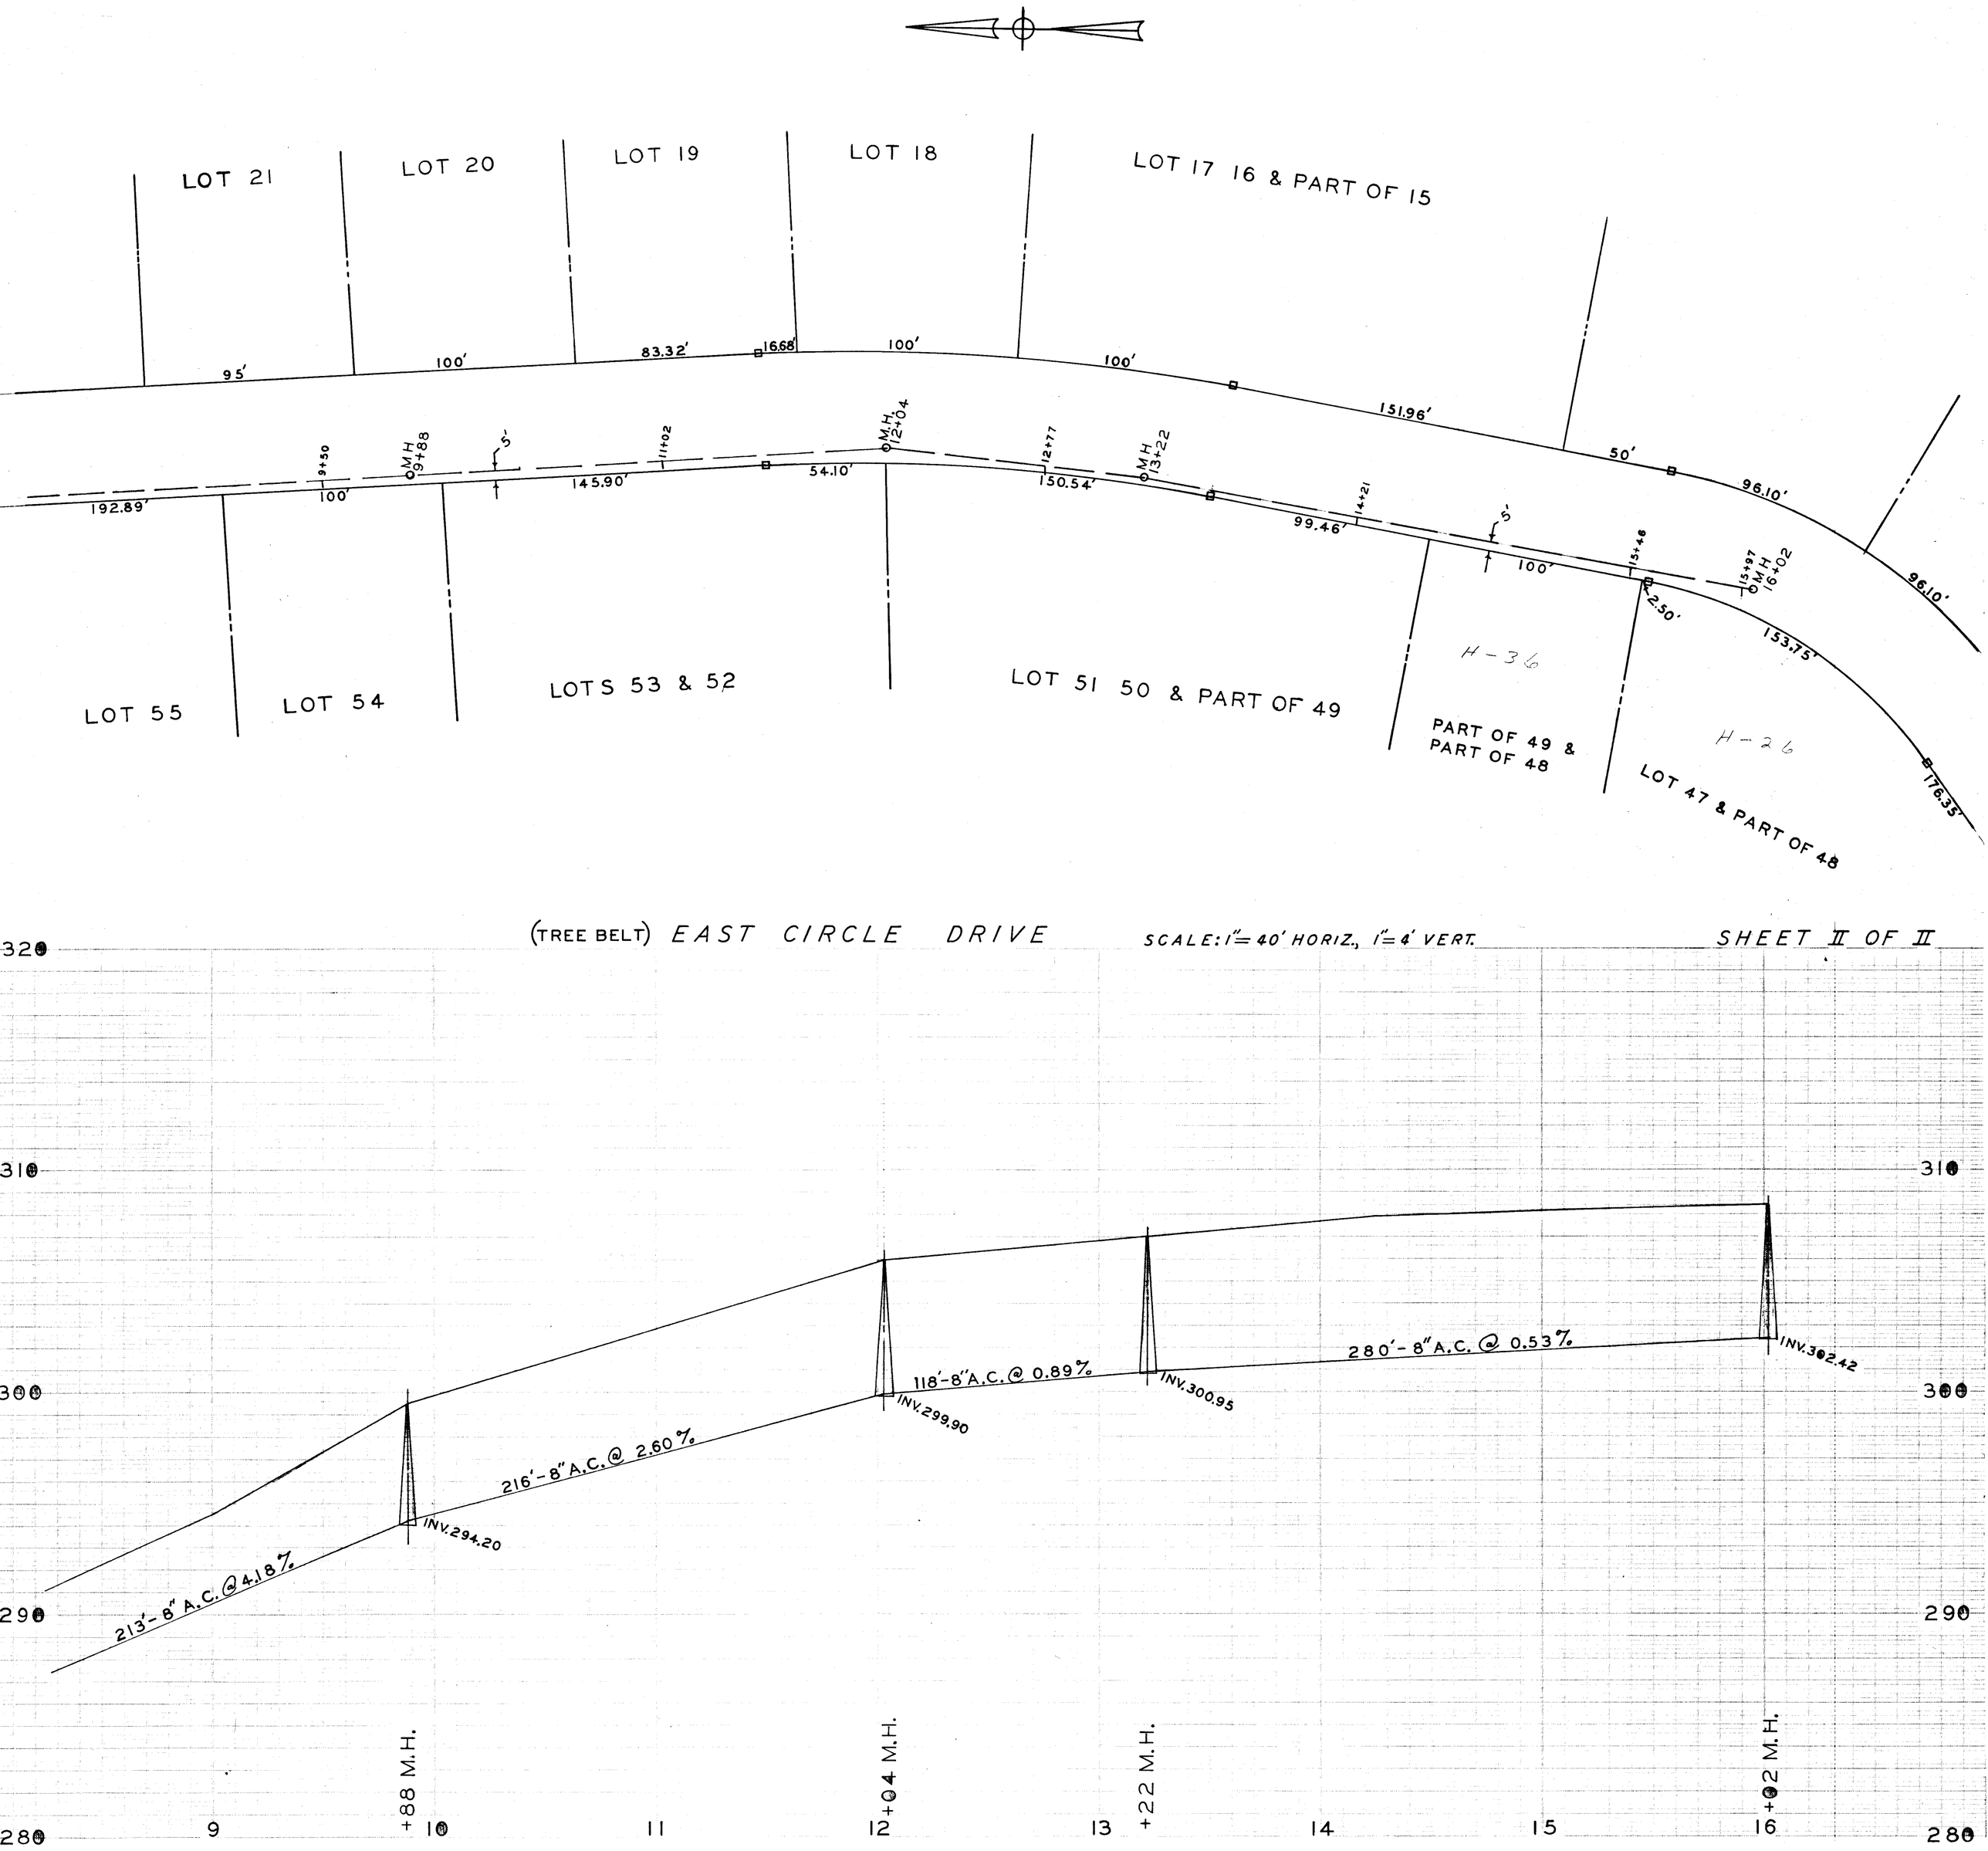
LOT 21
LOT 20
LOT 19
LOT 18
LOT 17 16 & PART OF 15
95'
100'
83.32'
16.68'
100'
100'
151.96'
50'
96.10'
96.10'
153.75'
176.35'
192.89'
100'
9+50
M.H. 9+88
5'
145.90'
11+02
54.10'
M.H. 12+04
12+77
150.54'
M.H. 13+22
99.46'
14+21
5'
100'
15+46
2.50'
15+97
M.H. 16+02
LOT 55
LOT 54
LOTS 53 & 52
LOT 51 50 & PART OF 49
H-36
PART OF 49 & PART OF 48
H-26
LOT 47 & PART OF 48
(TREE BELT) EAST CIRCLE DRIVE
SCALE: 1" = 40' HORIZ., 1" = 4' VERT.
SHEET II OF II
320
310
300
290
280
213'-8" A.C. @ 4.18%
INV. 294.20
216'-8" A.C. @ 2.60%
INV. 299.90
118'-8" A.C. @ 0.89%
INV. 300.95
280'-8" A.C. @ 0.53%
INV. 302.42
9
+88 M.H.
10
11
12
+04 M.H.
13
+22 M.H.
14
15
16
+02 M.H.

S.S. 208