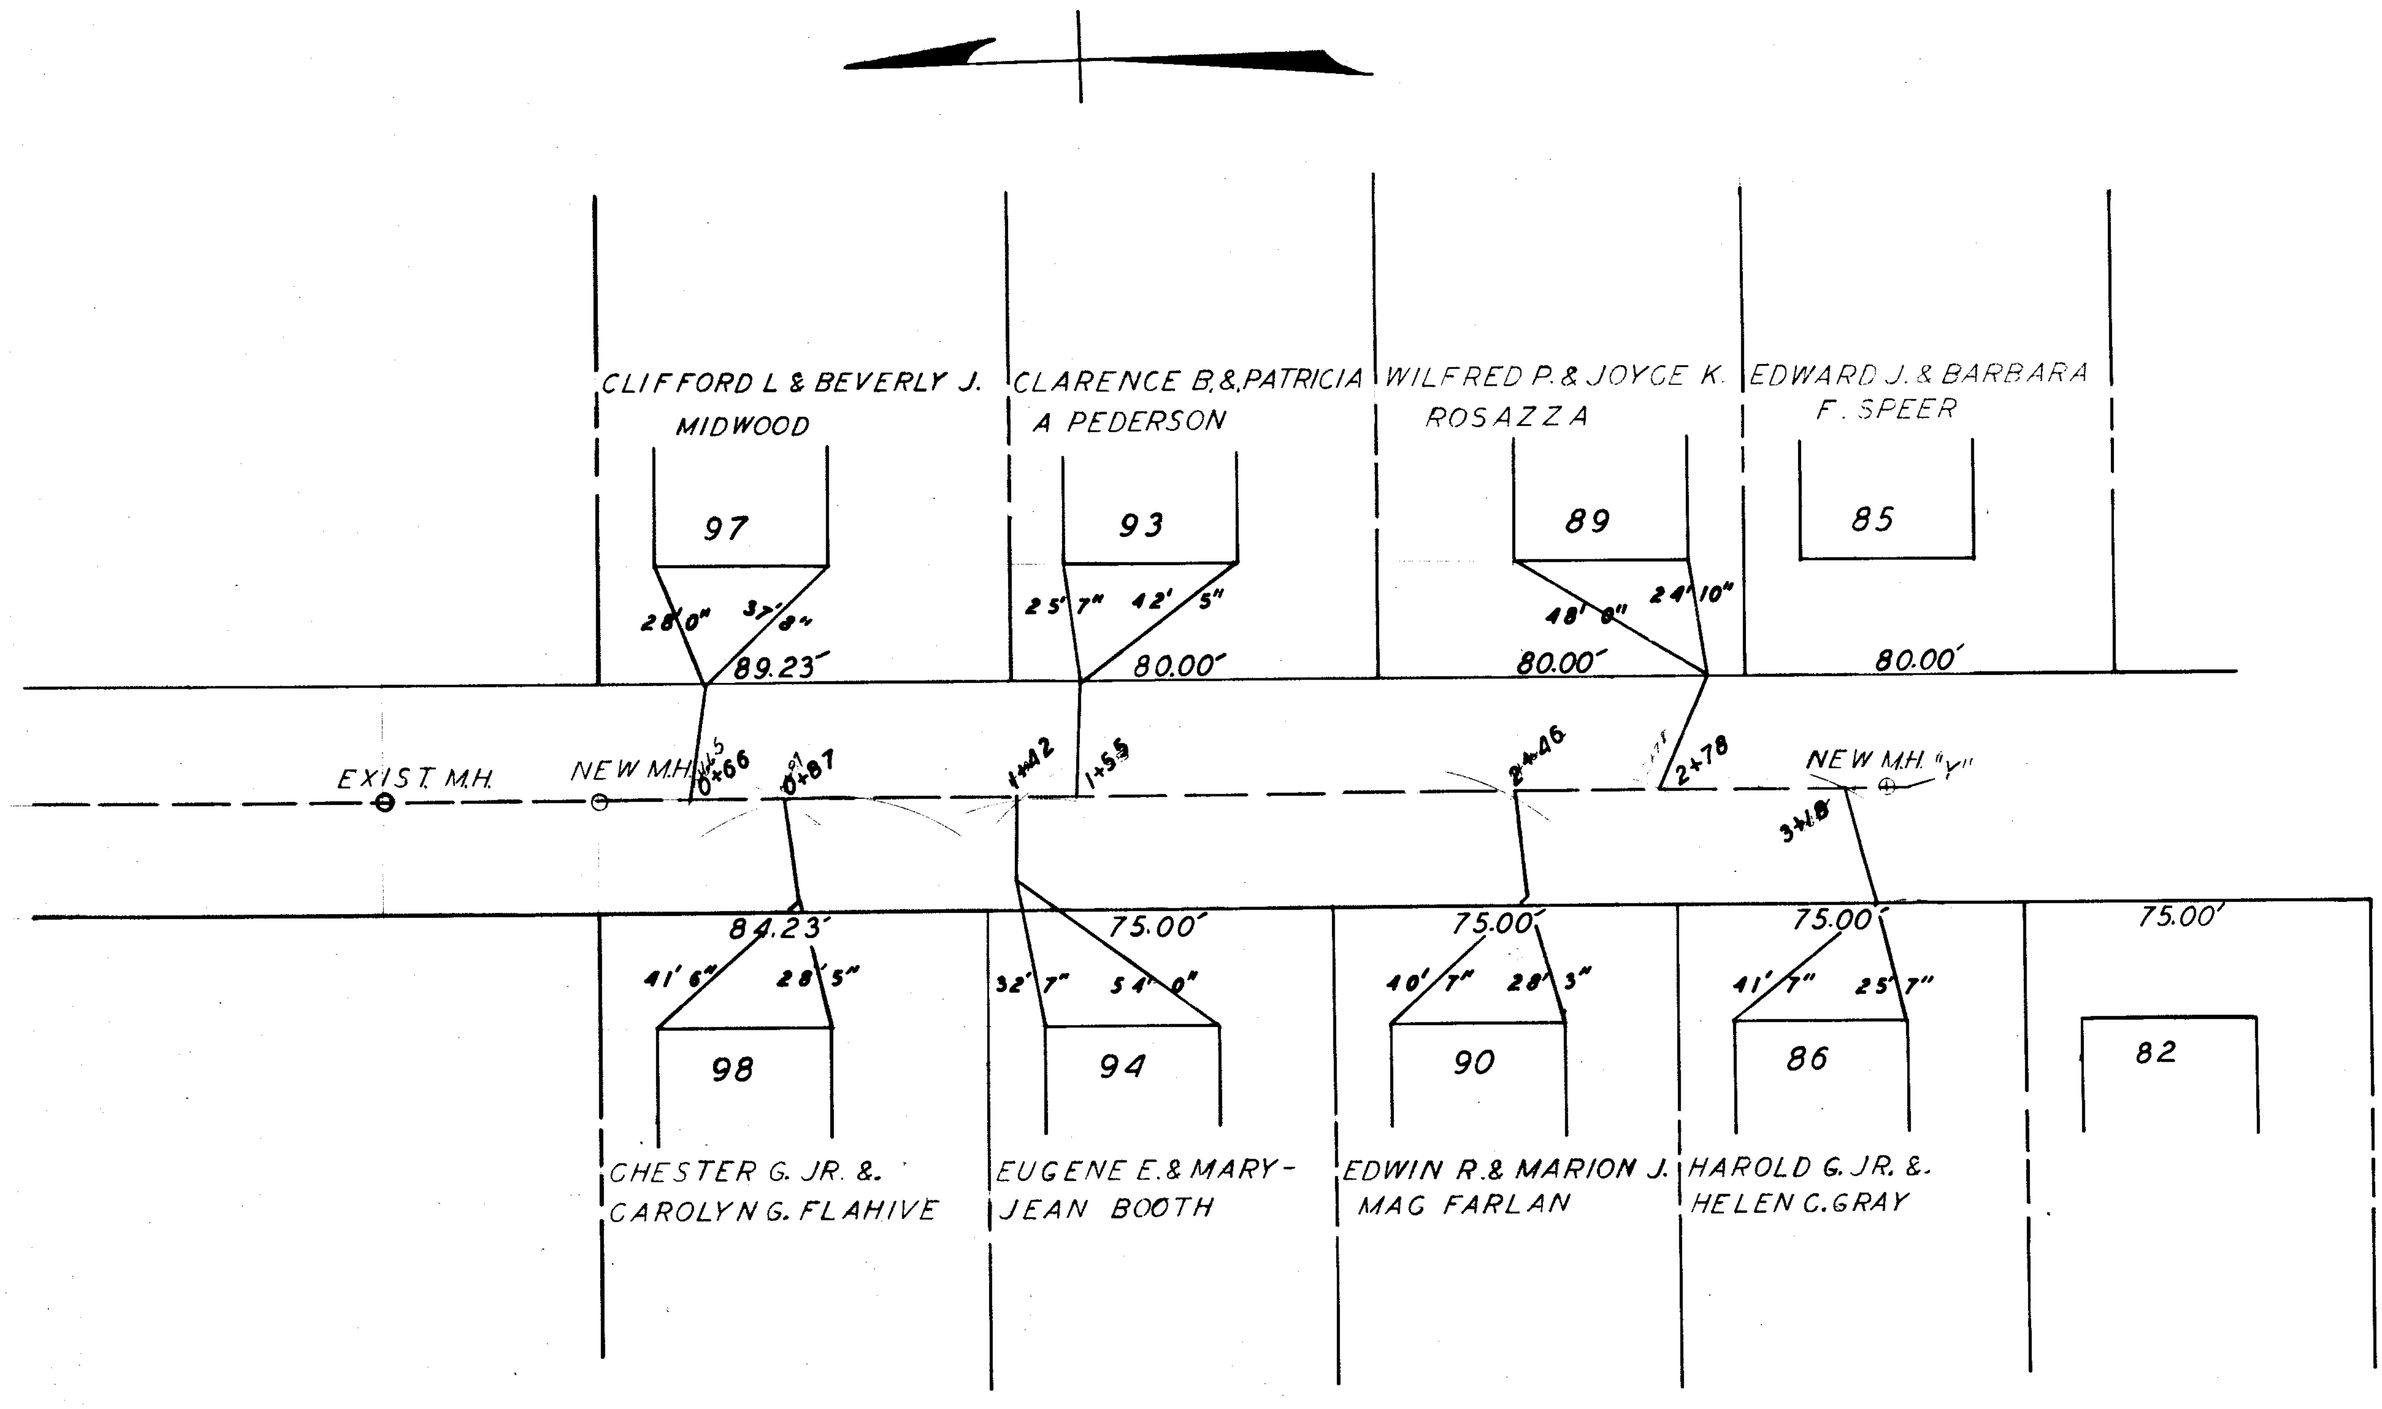

PLAN SHOWING SANITARY SEWER
BAYNE STREET

DEPT OF PUBLIC WORKS
TOWN OF EAST LONGMEADOW
SCALE: 1" = 40', HORZ.: 1" = 4' VERT.
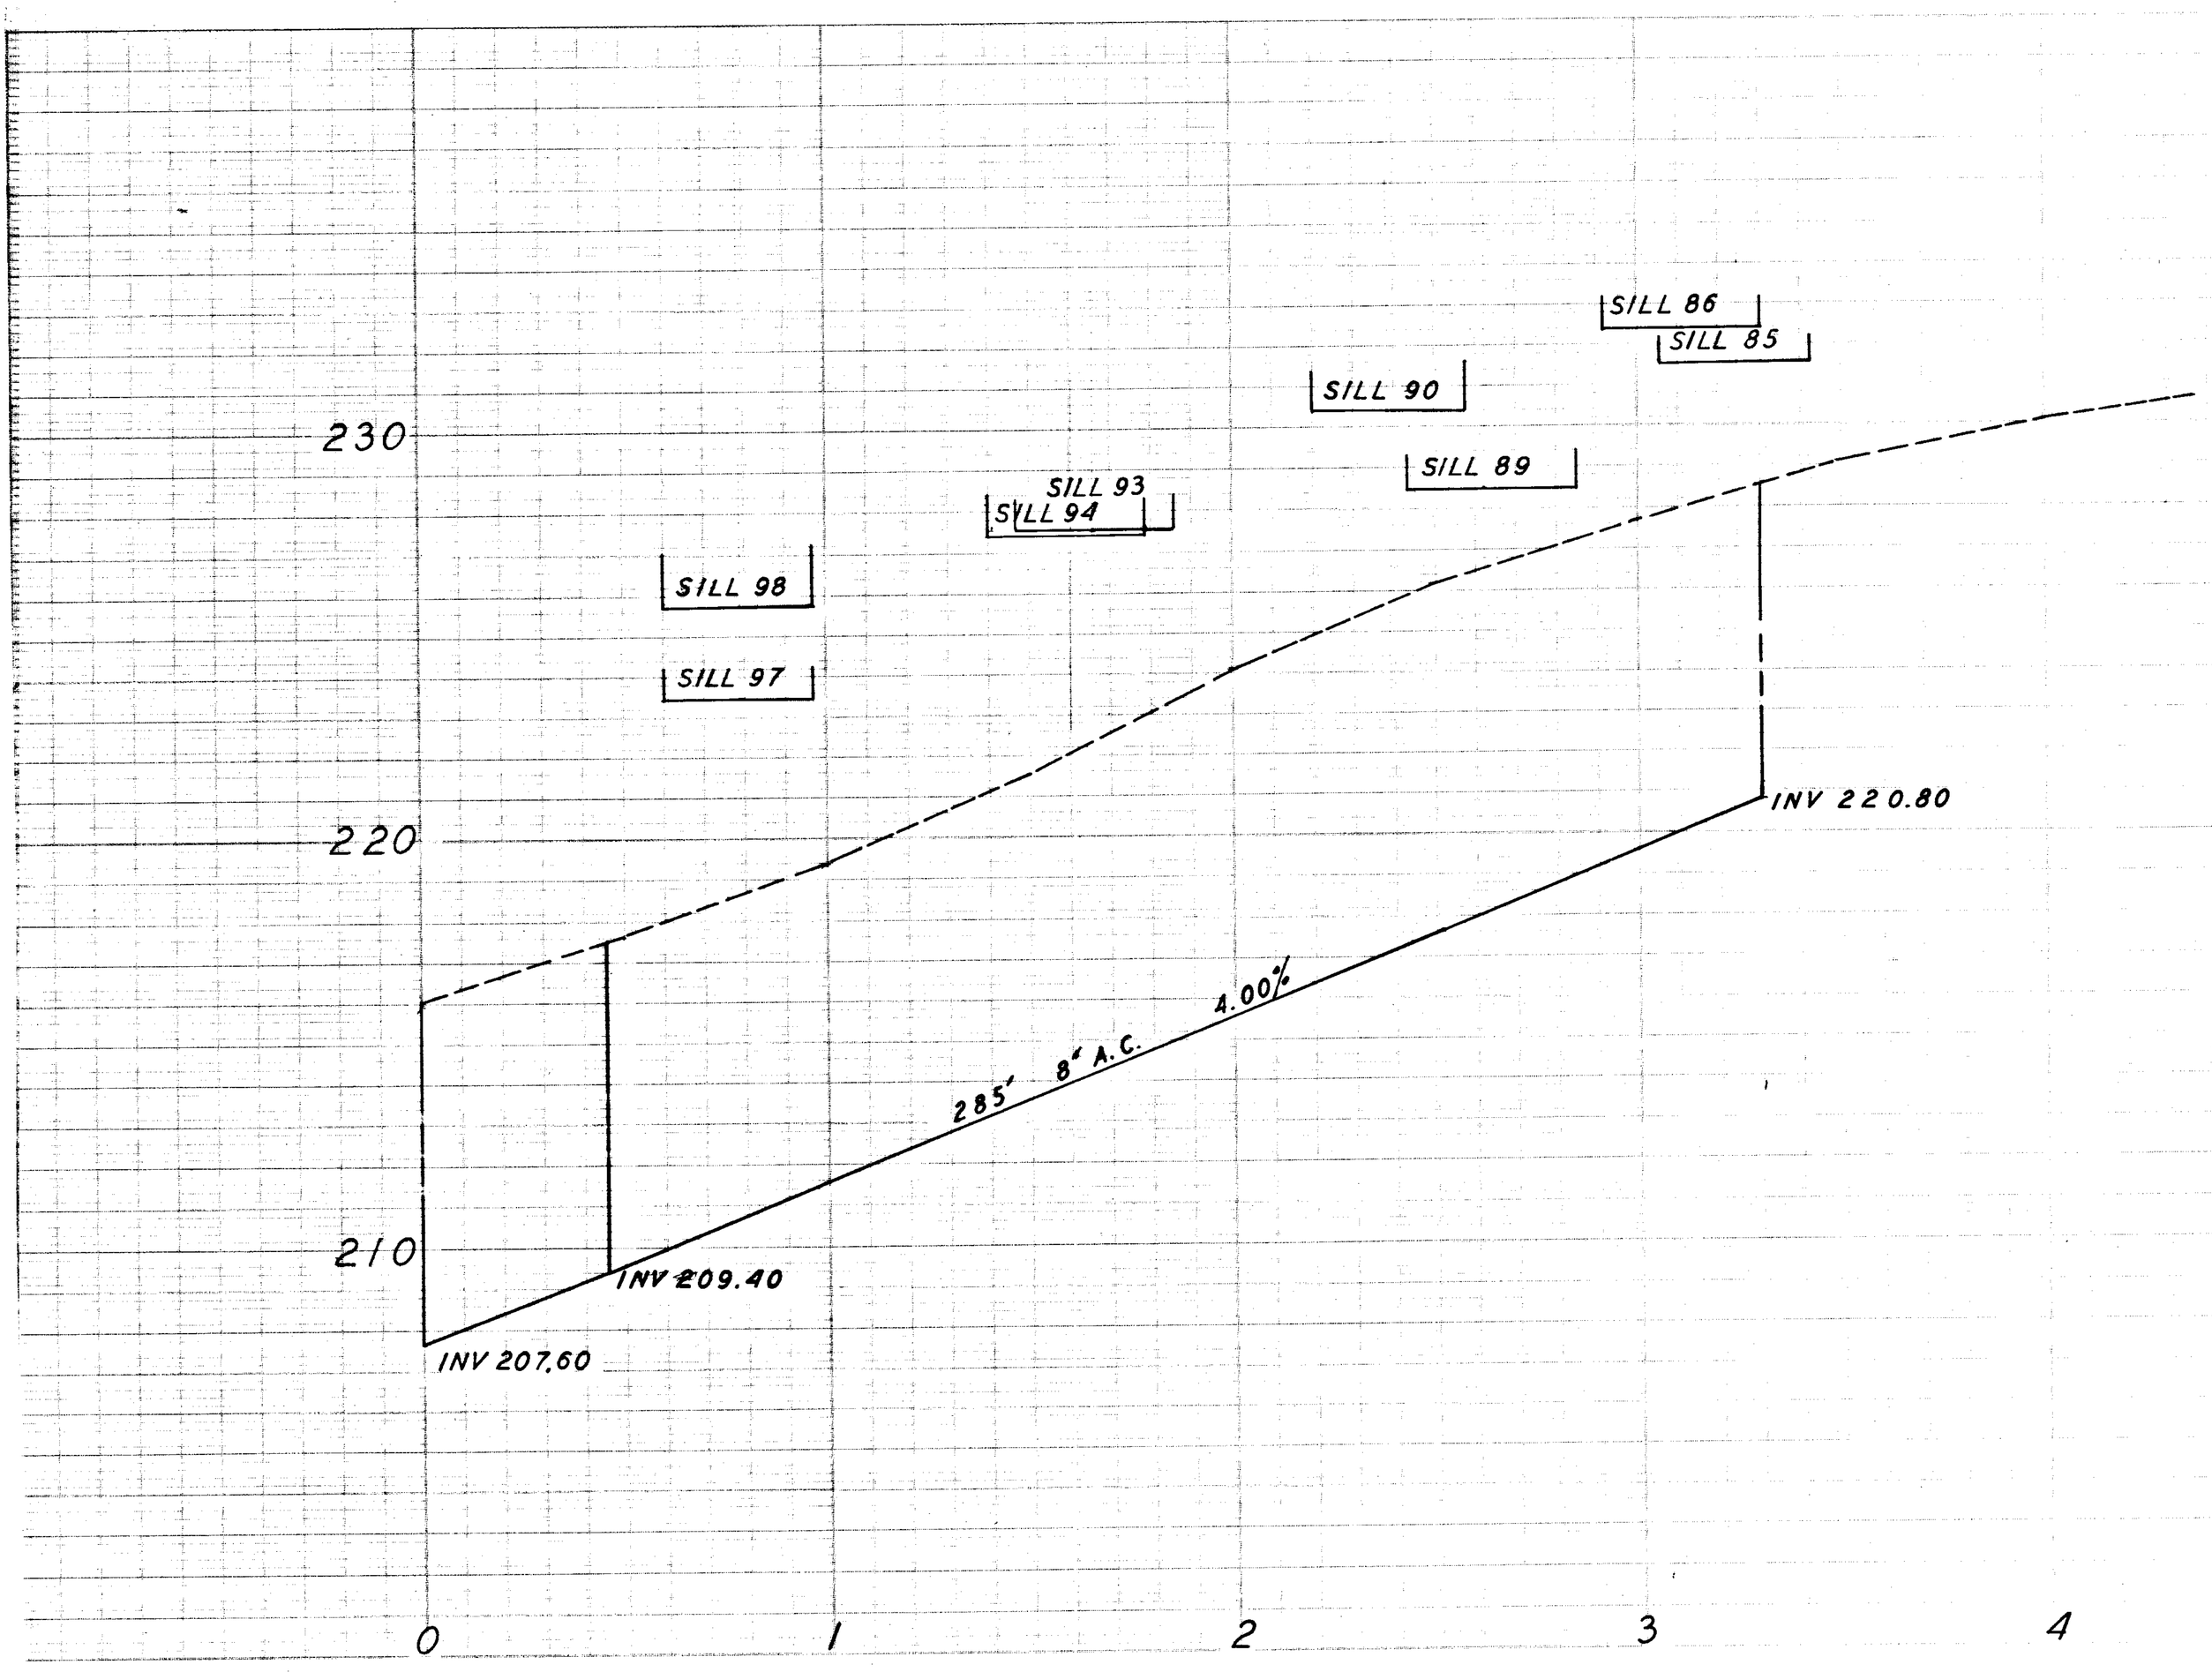
A. A. MELIEN ENG
MASSACHUSTTS
DEC., 1963