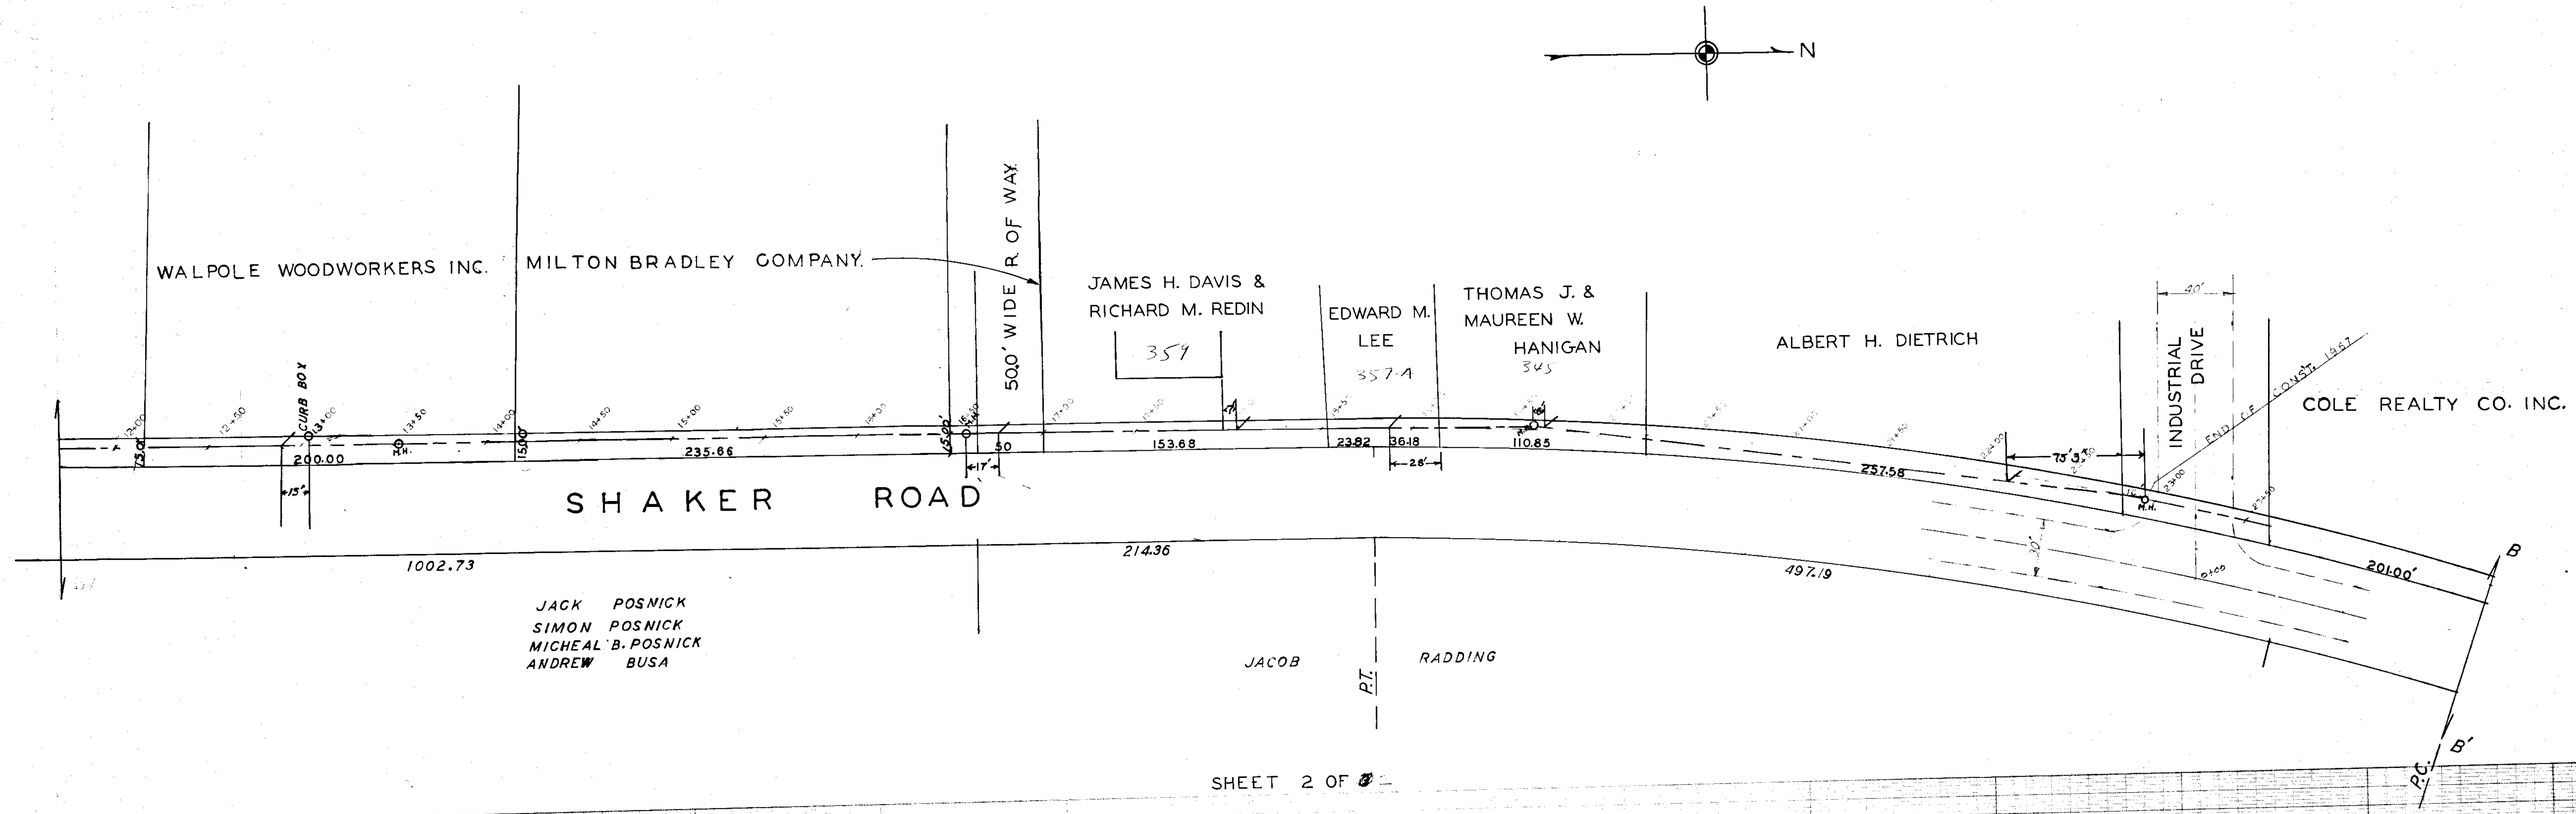
N
WALPOLE WOODWORKERS INC.
MILTON BRADLEY COMPANY
50.0' WIDER OF WAY
JAMES H. DAVIS &
RICHARD M. REDIN
359
EDWARD M.
LEE
357-A
THOMAS J. &
MAUREEN W.
HANIGAN
343
ALBERT H. DIETRICH
INDUSTRIAL
DRIVE
COLE REALTY CO. INC.
CURB BOX
200.00
235.66
153.68
23.82
36.18
110.85
257.58
75.3
1002.73
214.36
497.19
201.00'
SHAKER ROAD
JACK POSNICK
SIMON POSNICK
MICHEAL B. POSNICK
ANDREW BUSA
JACOB
RADDING
P.T.
P.C.
B
B'

SHEET 2 OF 2

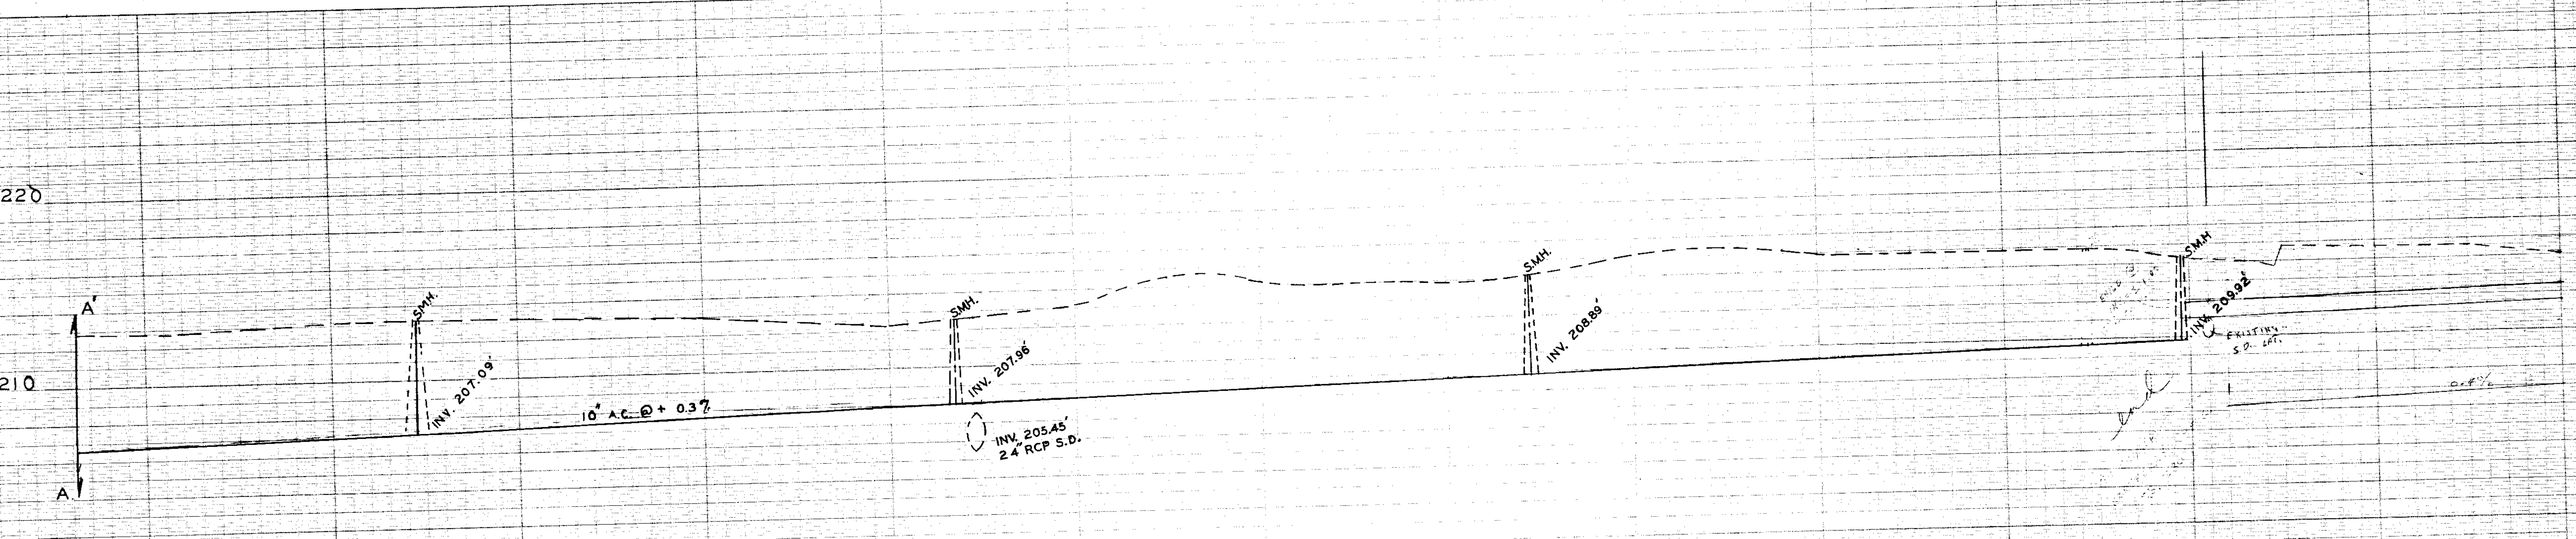
220
210
A'
A
S.M.H.
INV. 207.09'
10" A.C. @ + 0.3%
INV. 207.96'
INV. 205.45'
24" RCP S.D.
INV. 208.89'
INV. 209.92'
EXISTING
S.D. LAT.
0.4%