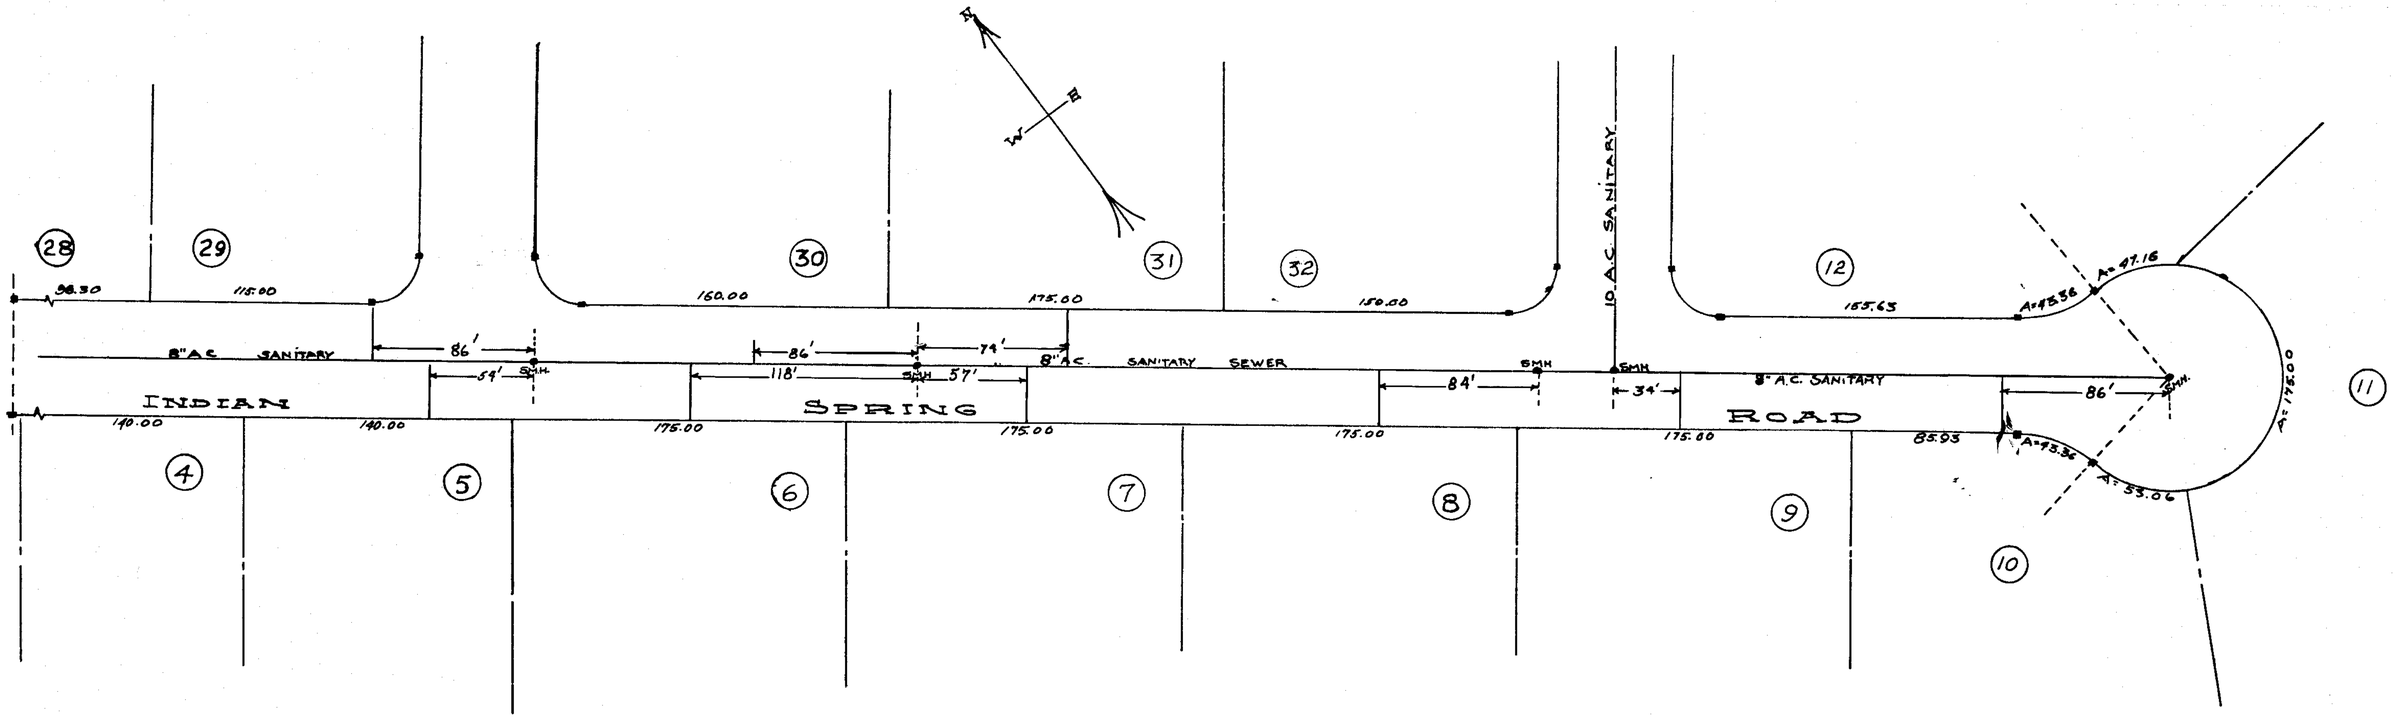

TRACED FROM W-283

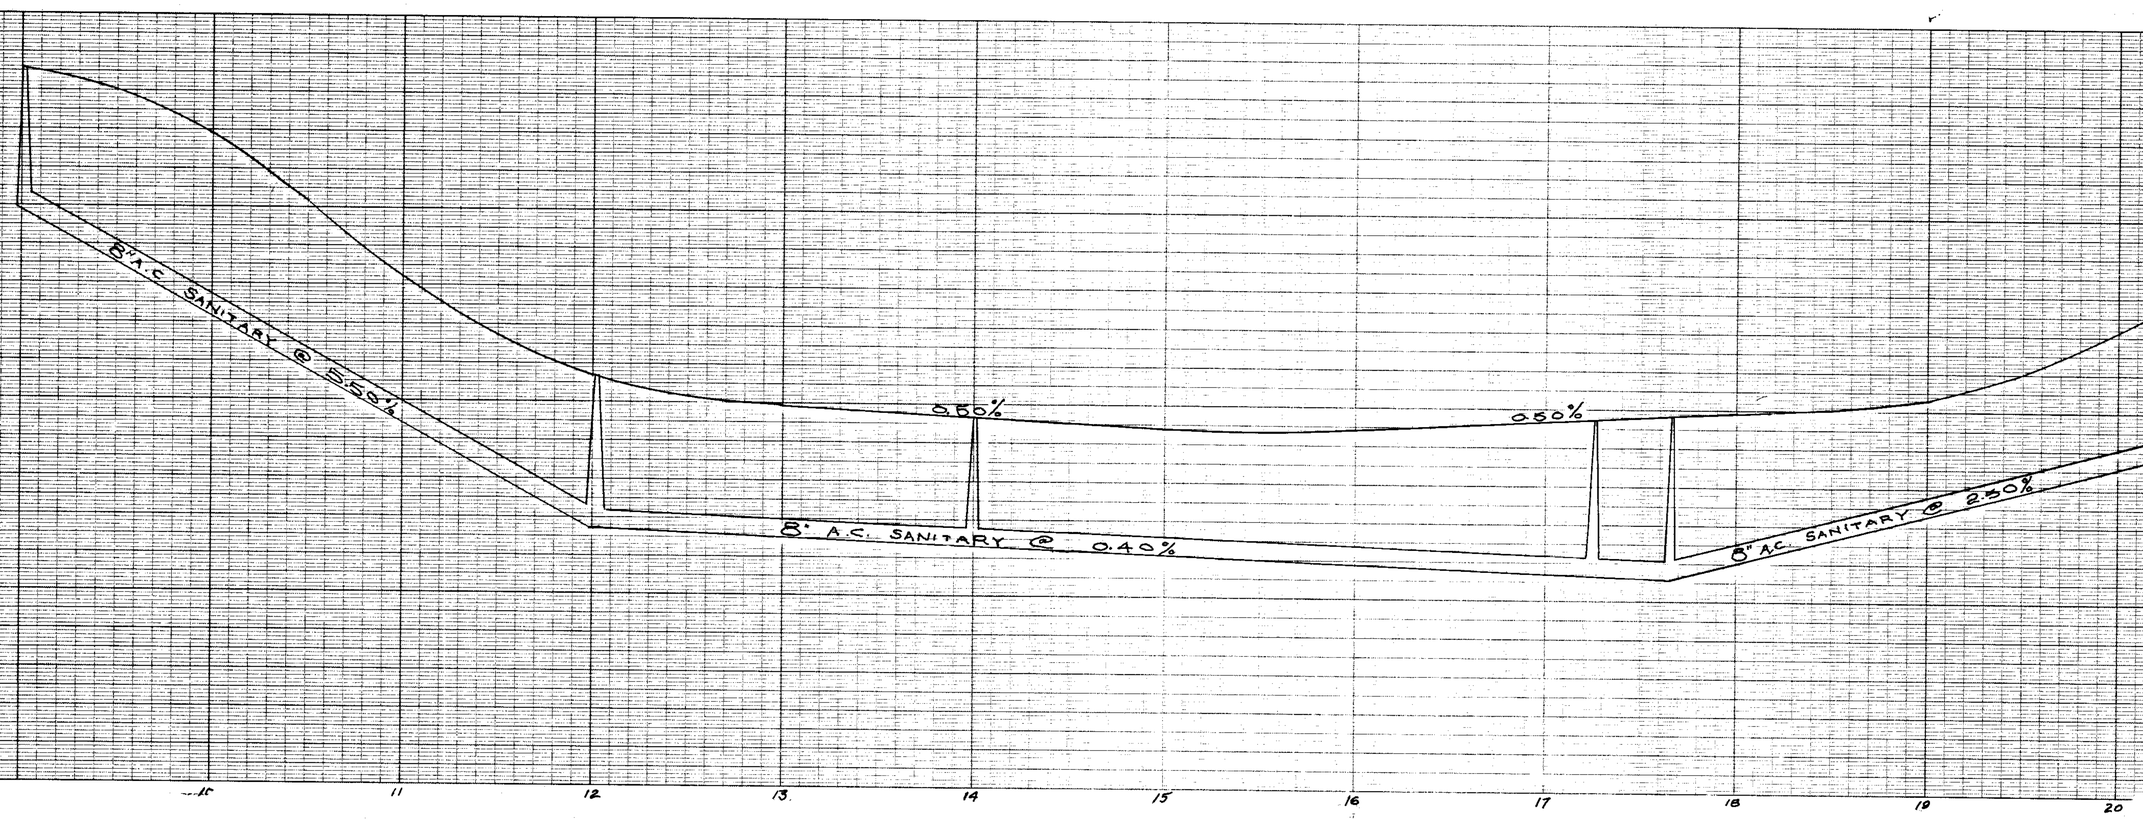

PLAN SHOWING SANITARY SEW
INDIAN SPRING ROAD
DEPT. OF PUBLIC WORKS A.A.MEL
TOWN OF EAST LONGMEADOW,
SCALE: HOR. = 1" = 40'
VER. = 1" = 40'
MA

SS 2215