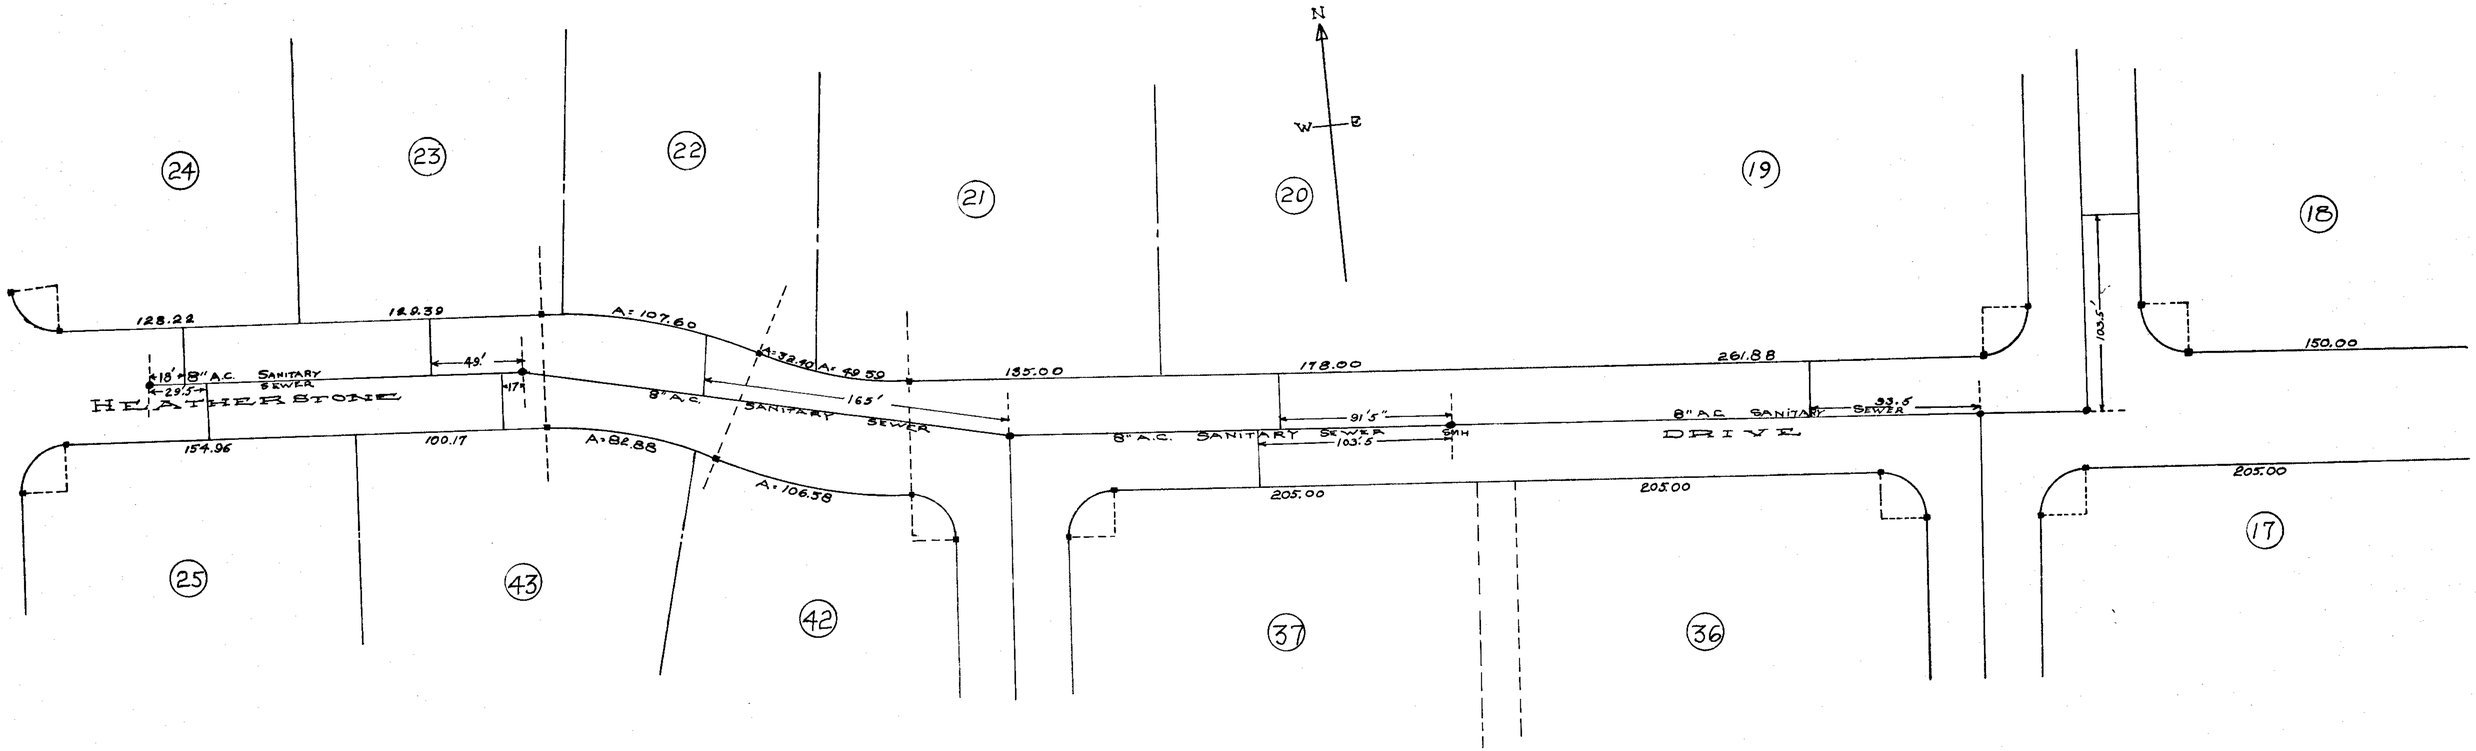

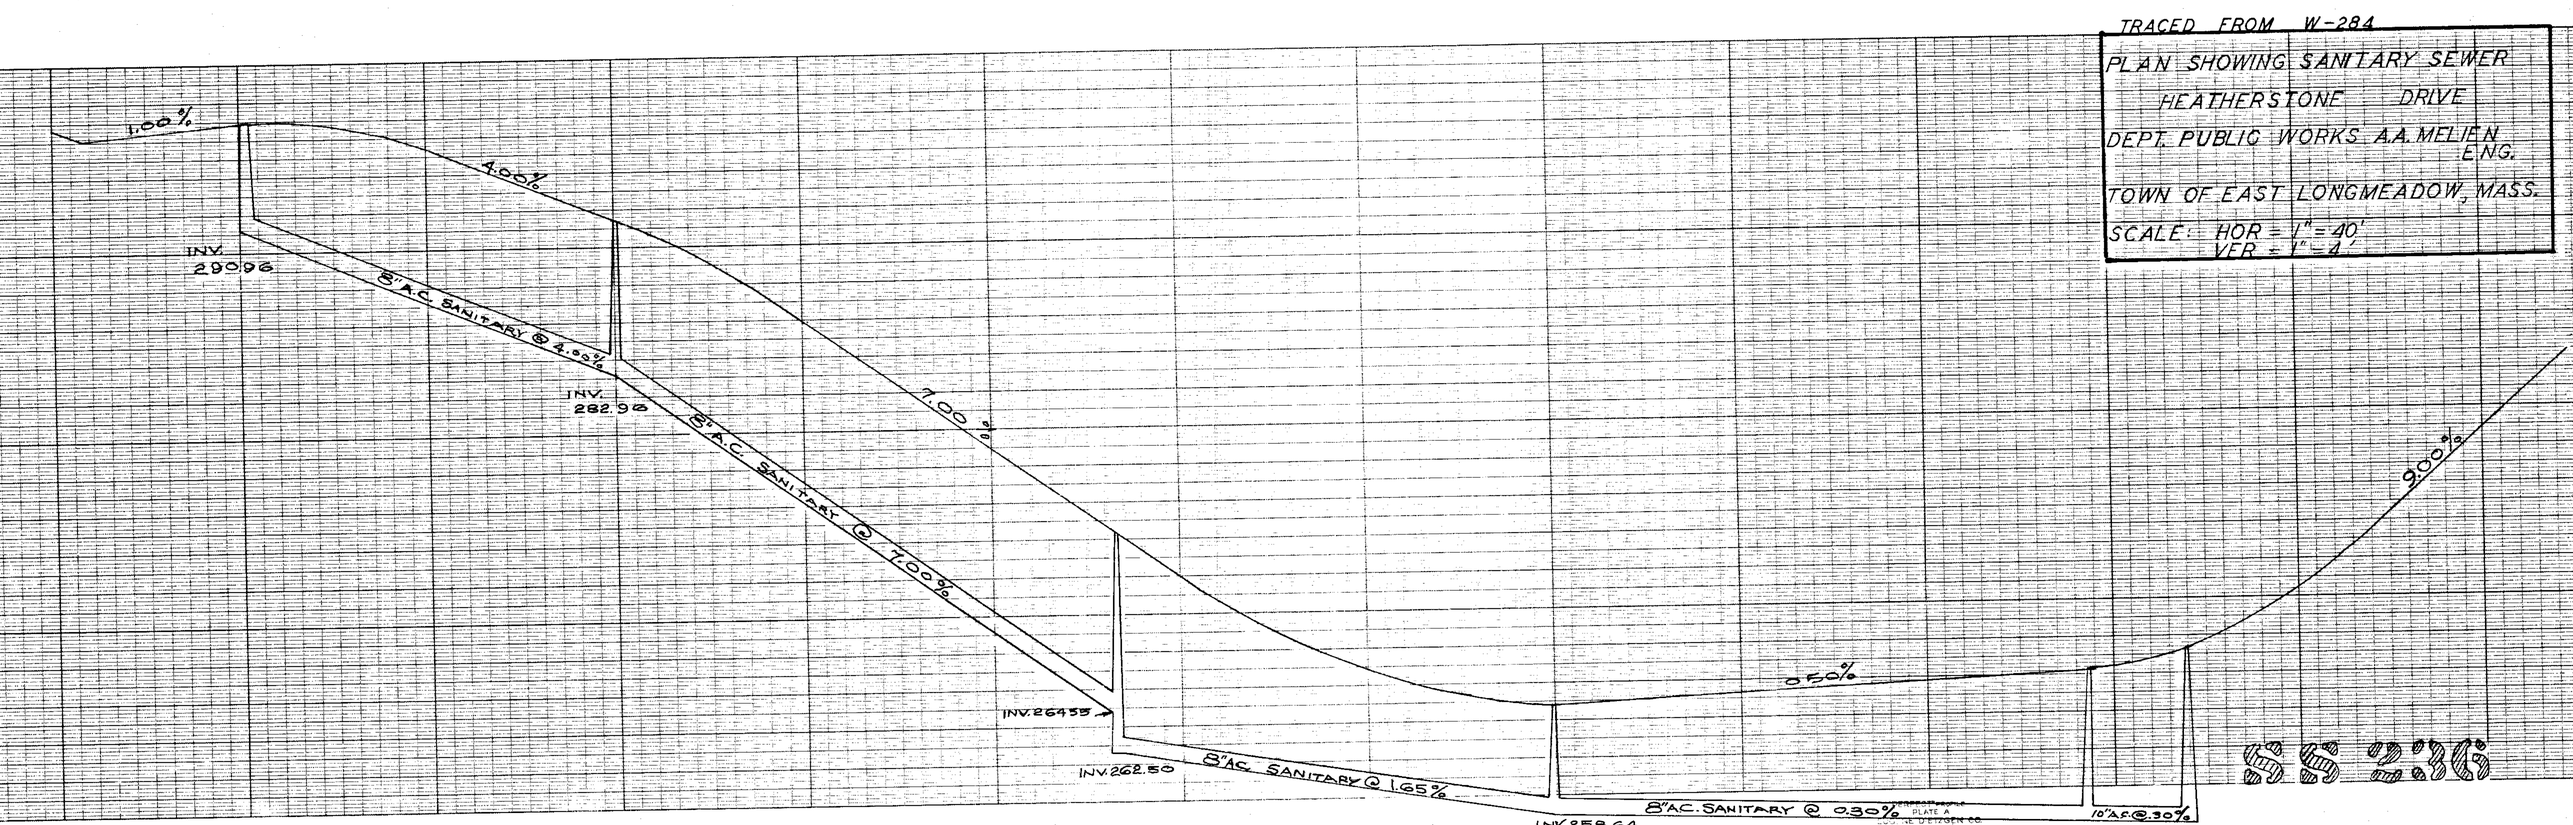

TRACED FROM W-284

PLAN SHOWING SANITARY SEWER

HEATHERSTONE DRIVE

DEPT. PUBLIC WORKS A.A. MELIEN ENG.

TOWN OF EAST LONGMEADOW, MASS.

SCALE: HOR = 1" = 40'
VER = 1" = 4'

PLATE A

65 236